


# CITY OF SUPERIOR SEWER PLAN

Contract let April 1, 1890  
completed April 28, 1891  
Kirkland & Starkey, Contractor  
James Nelson, J. H. Little, I. C. Grant and  
W. R. Russell, Inspectors  
E. B. Banks, City Engineer



Scale { Horizontal 1 inch = 60 ft.  
Vertical 1" = 4'  
Section 1" = 2'

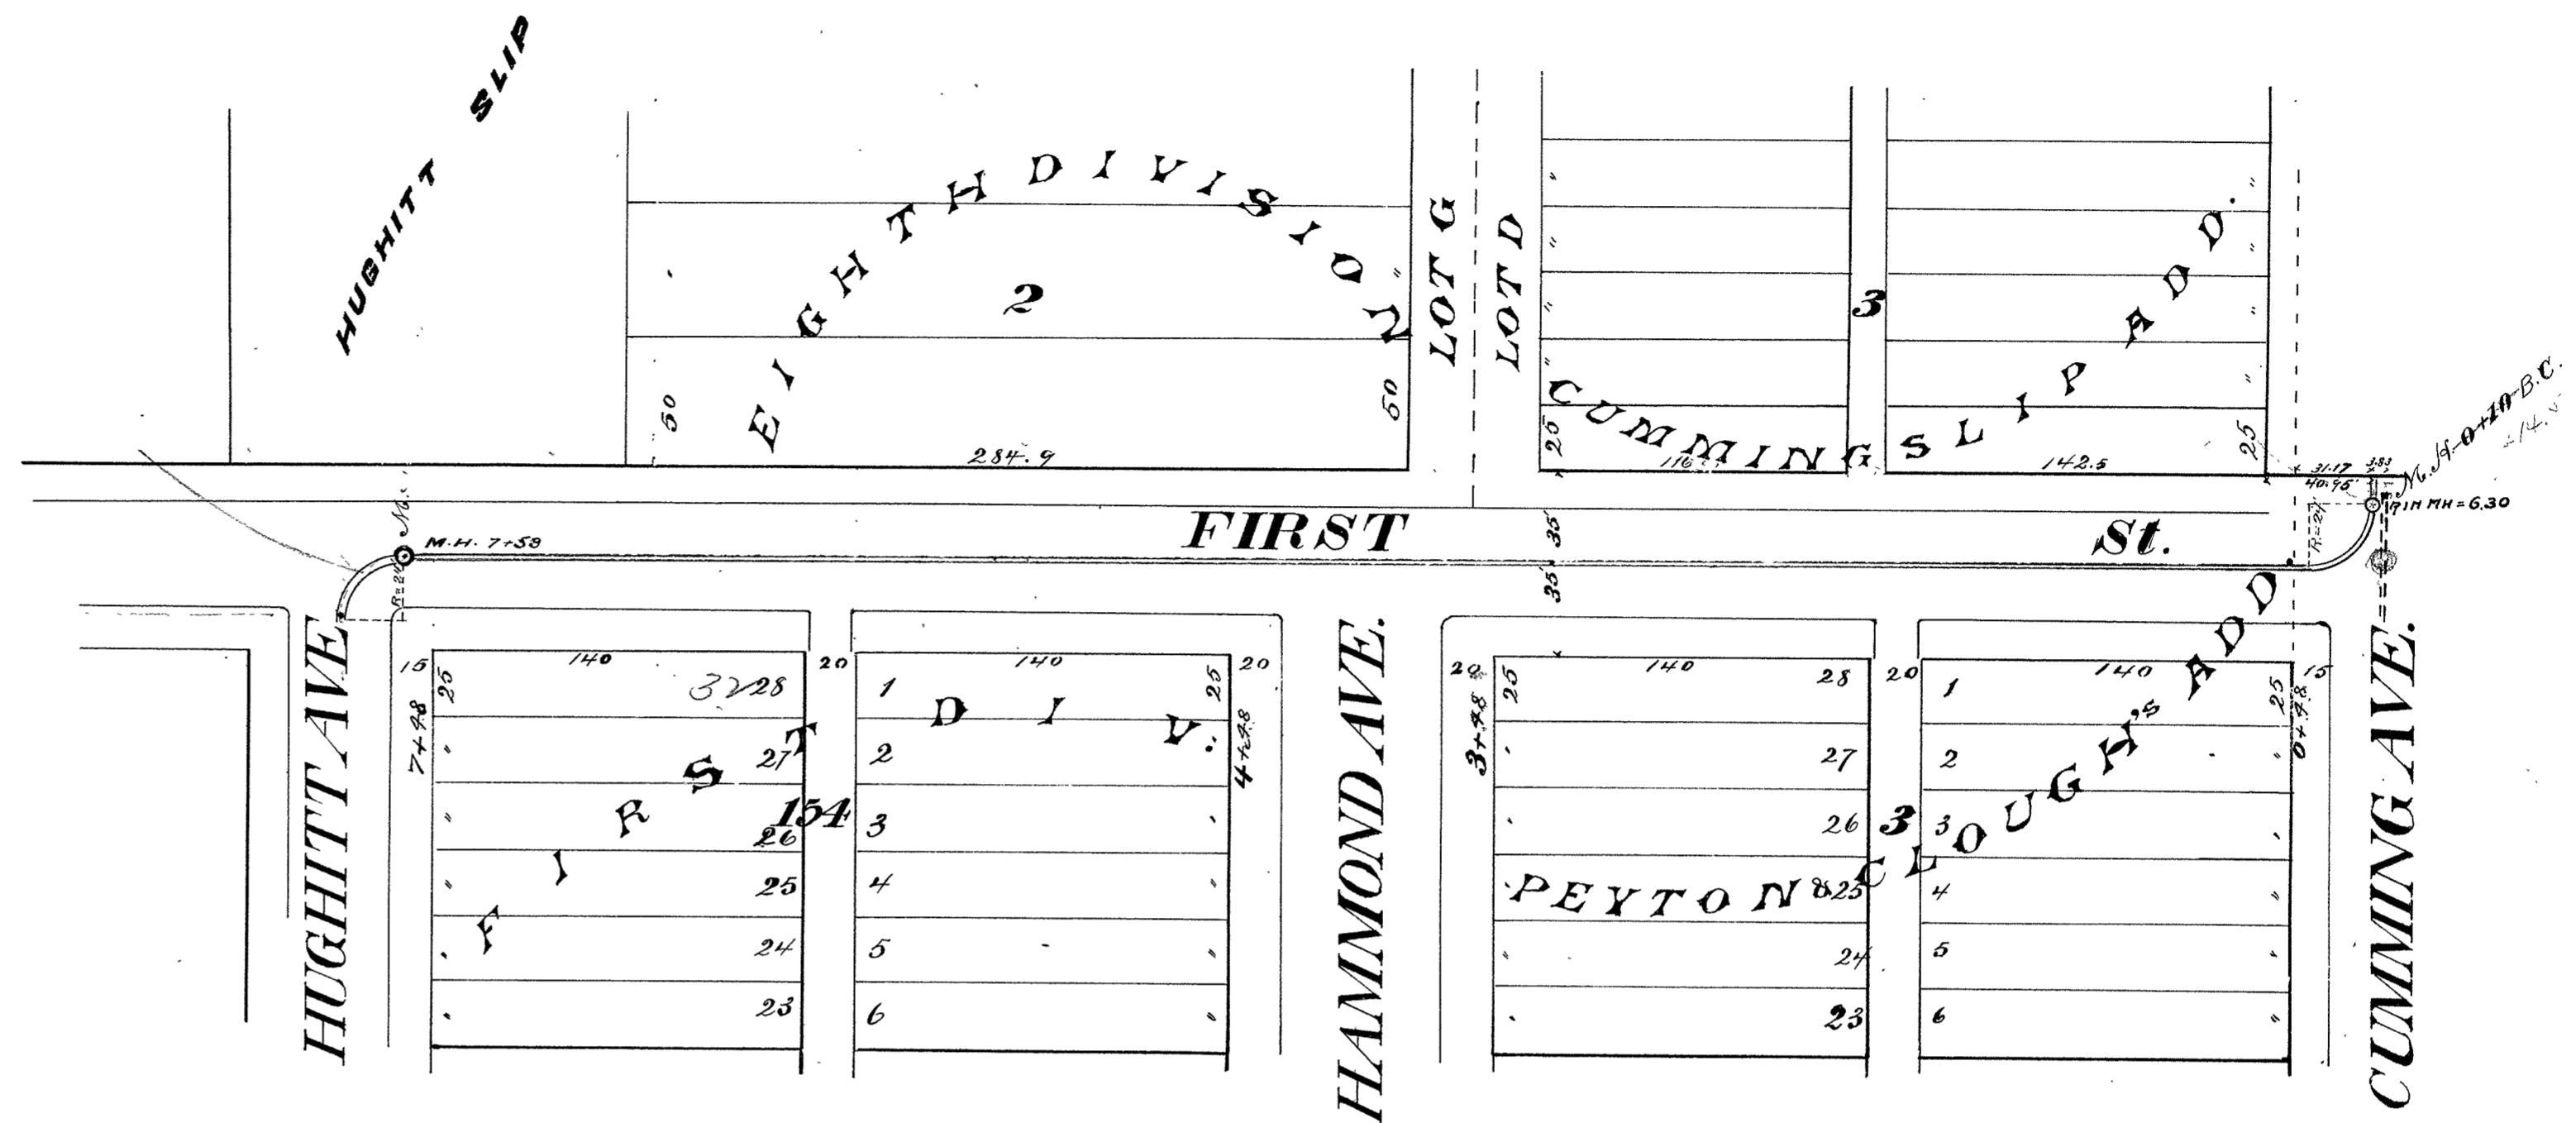