




Note: No Connections reported for Lots 11, 12, 13, 16, 17 & 18

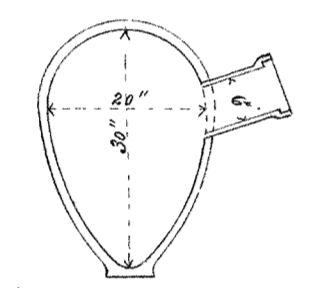


Section of 20" x 30" Pipe

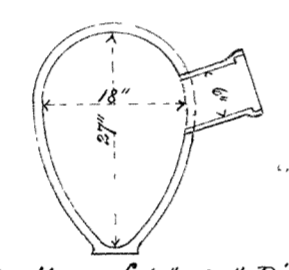

Section of 18" x 27" Pipe

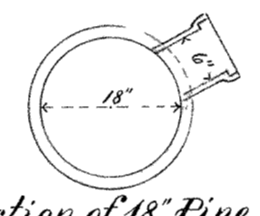

Section of 18" Pipe

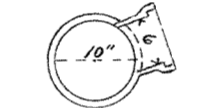

Section of 10" Pipe



Section of 8" Pipe

Scale: Horizontal 1 in. to 60 ft.
 Vertical 1" = 4'
 Section 1" = 2'

CITY OF SUPERIOR

SEWER PLAN

Contract let Sept. 1, 1890
 completed Dec. 1, 1890
 Joseph Wolf, Contractor
 I. C. Grant & J. N. Little, Inspectors
 E. B. Banks, City Engineer

