

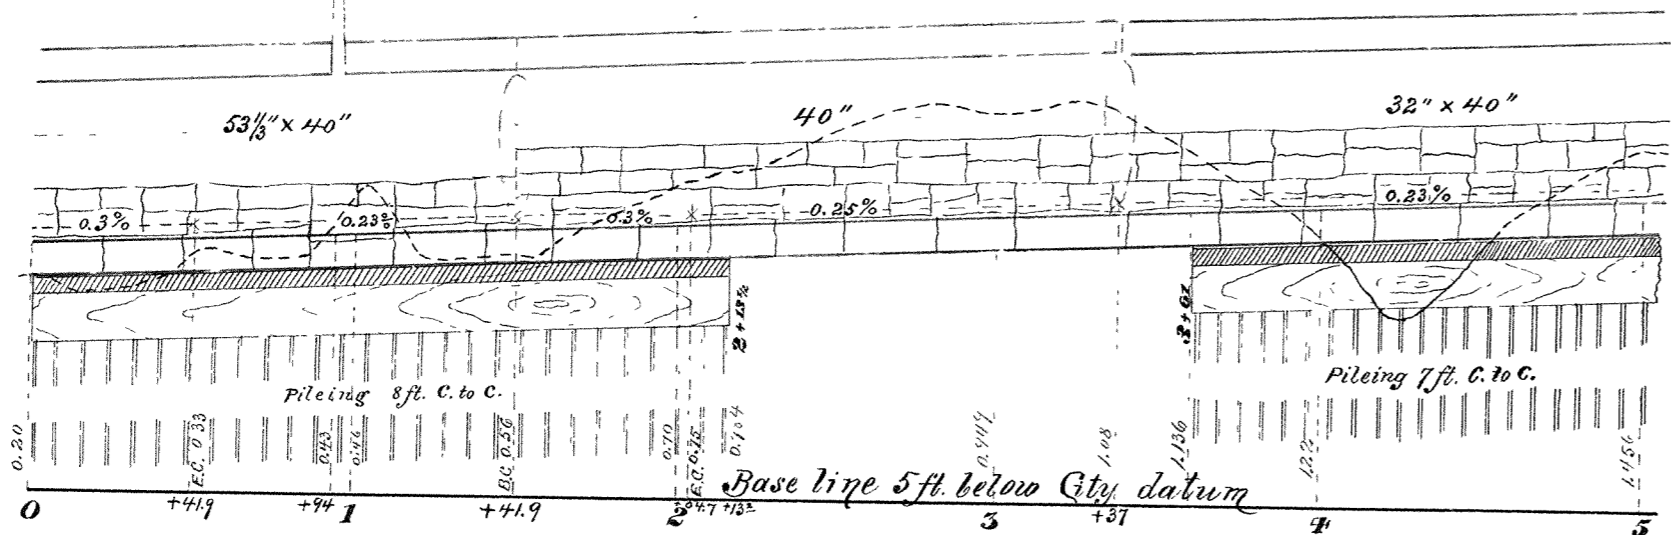
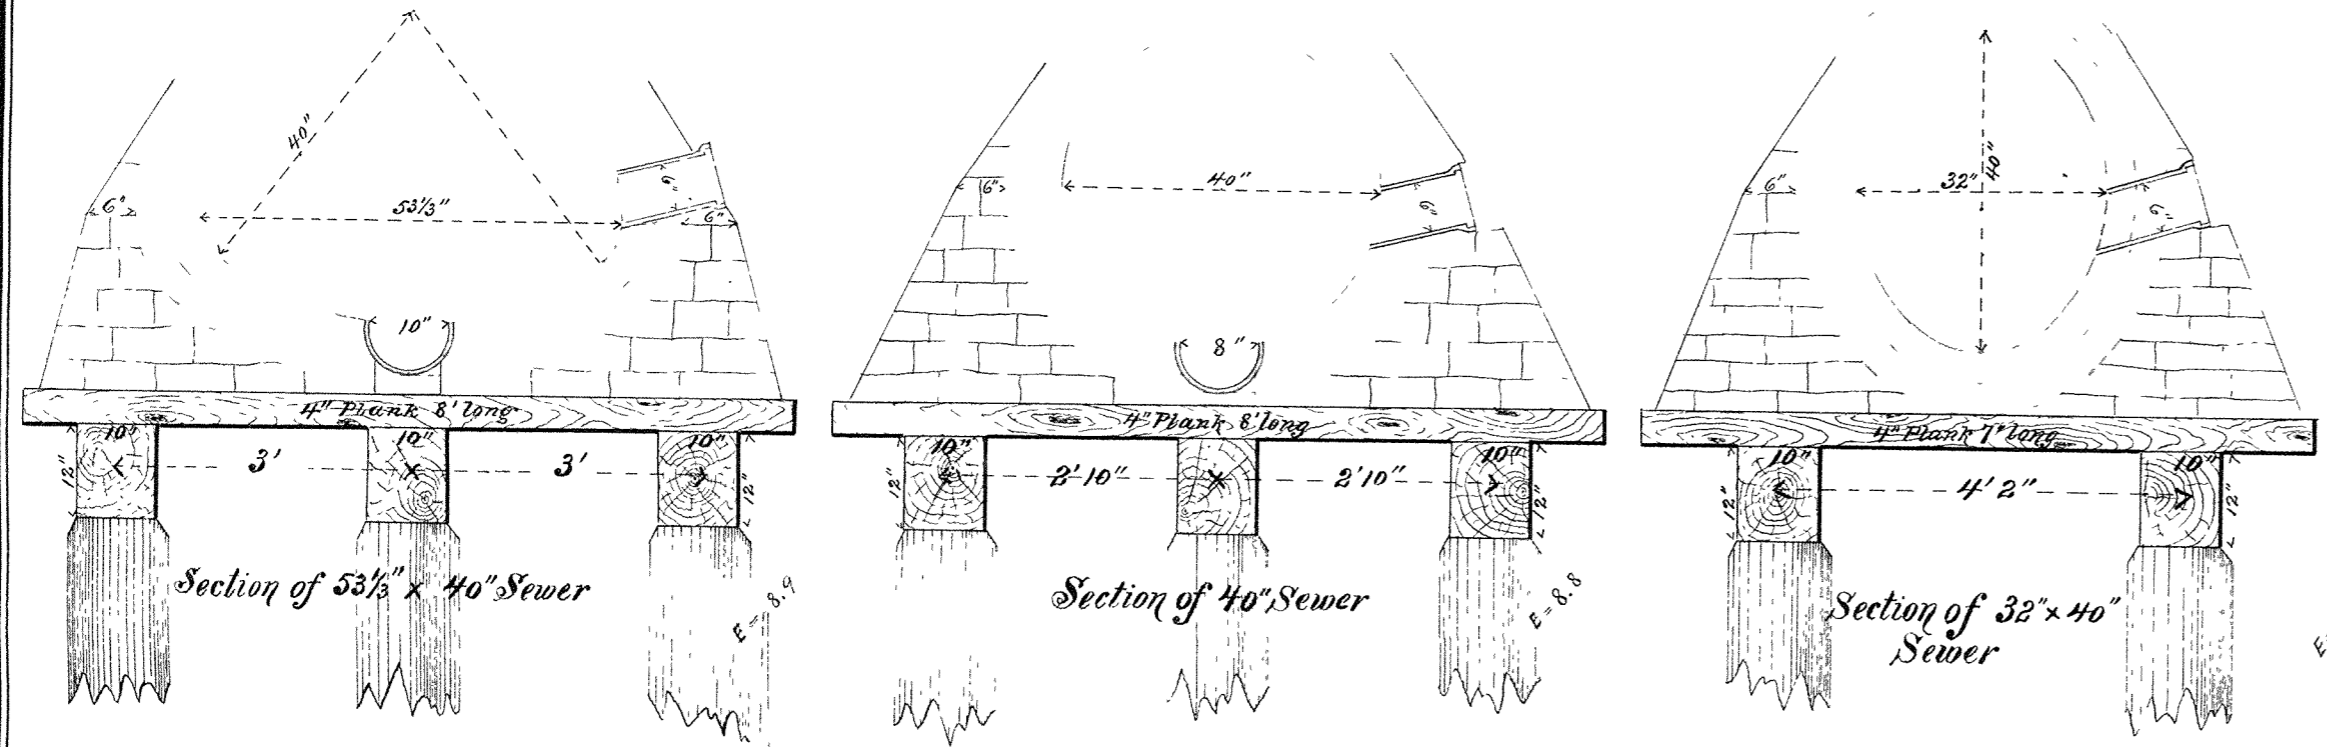


CITY OF SUPERIOR SEWER PLAN

Contract let Sept. 1, 1890
" completed Dec. 1, 1890
Joseph Wolf, Contractor
I. C. Grant & J. H. Little, Inspectors
E. B. Banks, City Engineer

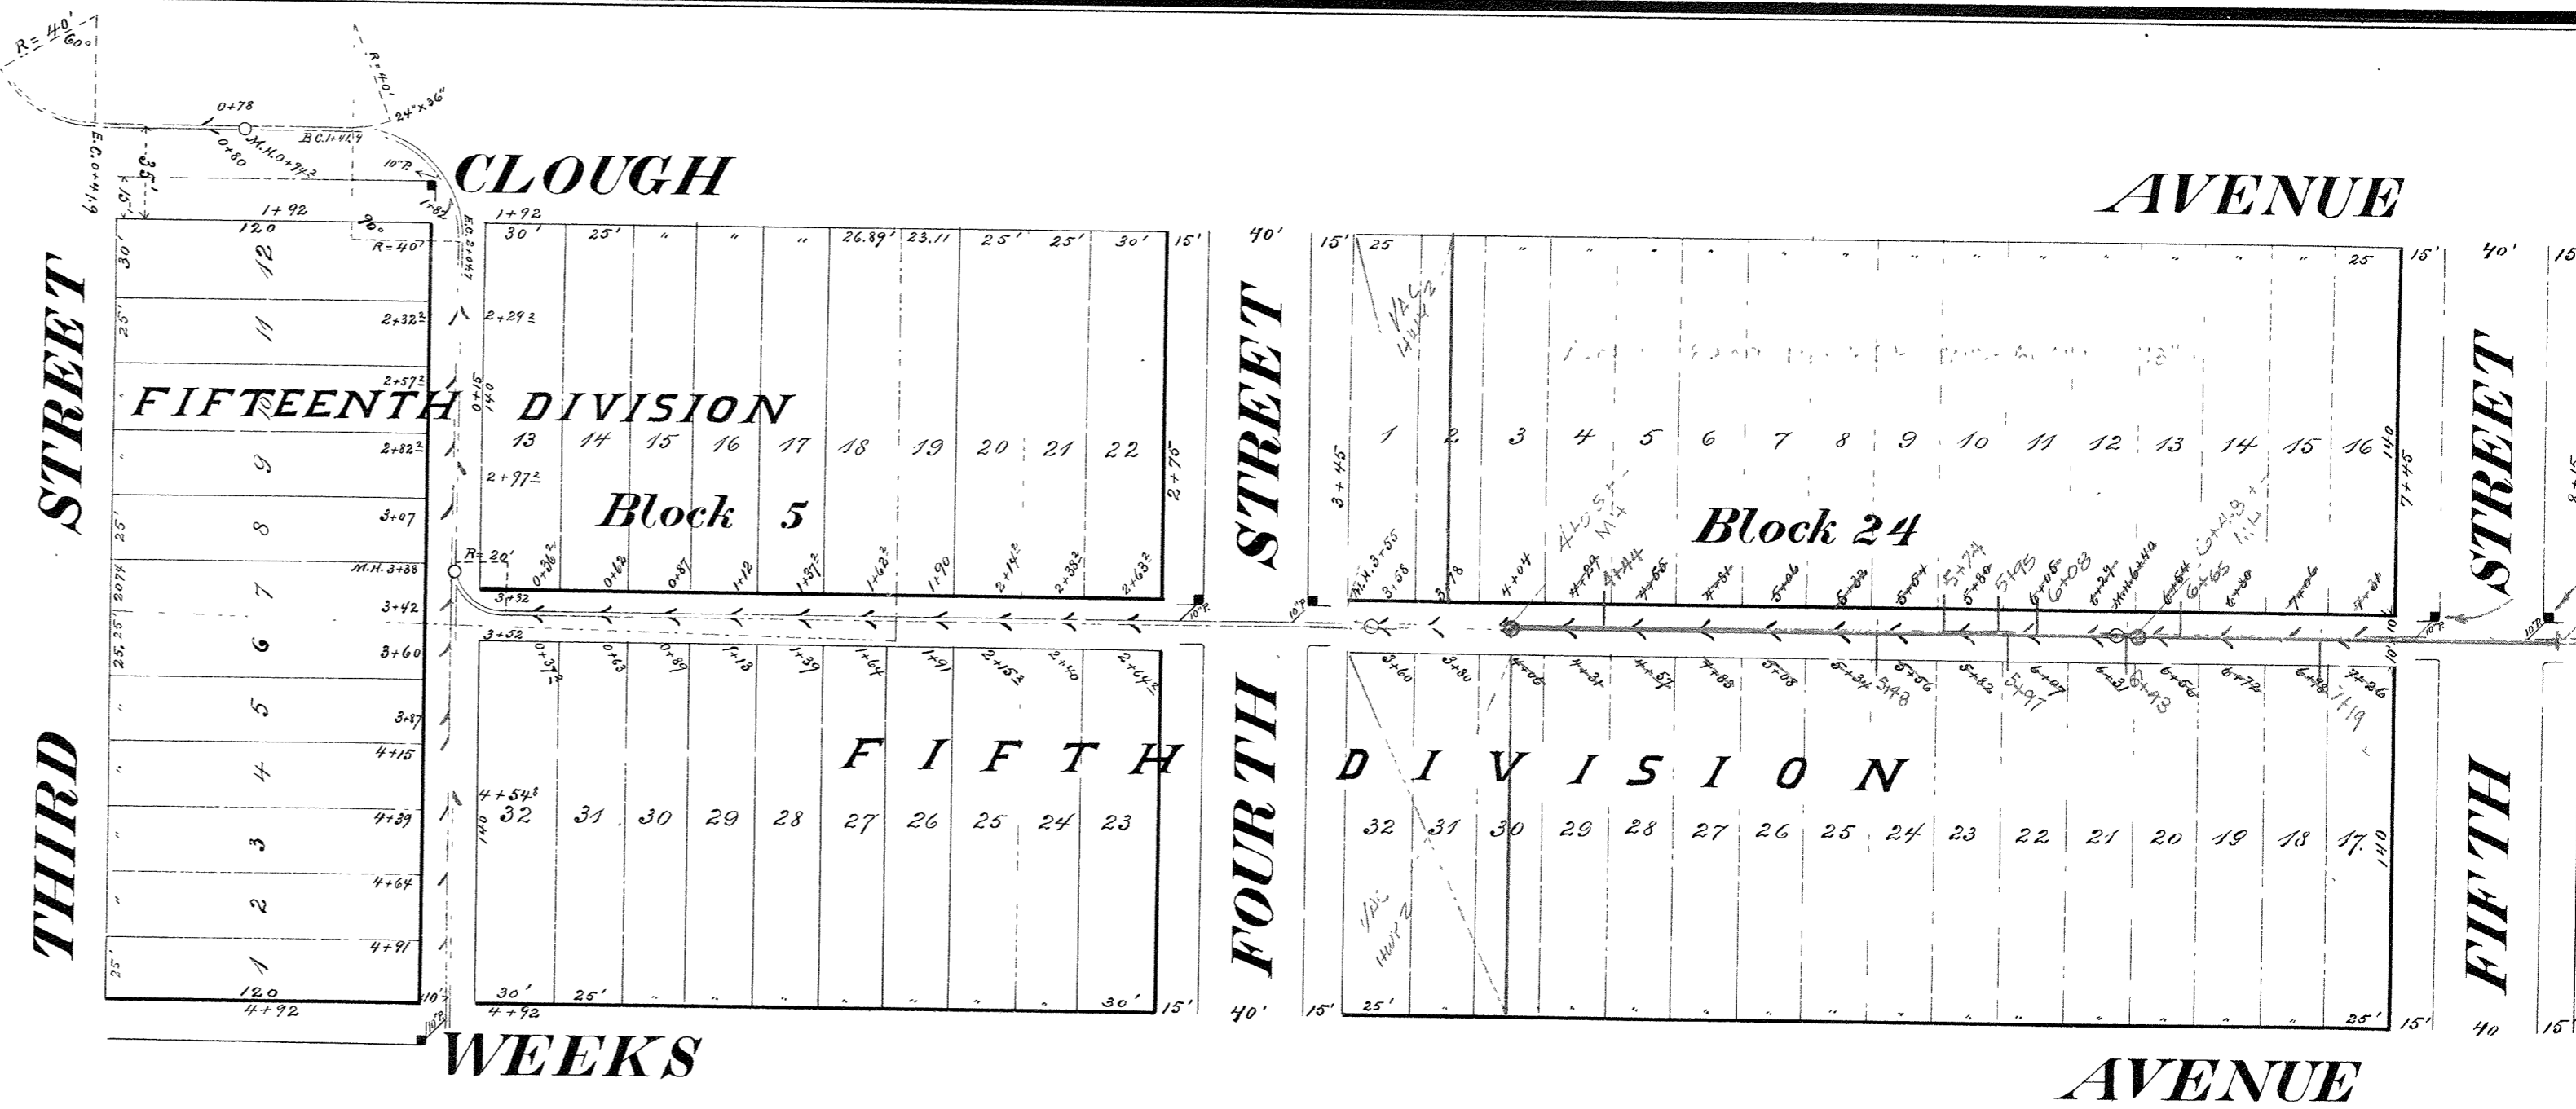

Profile of Sewer in Alley between Third & Fourth Streets

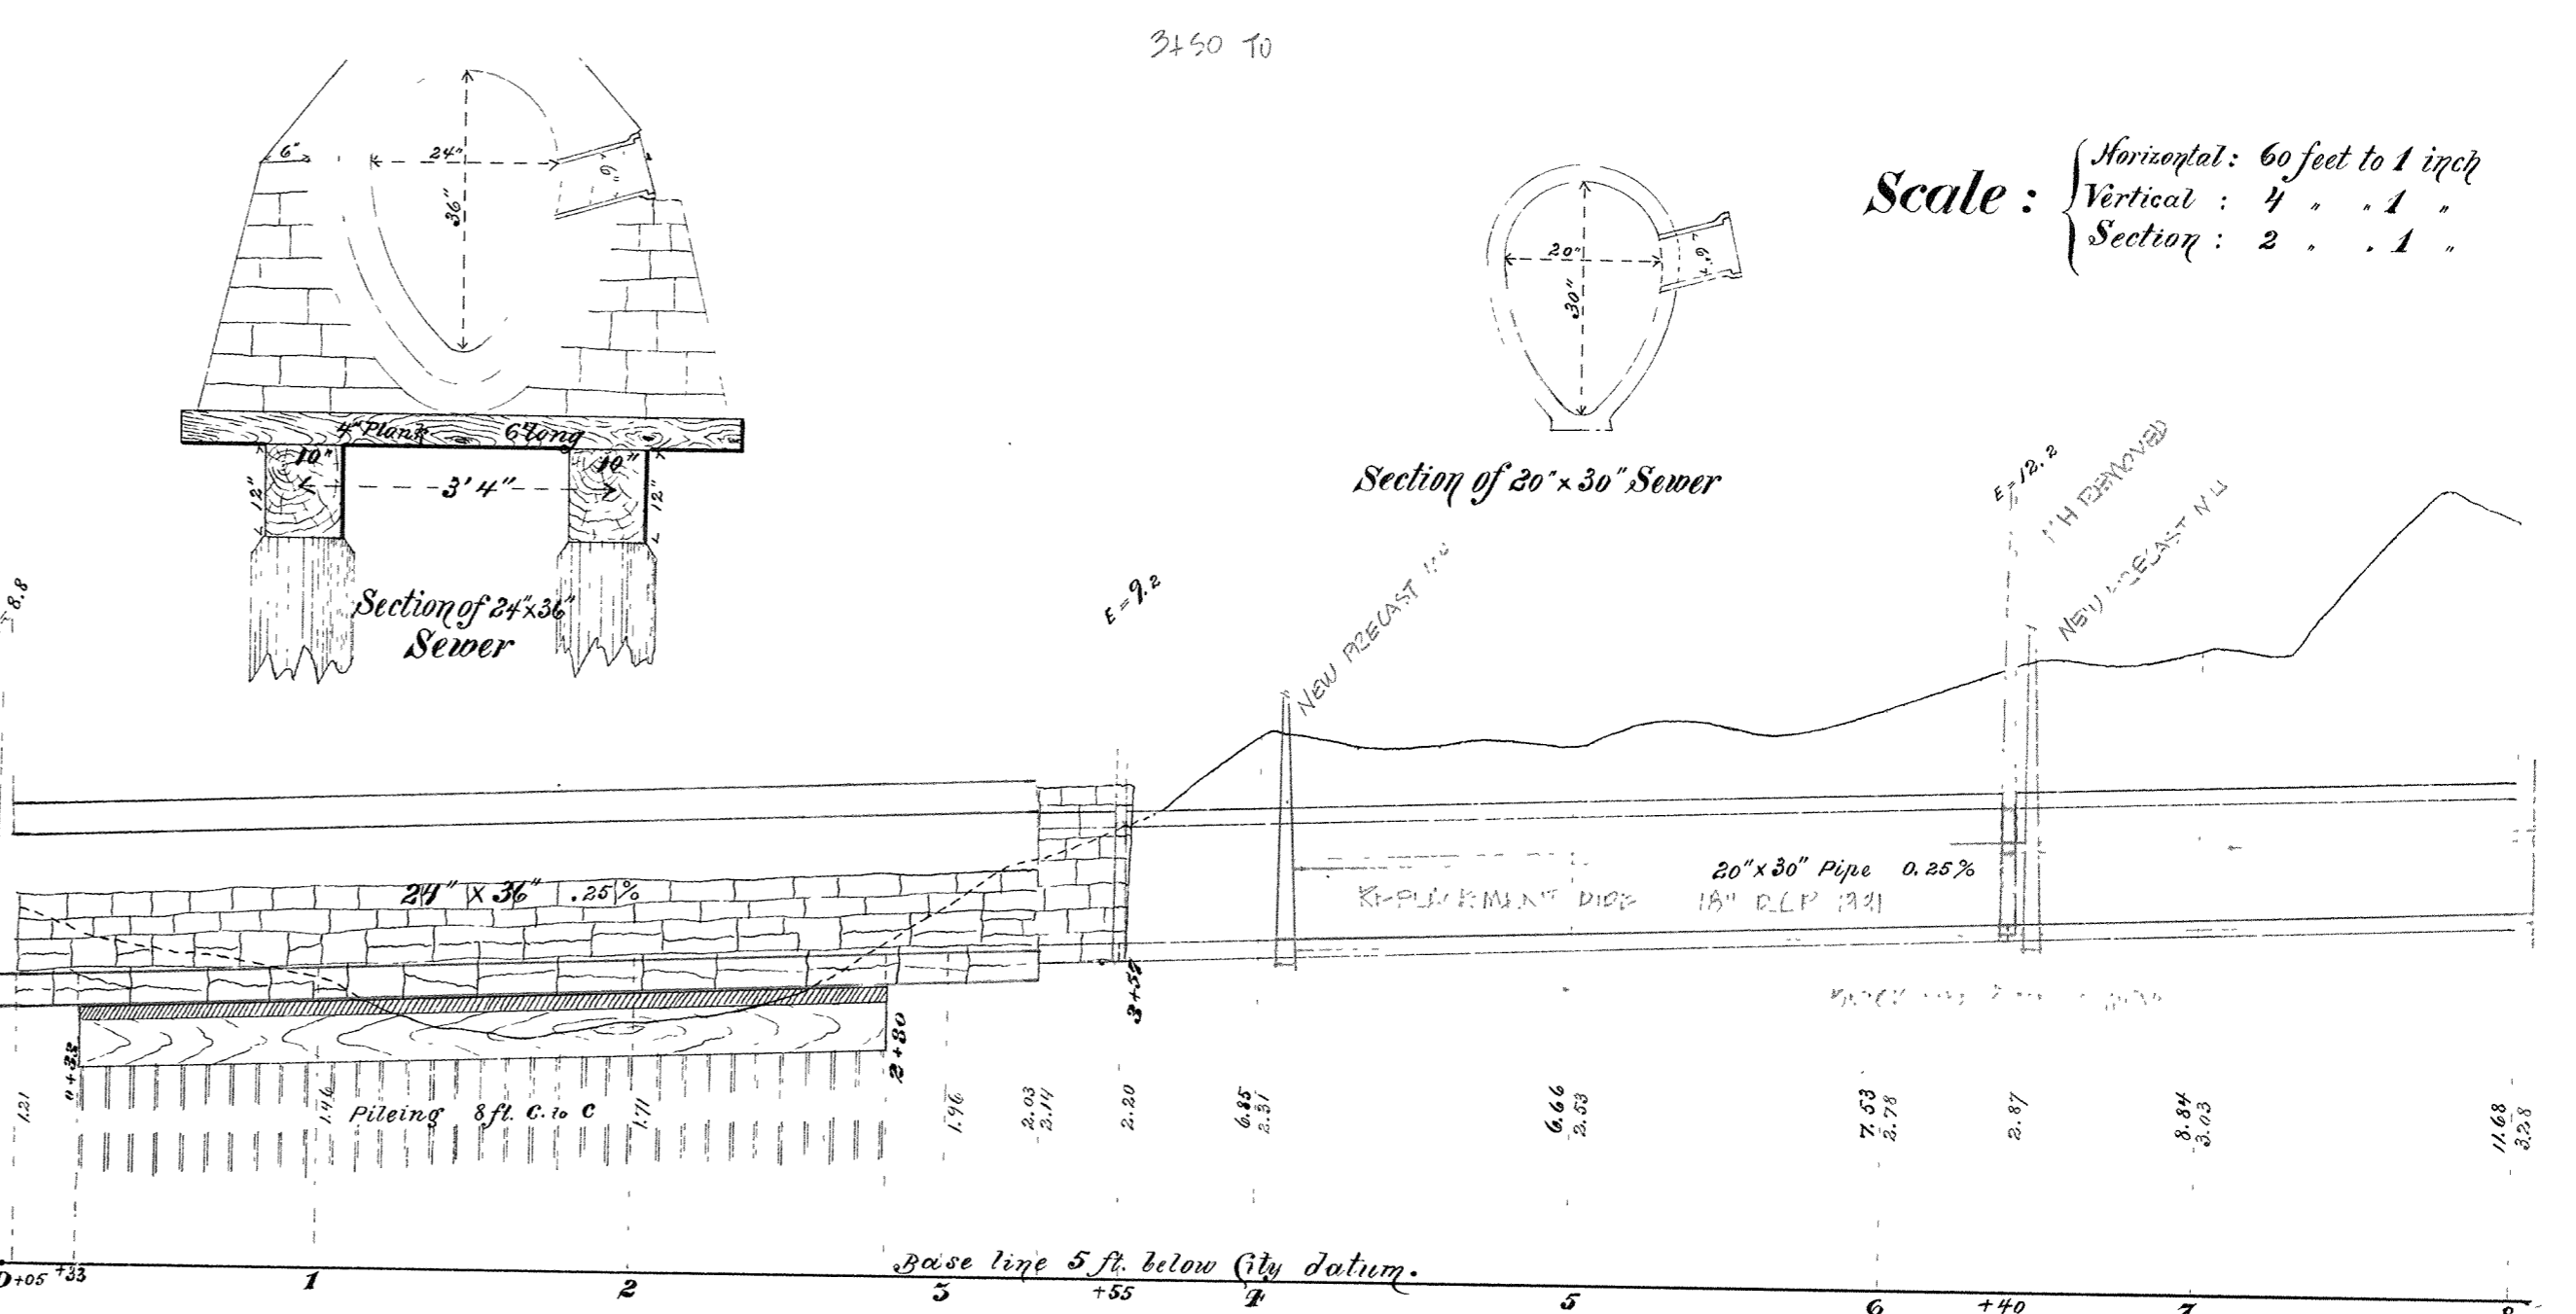

Profile of Sewer in Alley between Clough & Weeks Aves

Scale: Horizontal: 60 feet to 1 inch
Vertical: 4" = 1'
Section: 2" = 1'