


Note: Sewer reconstructed from M.H. 0+68 to M.H. 5+16. - Sept. 1936. Old piling left in as shown below. New sewer shown on plan No. 27-A

Note: Sewer reconstructed from M.H. 5+16 to Std. 7+62 - JUNE 1937. See sewer plan No. 27-A.


Scale { Horizontal 1 inch = 60 feet
Vertical 1" = 4'
Section 1" = 24"

CITY OF SUPERIOR SEWER PLAN


Contract let Sept. 2, 1891
completed Nov. 7, 1891
Kirkland & Starkes Contractor
J. N. Little, Inspector
E. B. Banks, City Engineer

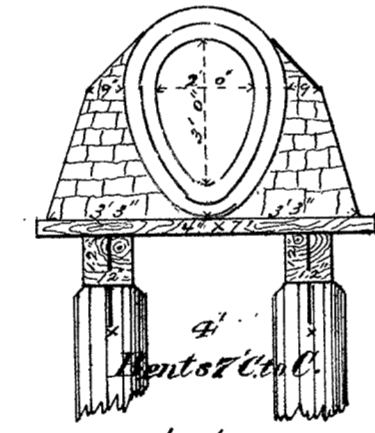


Section of 2'0" x 3'0" Sewer on Piles

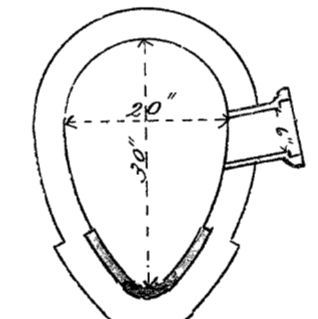

Section of 20" x 30" Sewer

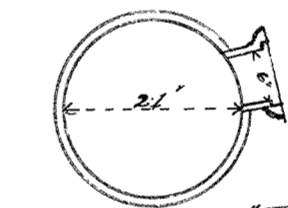

Section of 21" Pipe

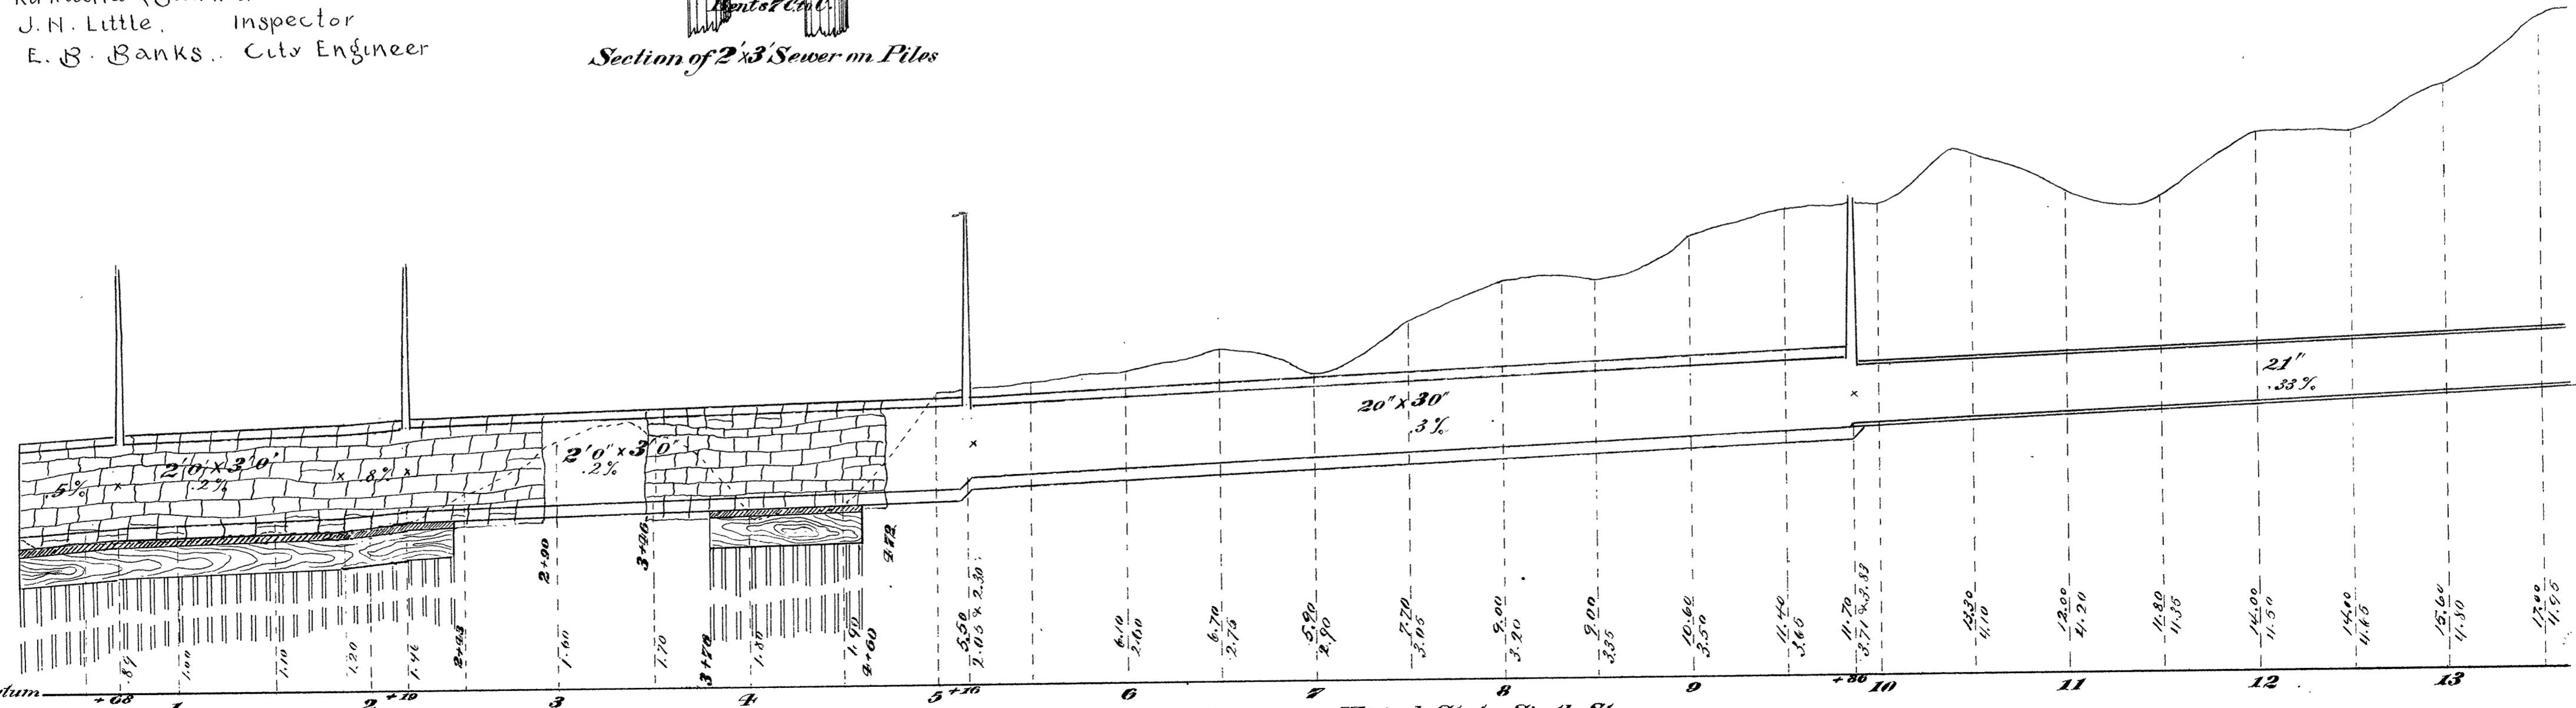

Profile of Sewer in Alley betw. Clough & Fisher Ave's from Third St. to Sixth St.

1-27