

### CITY OF SUPERIOR SEWER PLAN



HORIZONTAL SCALE 1" = 60'  
VERTICAL SCALE 1" = 4'

JOB STARTED SEPT, 1936  
JOB COMPLETED SEPT, 1936  
W. P. A. LABOR  
M. SKAMSER INSPECTOR

L. W. PELESKE CITY ENGINEER

STA. 4+48 TO STA. 6+94  
JOB STARTED MAY 15, 1937  
JOB COMPLETED JUNE 1, 1937  
W. P. A. LABOR  
M. SKAMSER INSPECTOR

42" R.C. PIPE REPLACING  
24" BY 36" BRICK SEWER  
STA. 0+0 TO STA. 4+48

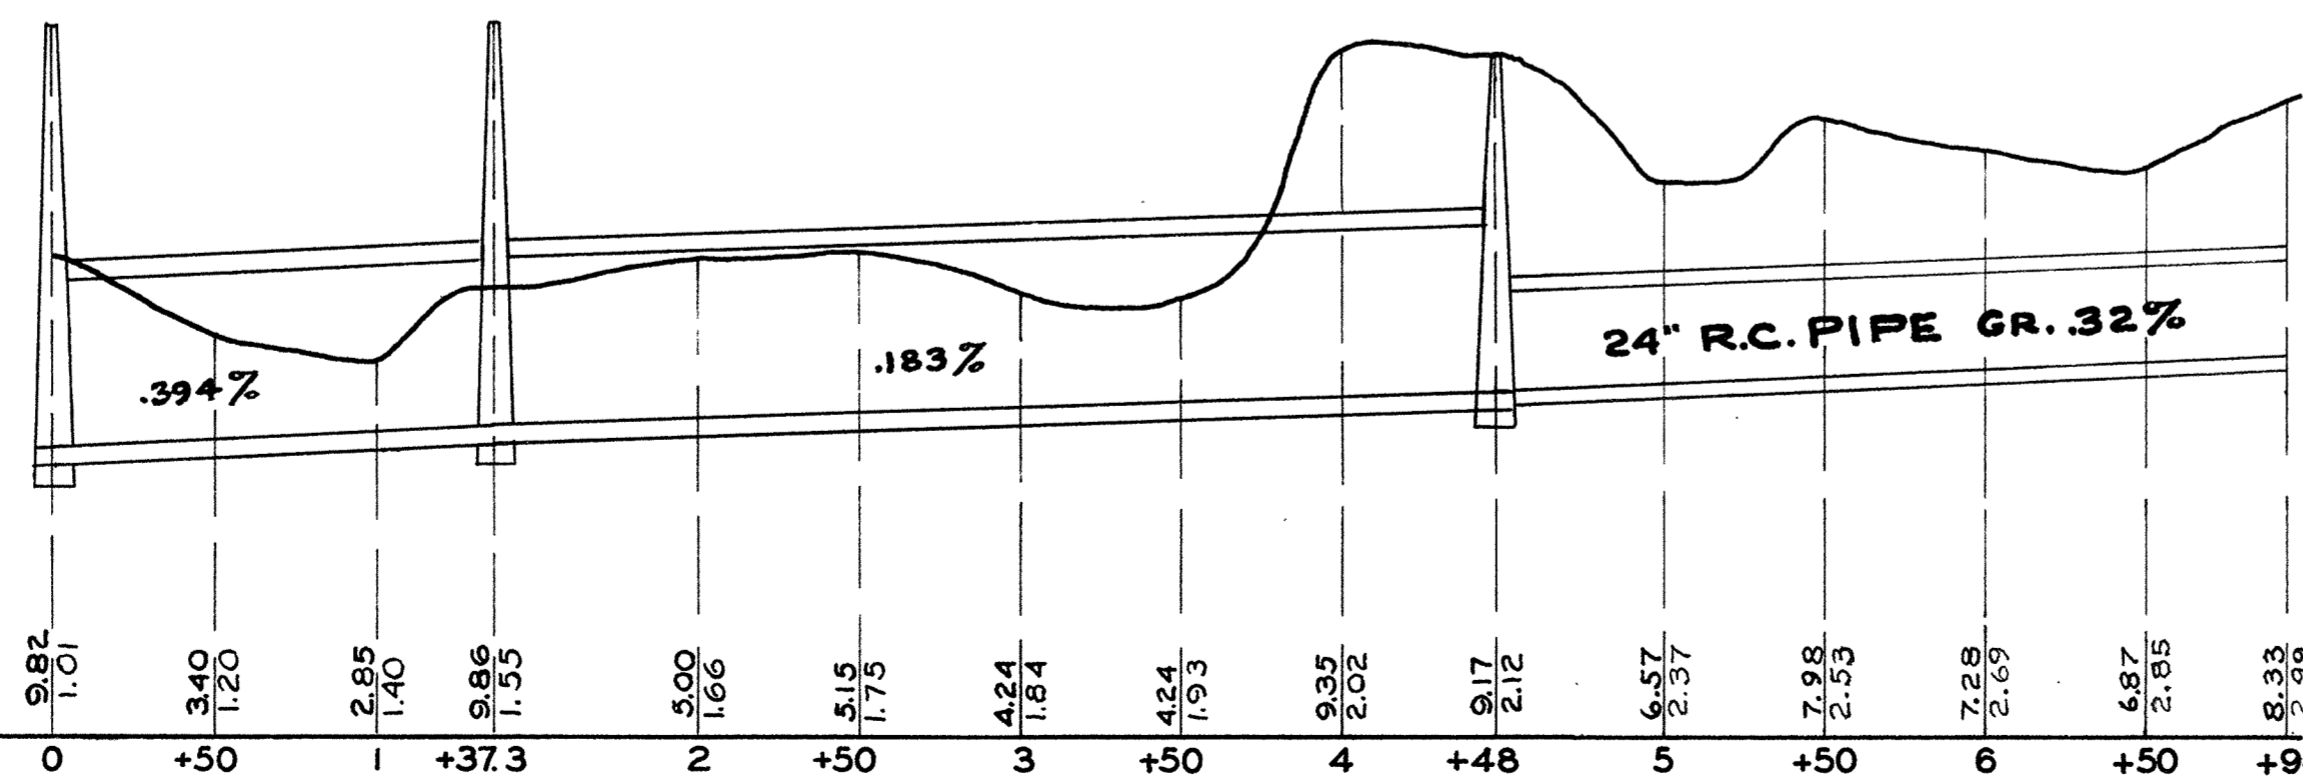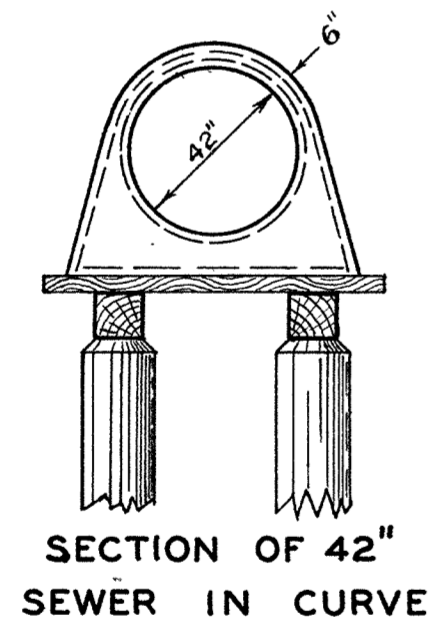

1-27A