



**CITY OF SUPERIOR
SEWER PLAN**

Contract let April 4, 1890.
 " completed Oct. 1, 1890.
 Kirkland & Starkey, Contractor.
 P. J. Murtagh, Inspector.
 E. Banks, City Engineer.

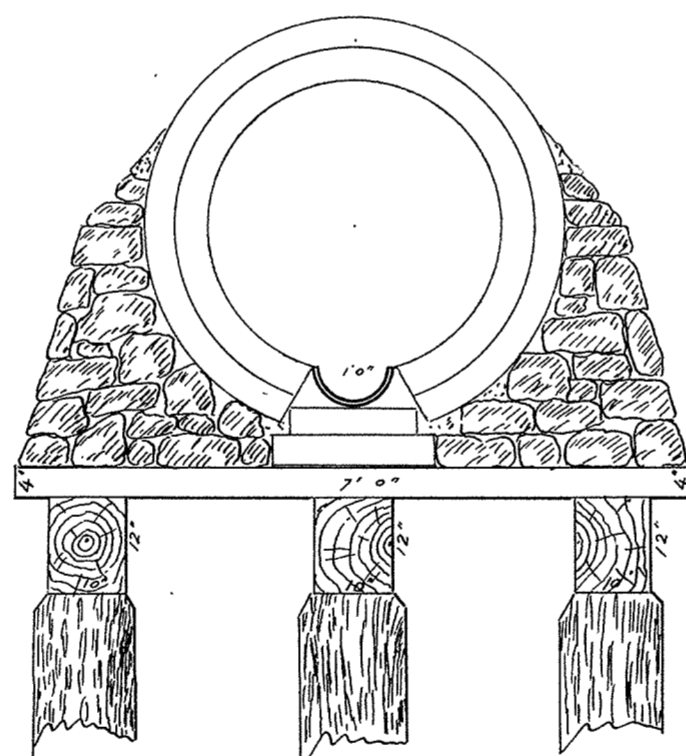


Section of 3' Sewer on Piles

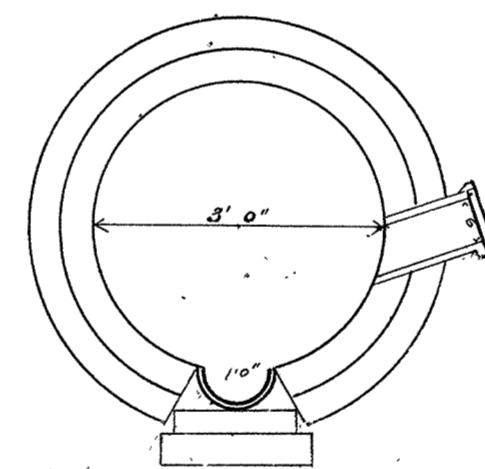

Section of 3' Sewer

Scale { Horizontal 1 inch = 60 Ft.
 Vertical 1" = 4"
 Sectional 1" = 2"

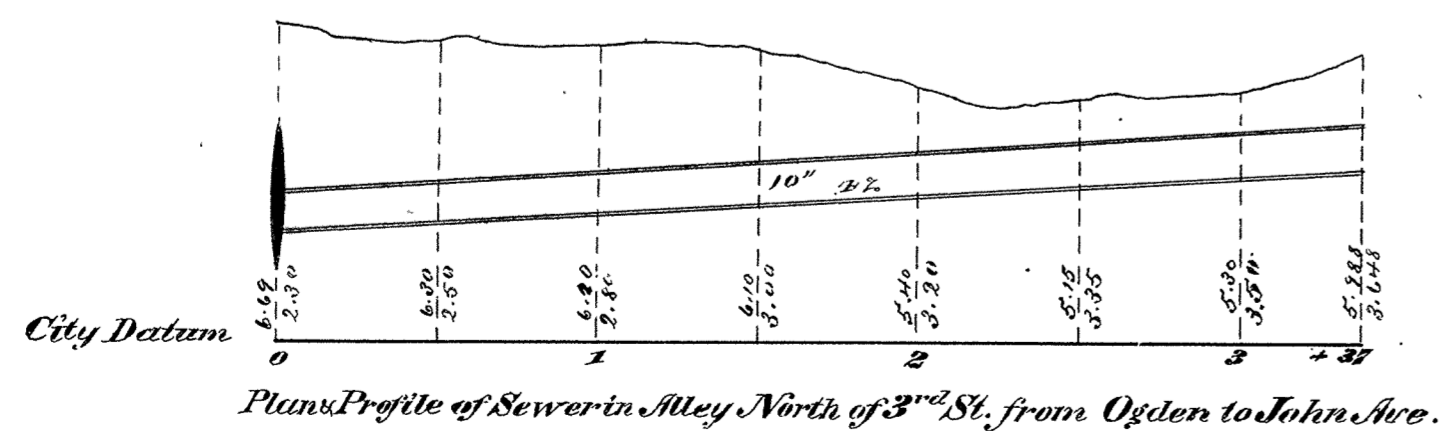

Base 3 Ft. below Datum

