
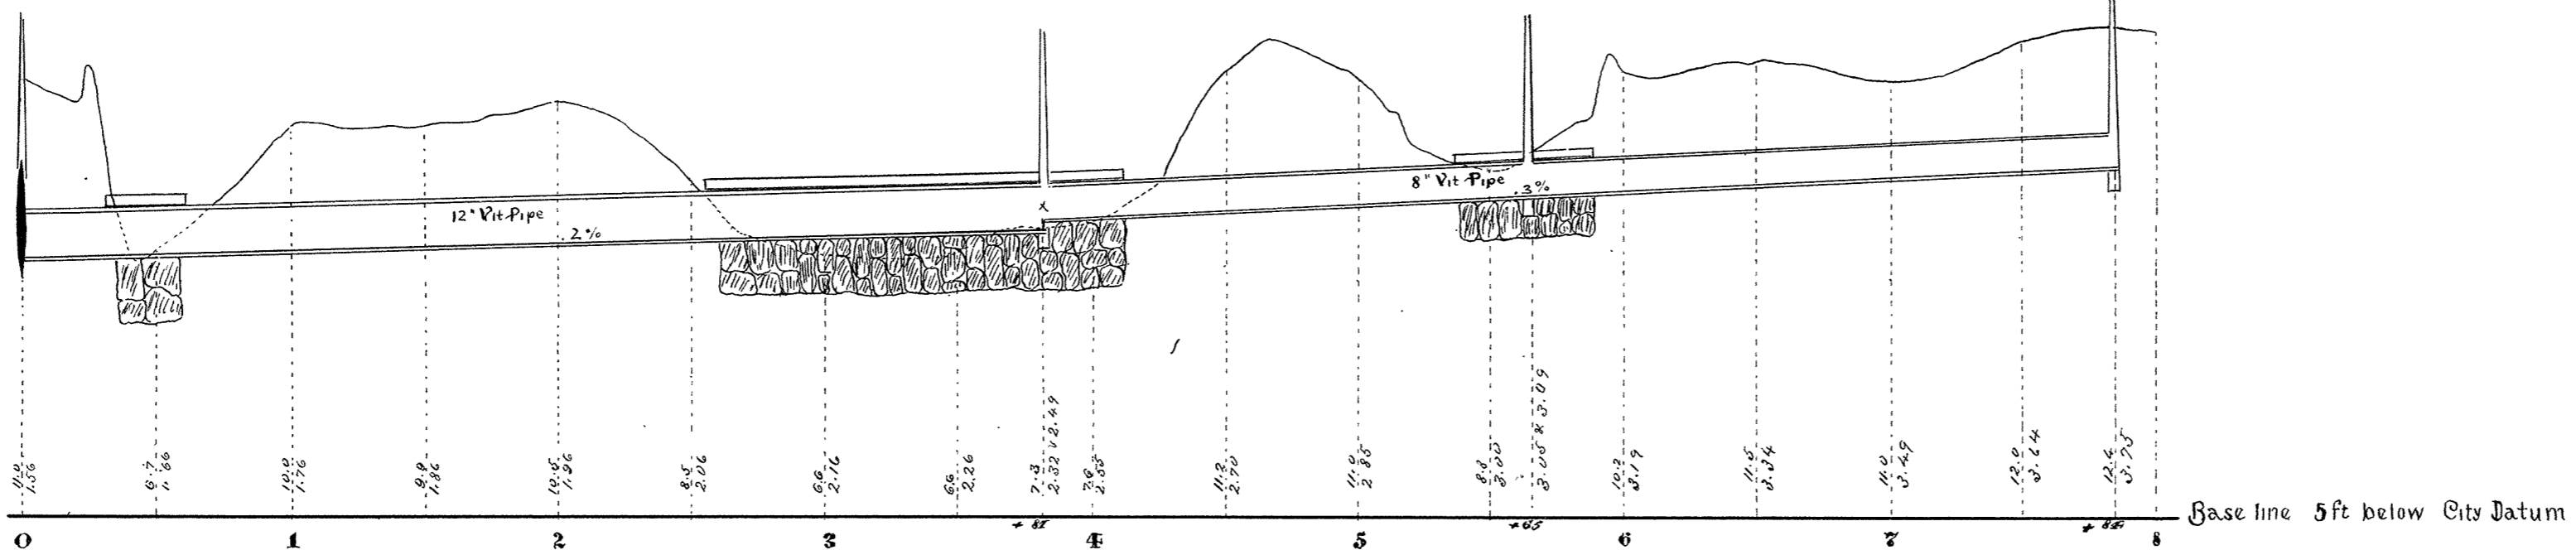


# CITY OF SUPERIOR SEWER PLAN

Contract let Sept. 2, 1893  
 " completed Sept. 29, 1893  
 Monks Bros. Contractor  
 F. Schwalkack. Inspector  
 A.T. Thomas. City Engineer

1893

Scale: { Horizontal 1 in. = 60 ft.  
 Vertical 1 in. = 4 ft.  
 Section 1 in. = 2 ft.

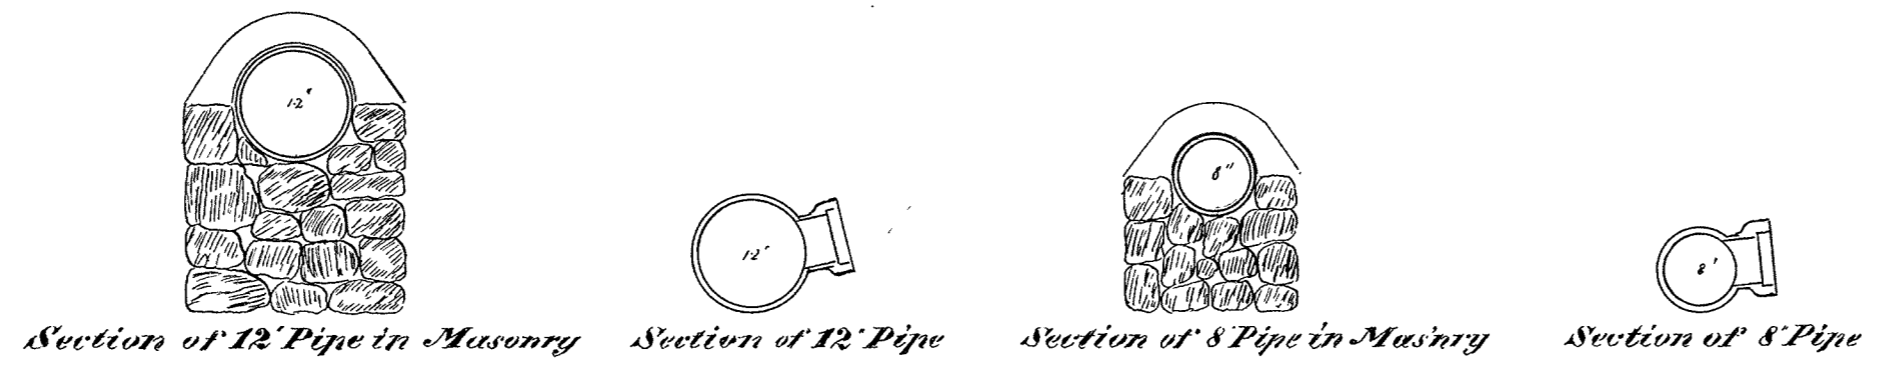

Plan & Profile of Sewer in N. Second St. from Cumming Ave East and South

1-30