
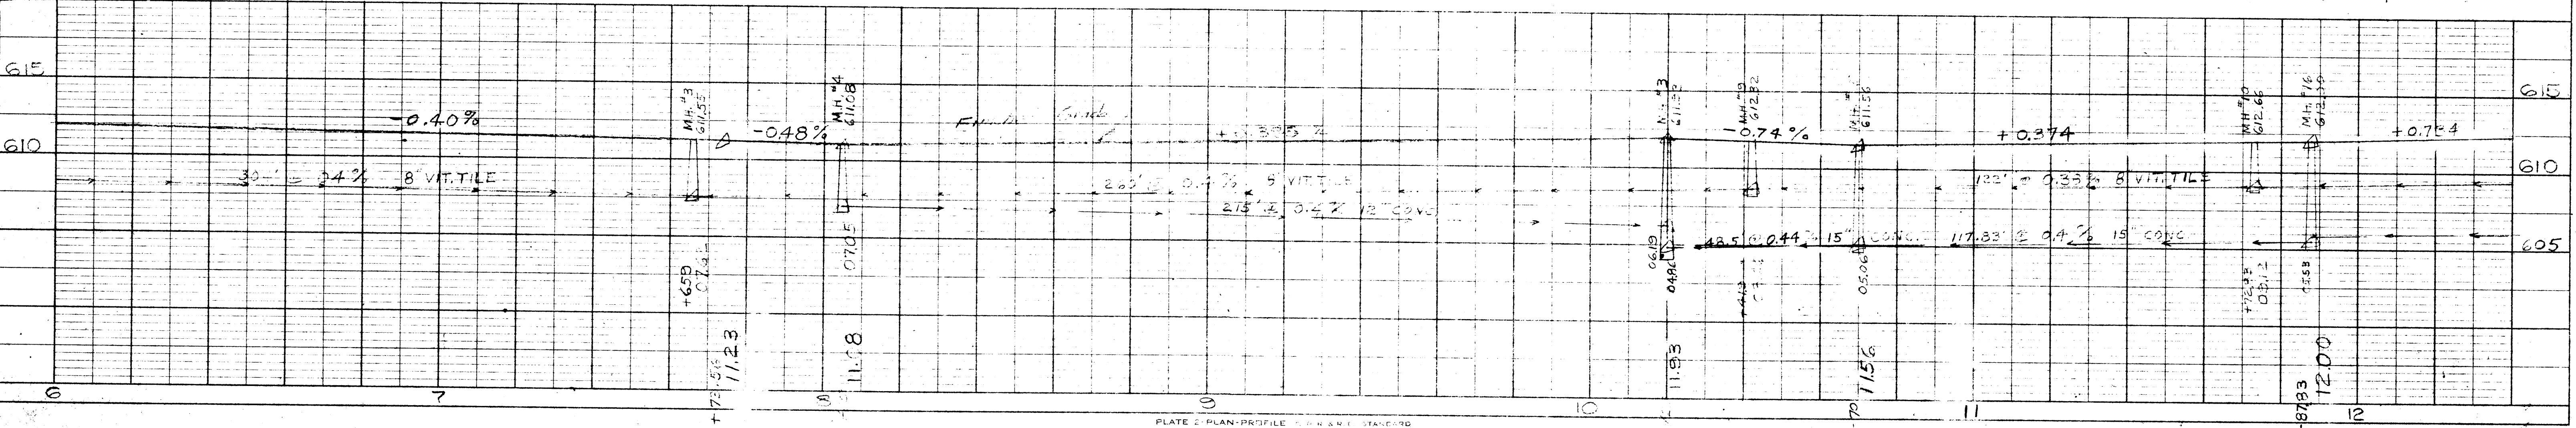
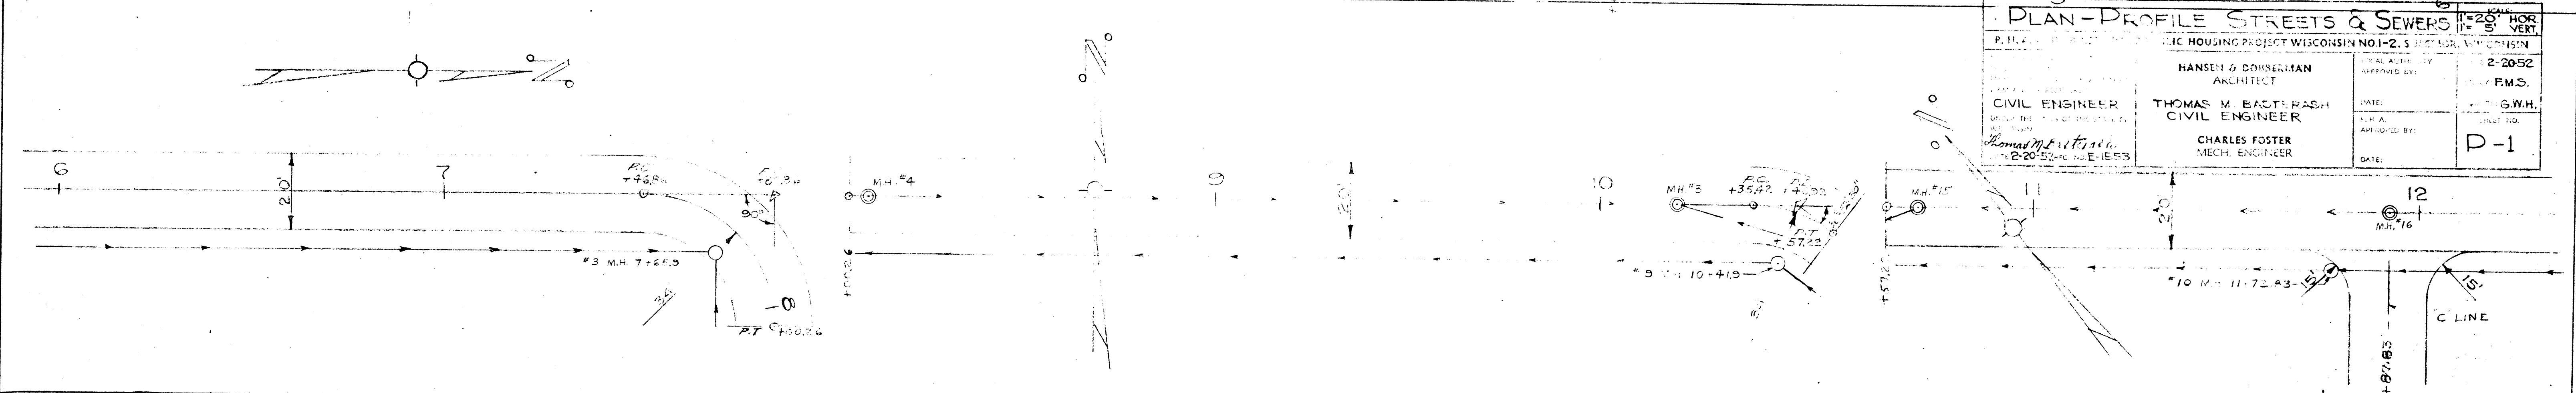
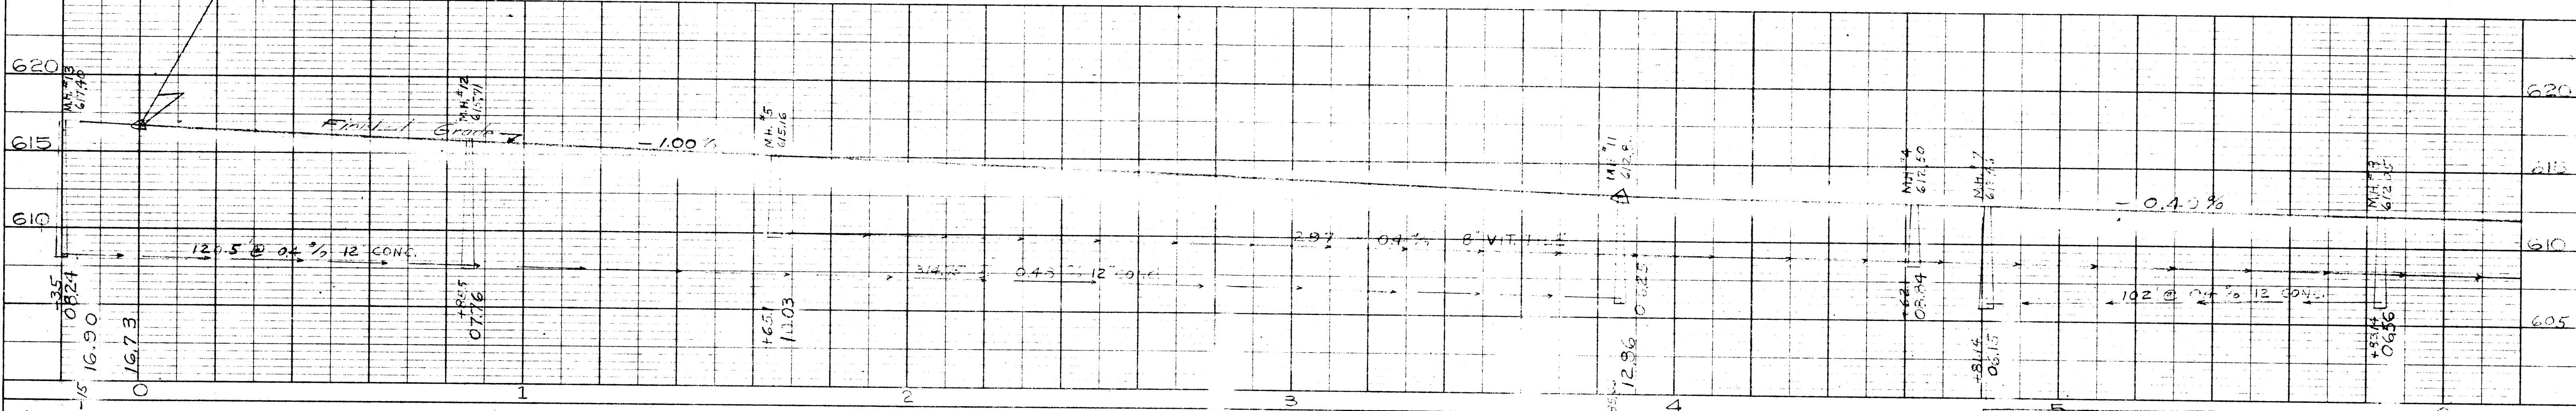


| | |
|--------------------|--|
| DATE | |
| BY | |
| REVIEWED | |
| PLANNED | |
| NOTE BOOK | |
| ALIGNMENT CHECKED | |
| RT. OF WAY CHECKED | |
| NO. | |

| | |
|-------------------------|--|
| DATE | |
| BY | |
| REVIEWED | |
| PLANNED | |
| NOTE BOOK | |
| STRUCTURE ADVANCE CHKD. | |
| NO. | |

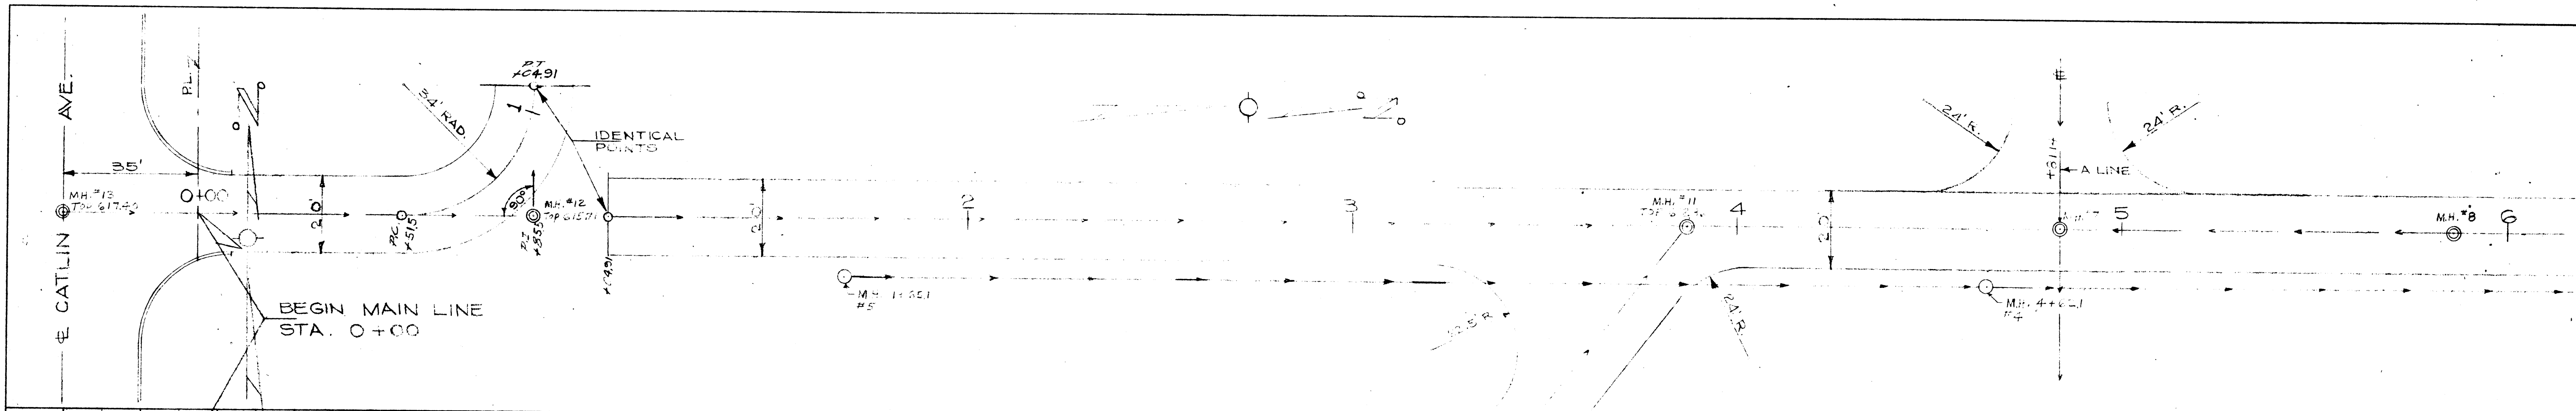

PLAN-PROFILE STREETS & SEWERS

P. H. L. & SONS, INC. CIVIL ENGINEERS
 PUBLIC HOUSING PROJECT WISCONSIN NO. 1-2, 5
 HANSEN & DOMBERMAN ARCHITECT
 CIVIL ENGINEER THOMAS M. BACHTASH
 MECH. ENGINEER CHARLES FOSTER

DATE: 2-20-52
 SCALE: HOR. 1" = 20', VERT. 1" = 5'

D-1