

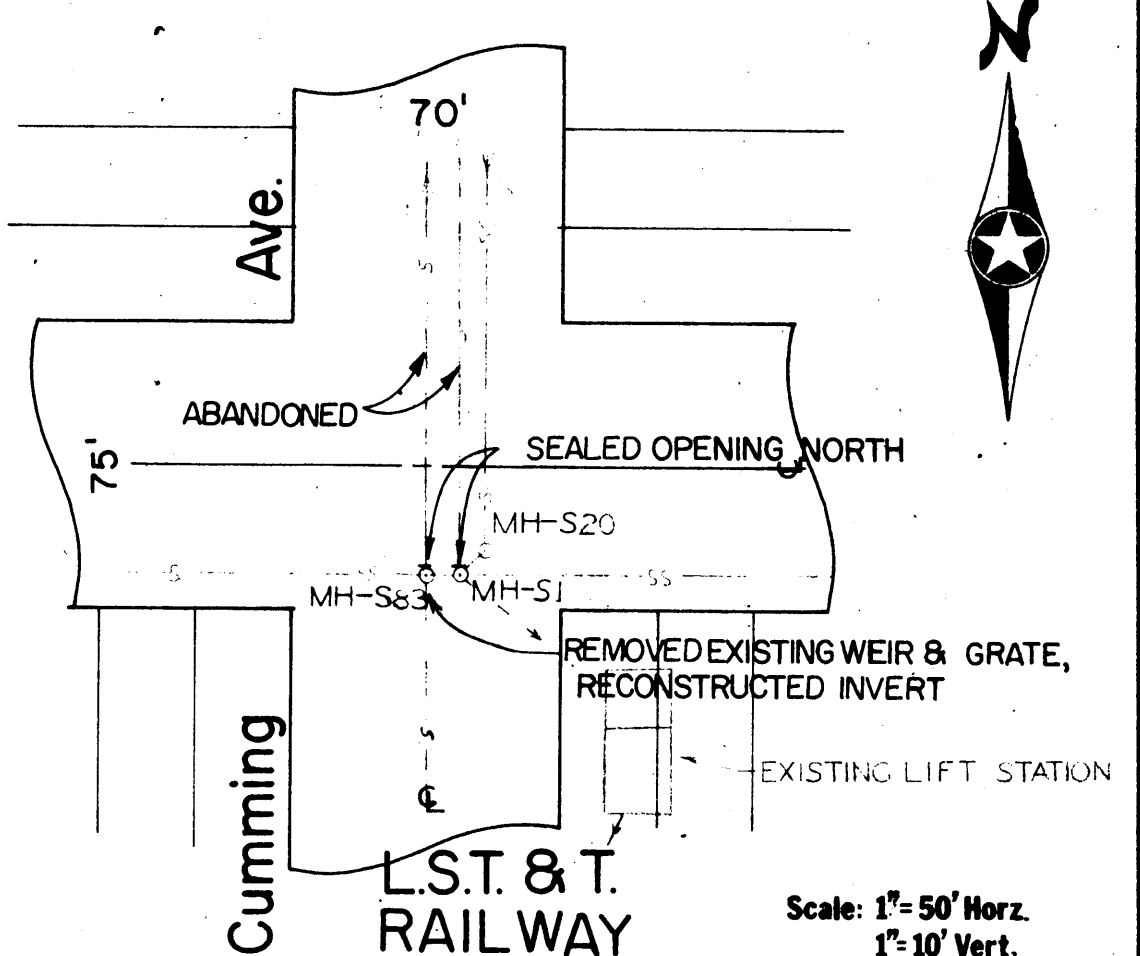
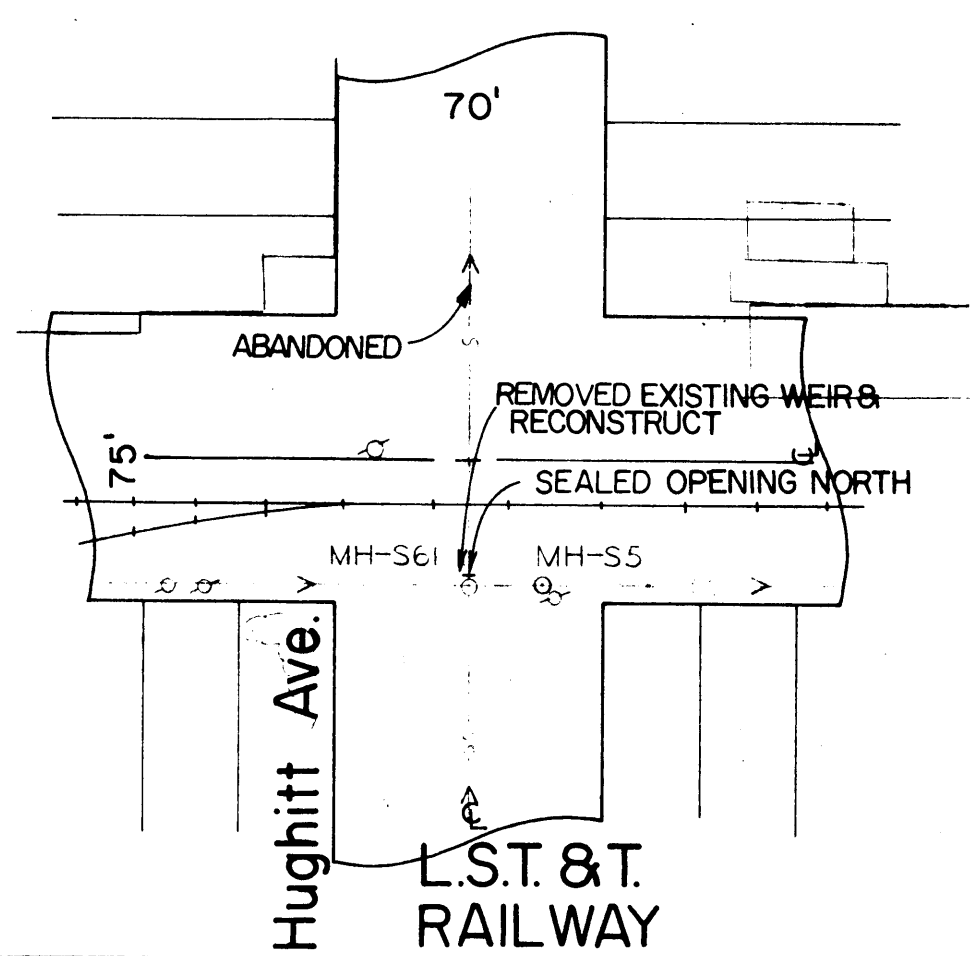
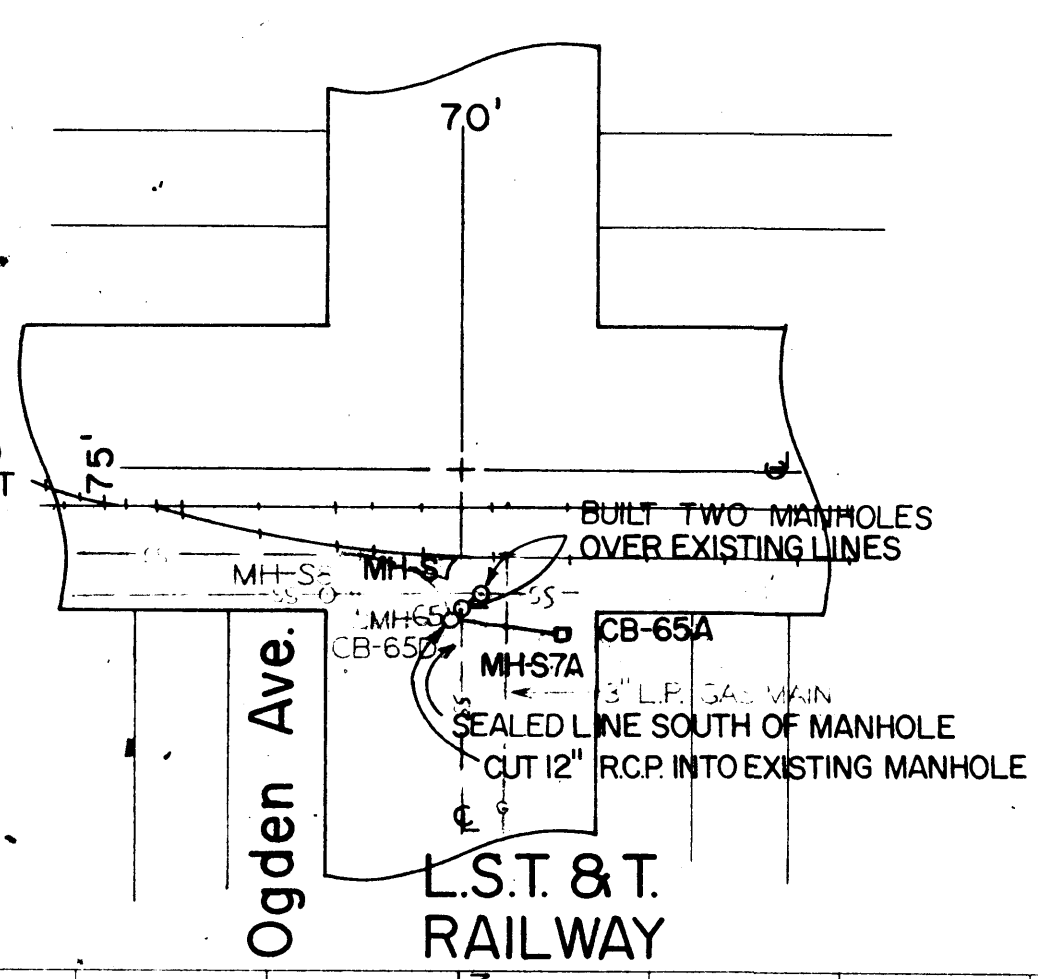
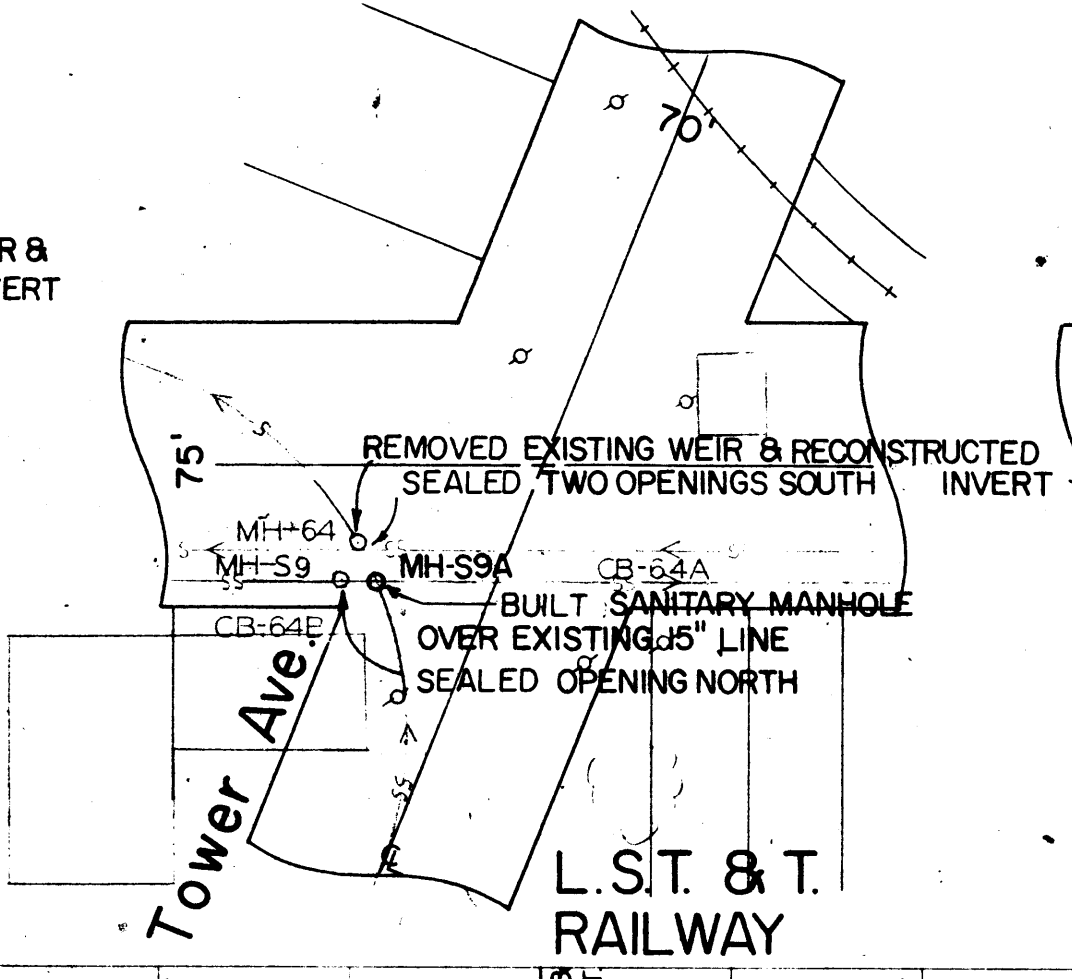


N. 3rd St.

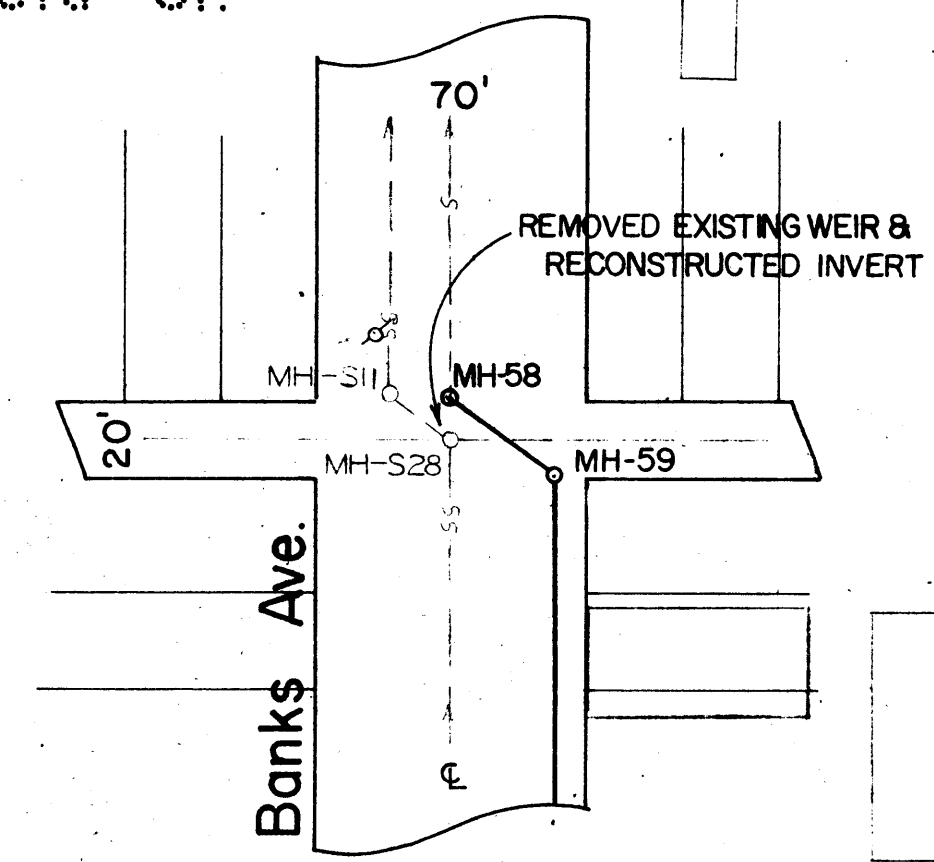


Scale: 1"=50' Horiz.
1"=10' Vert.

N. 4th St.

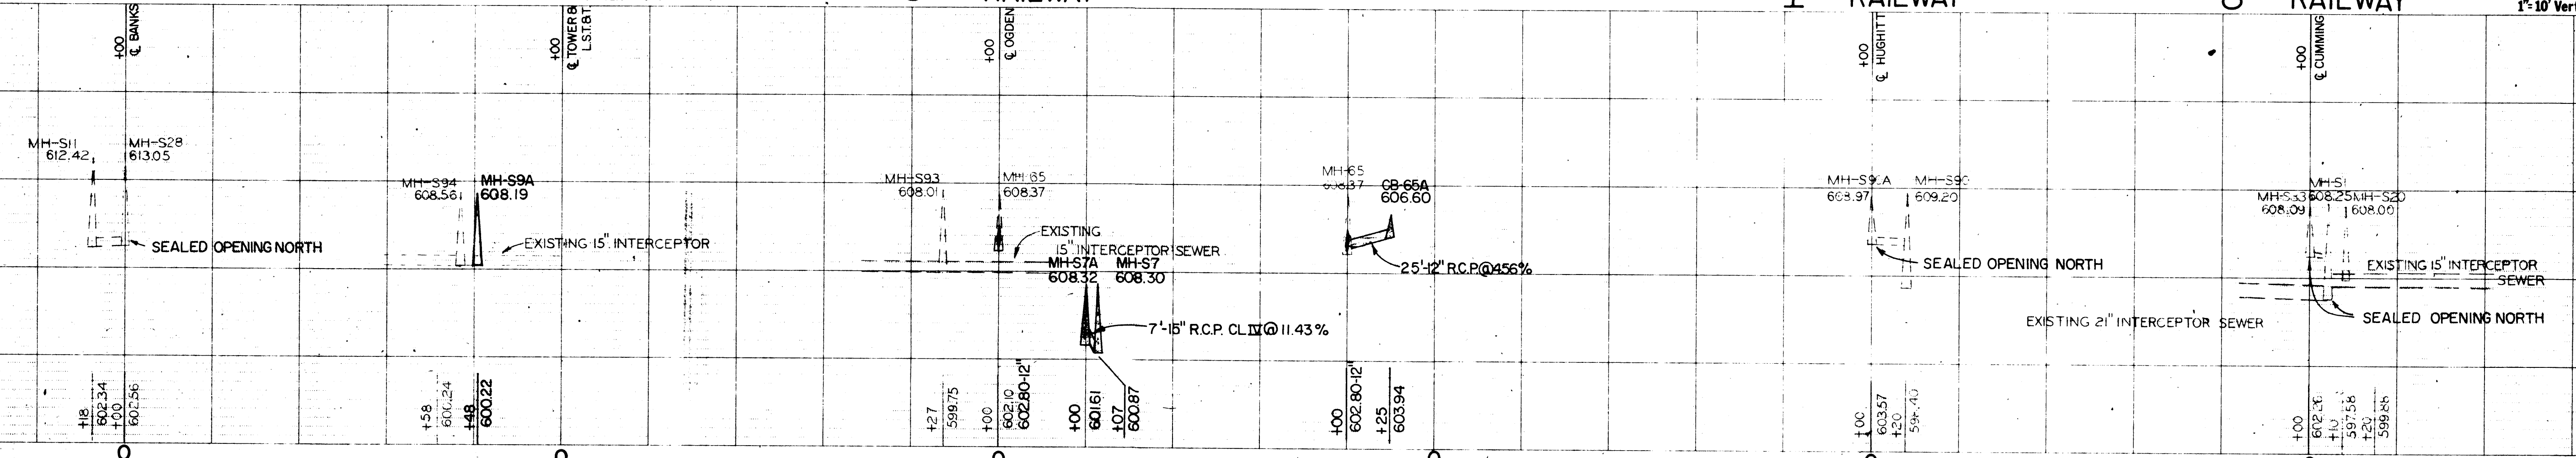


B.M. 61636
Top Hyd.

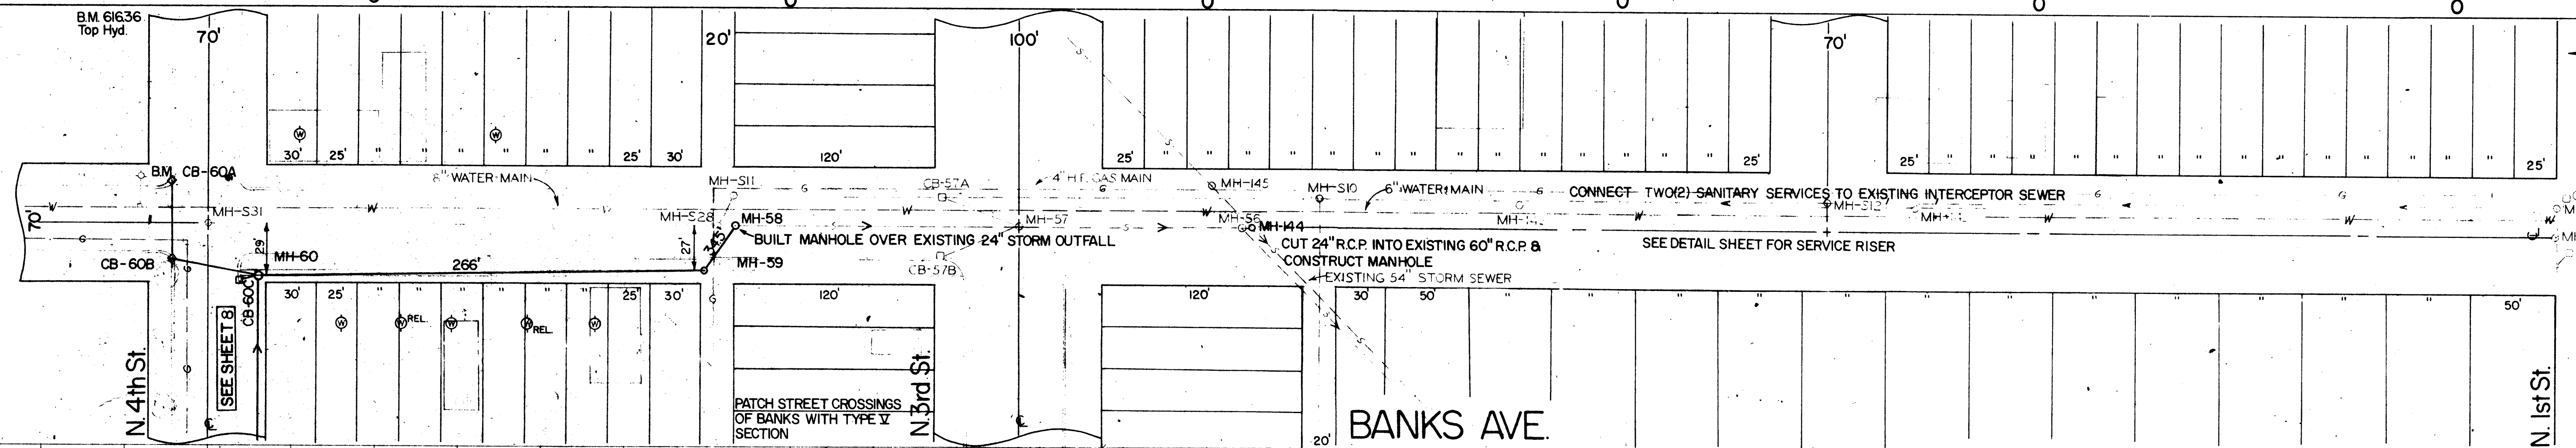

BANKS AVE.

Scale: 1"=50' Horiz.
1"=10' Vert.

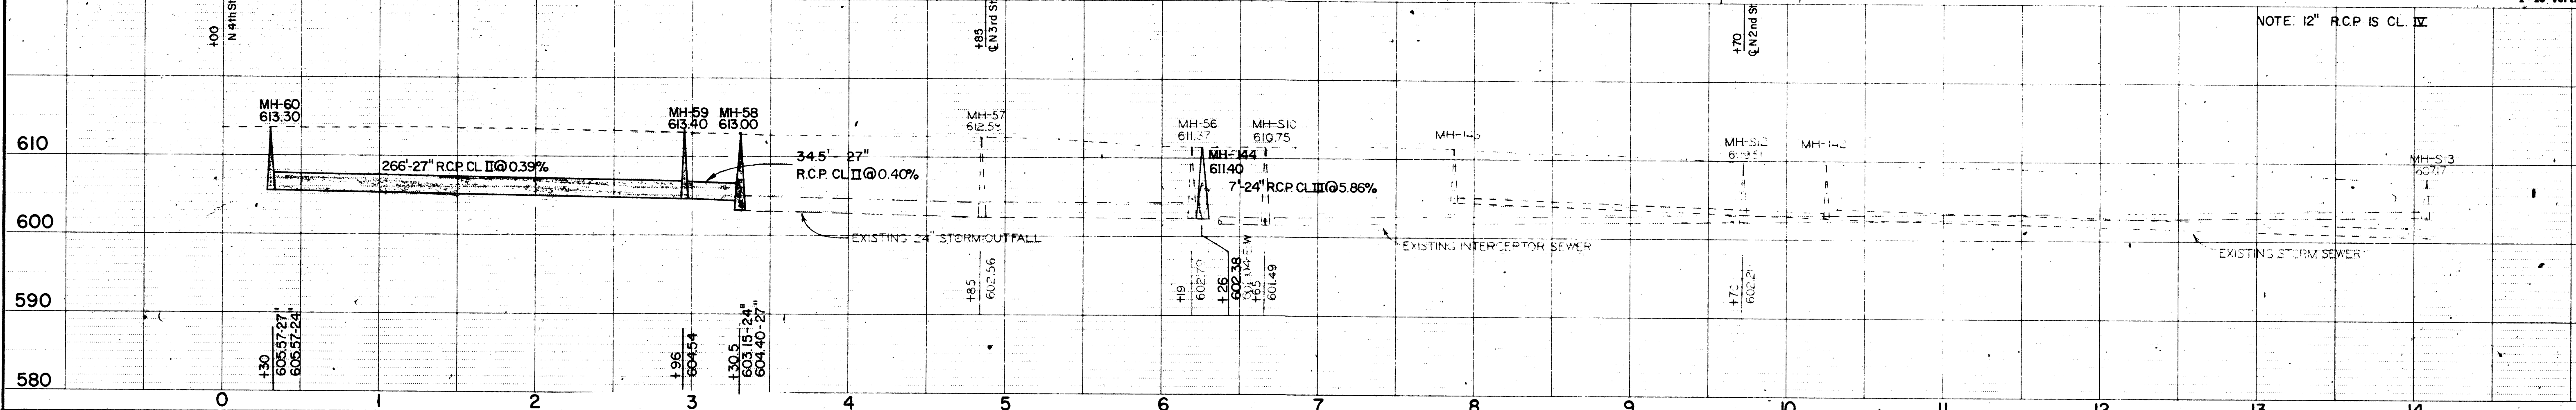

NOTE: 12" R.C.P. IS CL. II