

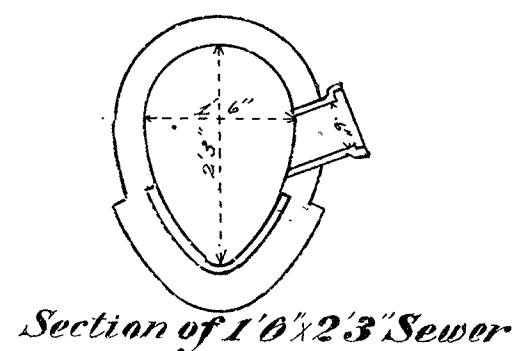
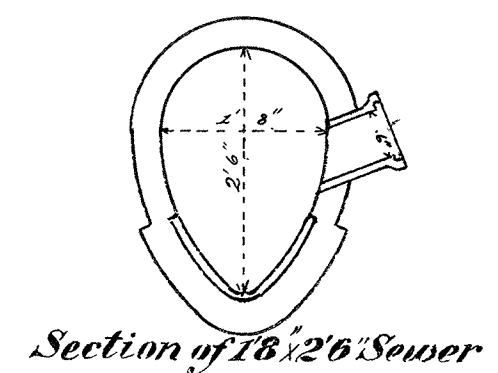


**CITY OF SUPERIOR  
SEWER PLAN**

Contract let April 16, 1891  
 completed Sept. 14, 1891  
 Joseph Wolf, Contractor  
 E. A. Henderson, Inspector  
 E. B. Banks, City Engineer

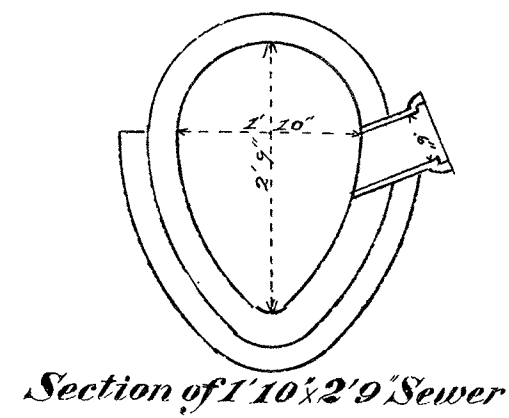

Scale { Horizontal 1 inch = 60 ft.  
 Vertical 1 " = 4 "  
 Section 1 " = 2 "

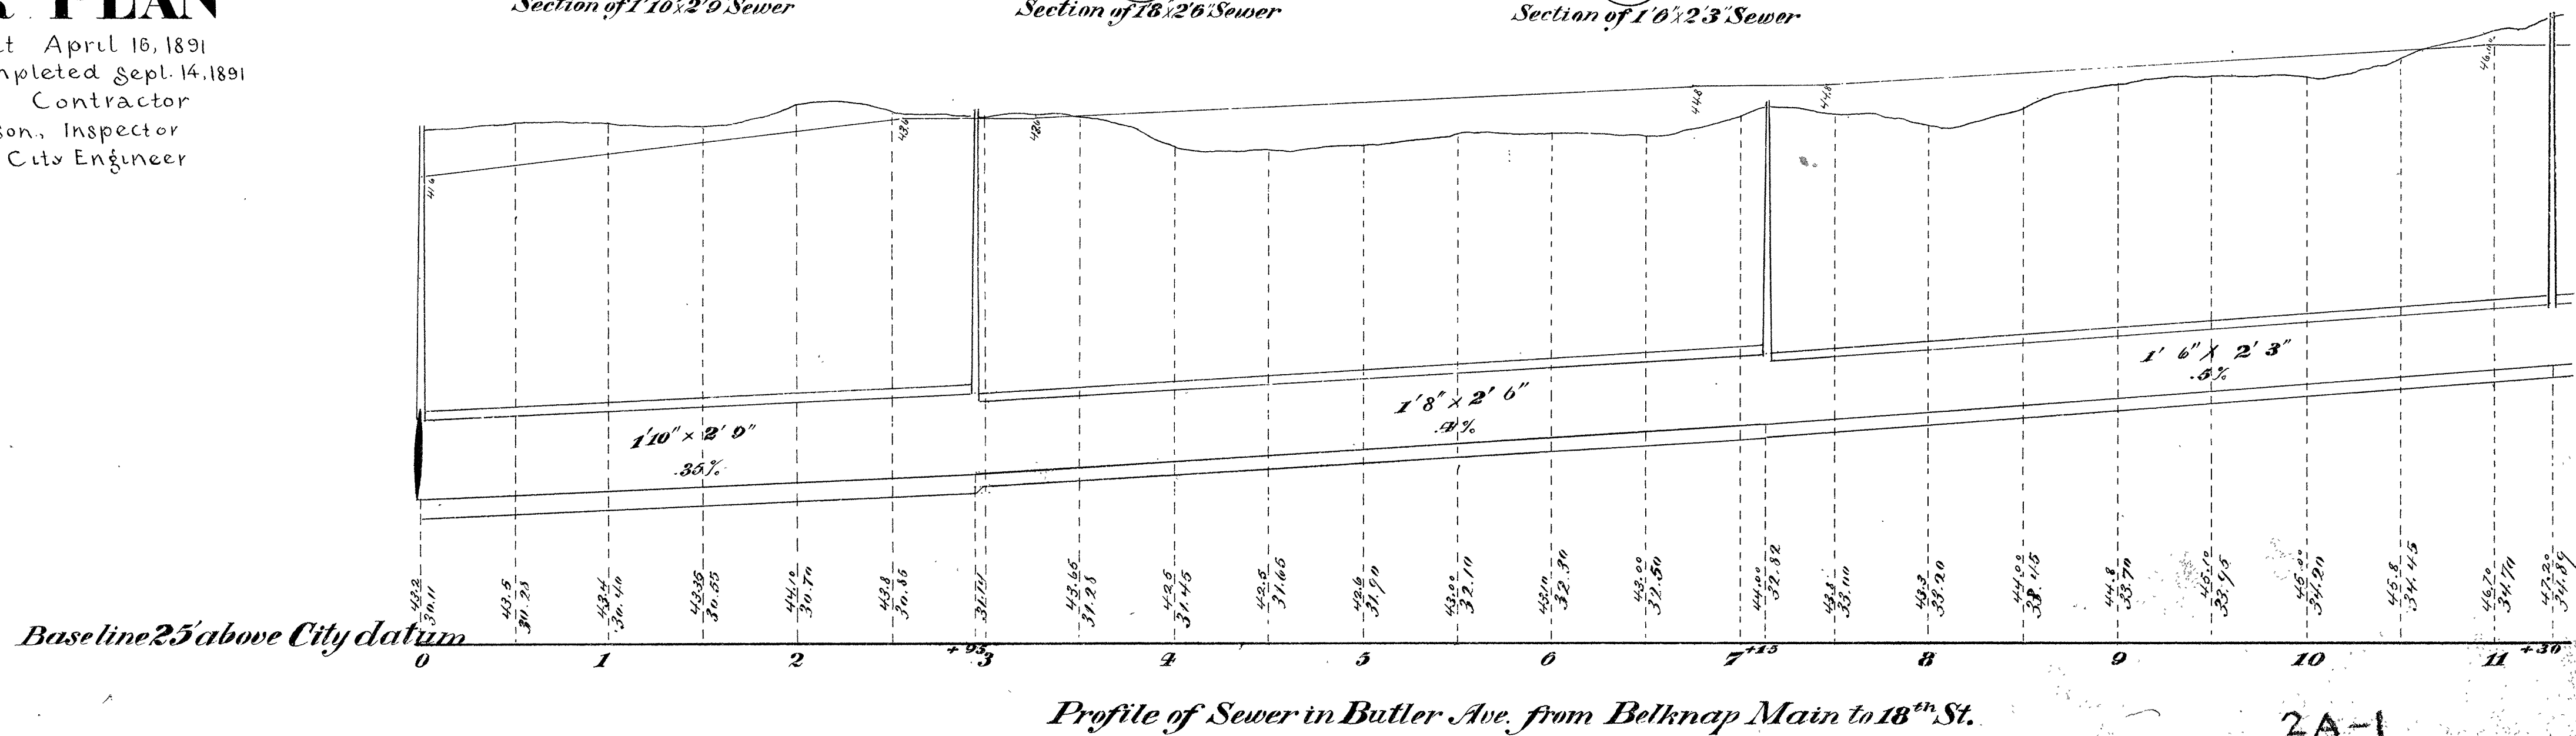

2A-1