



Note: Figures in blue, placed opposite the branches, show the elevation of the same above datum

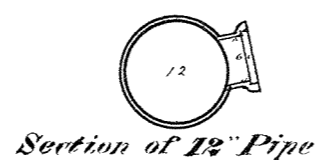

Scale: { Horizontal 1" = 60'  
Vertical 1" = 40'  
Section 1" = 2'

## CITY OF SUPERIOR SEWER PLAN

Contract let Feb. 3, 1888  
completed  
Youngren & Gleason, Contractor  
Frank Grace, Inspector  
E.B. Banks City Engineer

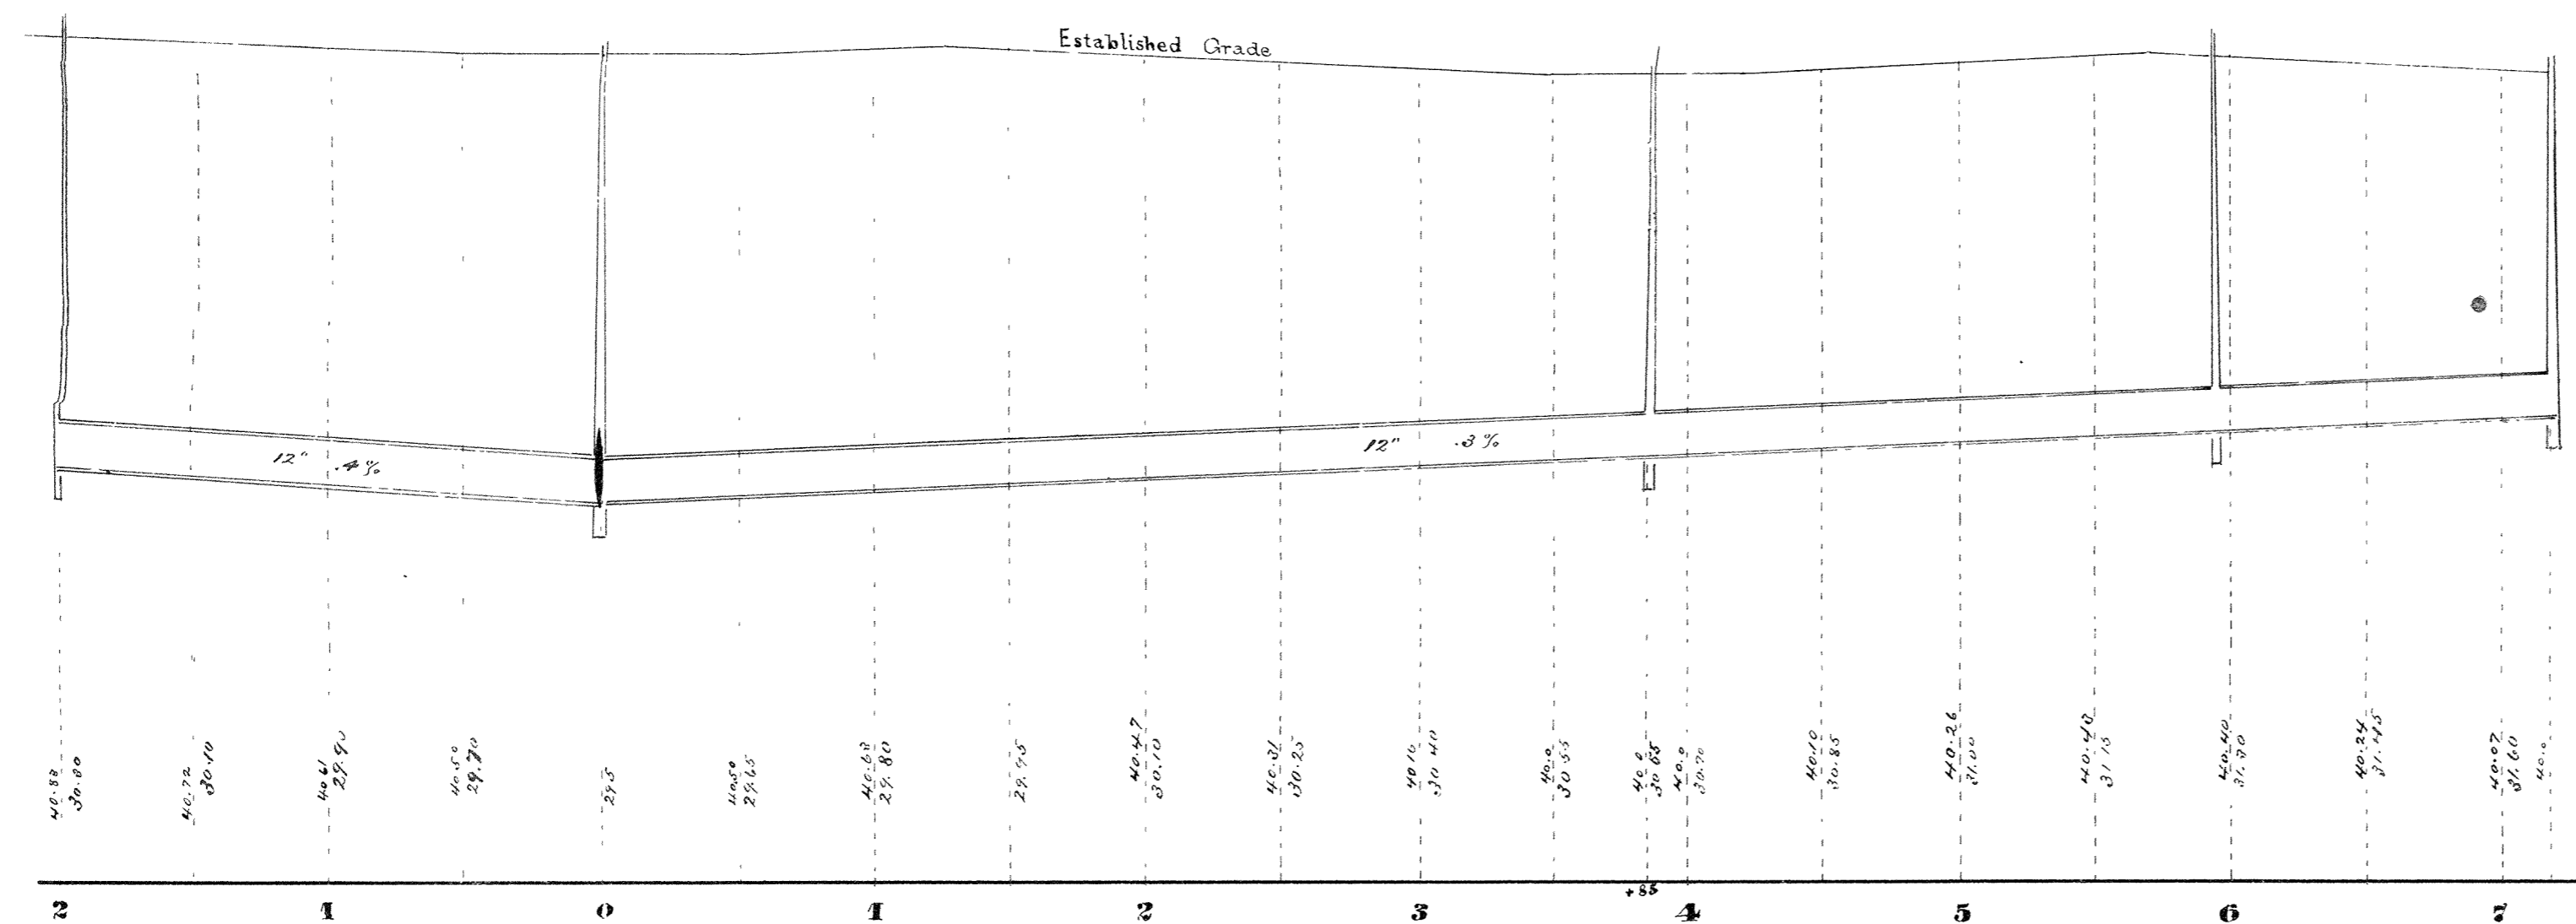

Plan & Profile of Sewer in Belknap St. from 150 ft. West of Tower Ave. to John Ave.

Base line 20 ft. above City datum

2A-17