



**CITY OF SUPERIOR
SEWER PLAN**

Contract let April 3, 1891
 completed Aug. 20, 1891
 Joseph Wolf Contractor
 J. H. Little, M. Conroy, I. J. Cummins, Insps.
 E. B. Banks City Engineer

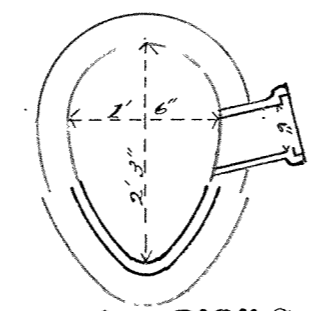

Section of 18" x 27" Sewer

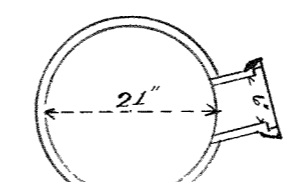

Section of 21" pipe

Scale { Horizontal 1 inch = 60 ft.
 Vertical 1" = 4'
 Section 1" = 2"

