



Note: No connections reported for lots 21, 22, 23 & 24, Block 100.

**CITY OF SUPERIOR
SEWER PLAN**


Contract let June 13, 1890
completed Aug. 11, 1891
D. C. Sullivan, Contractor
John Dailey, F. A. Grace, Inspectors
E. B. Banks, City Engineer

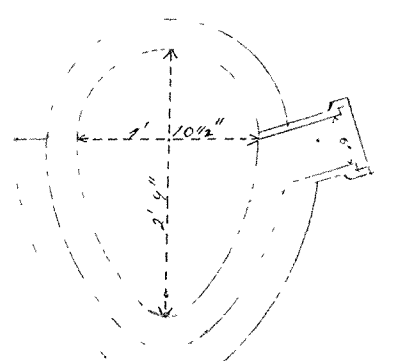

Section of 10x20 Sewer

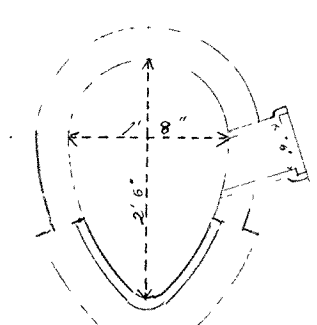


Section of 18x26 Sewer

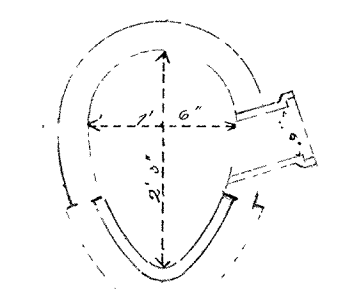

Section of 16x23 Sewer

Scale { Horizontal 1 inch = 60 ft.
Vertical 1 " = 4 "
Sectional 1 " = 2 "

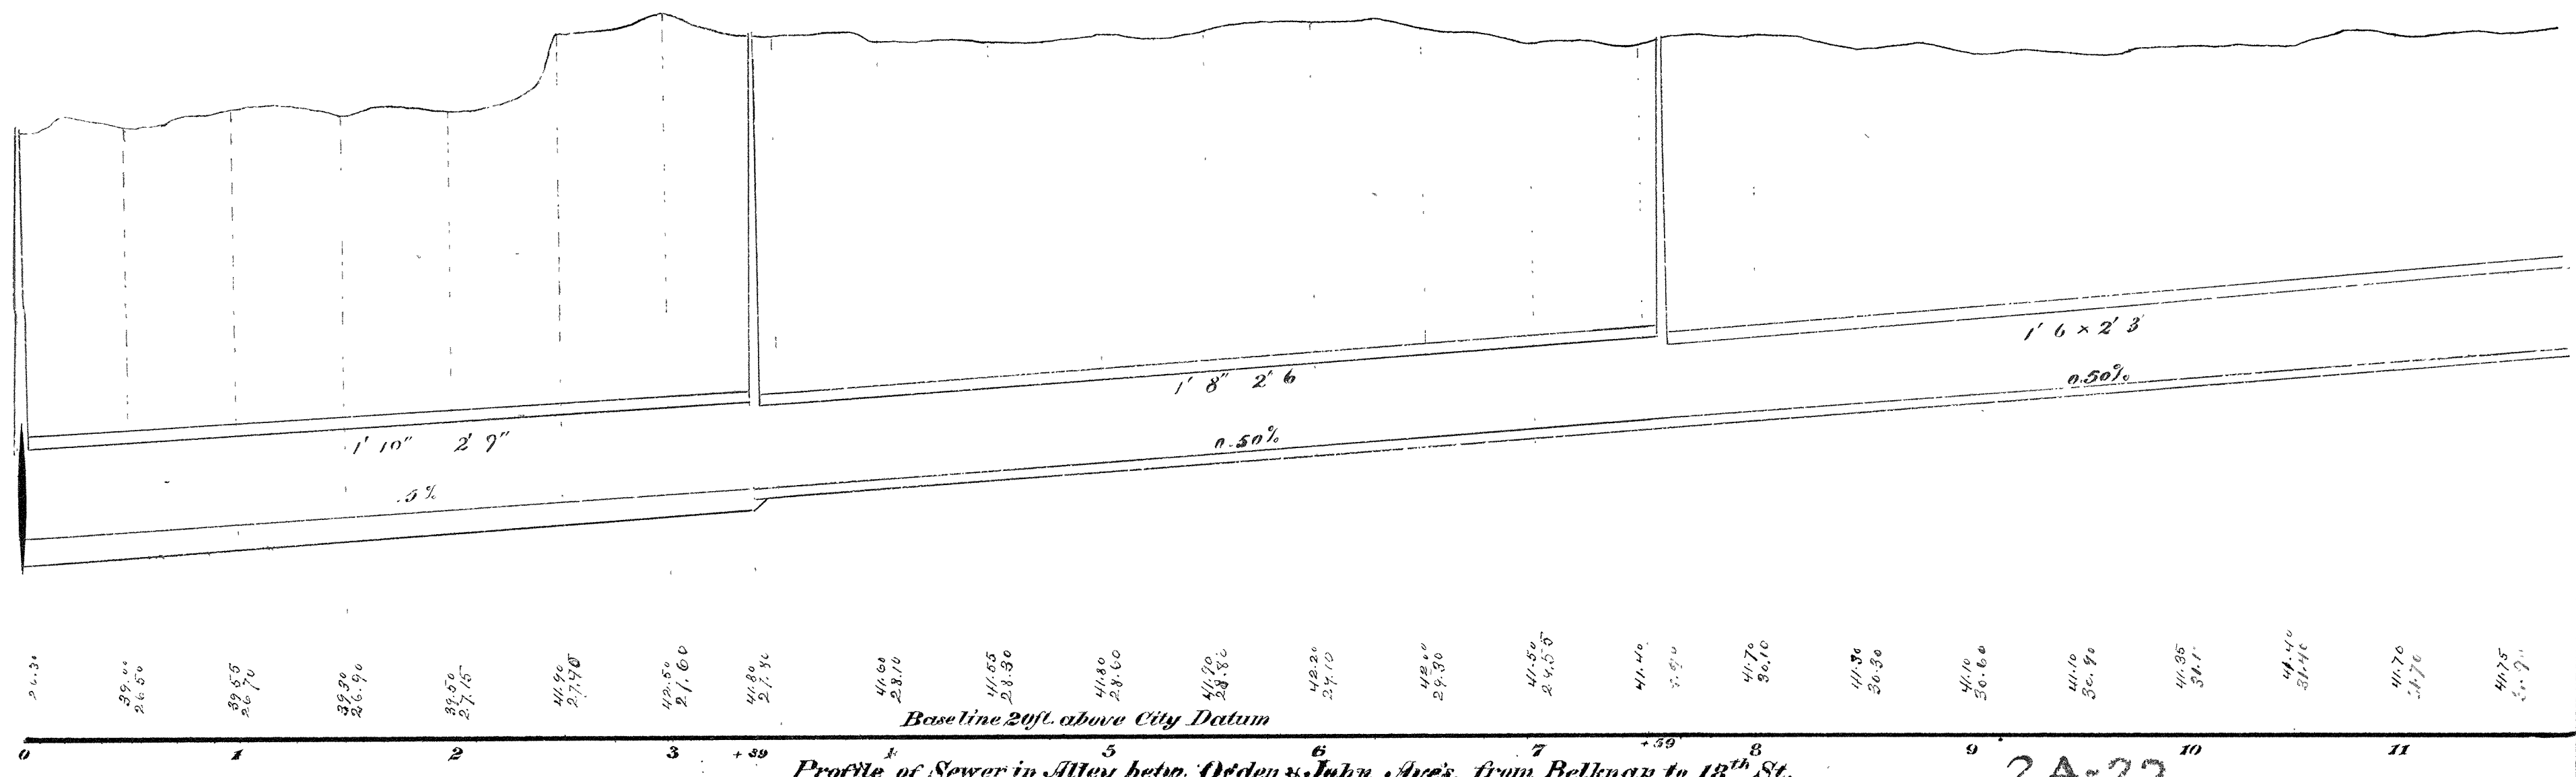

Profile of Sewer in Alley betw. Ogden & John Ave's. from Belknap to 18th St. 2A-22