



**CITY OF SUPERIOR
SEWER PLAN**

Contract let June 13, 1890.
completed Aug. 11, 1891
D.C. Sullivan, Contractor
F.A. Grace, W.R. Russell, A.G. Earnshaw, Inspls.
E.B. Banks, City Engineer.


Scale Horizontal 1 inch = 60 ft.
Vertical 1 " = 4 "
Sectional 1 " = 2 "

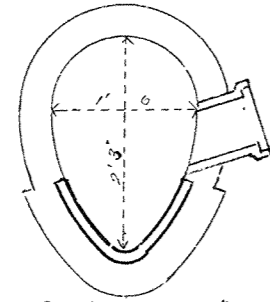


Section of 16x23 Sewer.

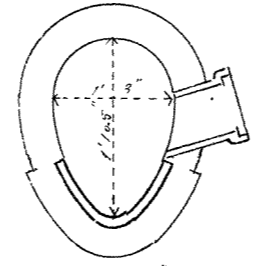


Section of 13x10.5 Sewer

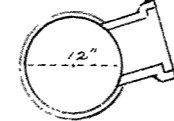

Section of 12 Pipe

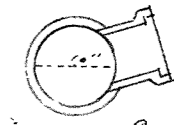

Section of 10 Pipe

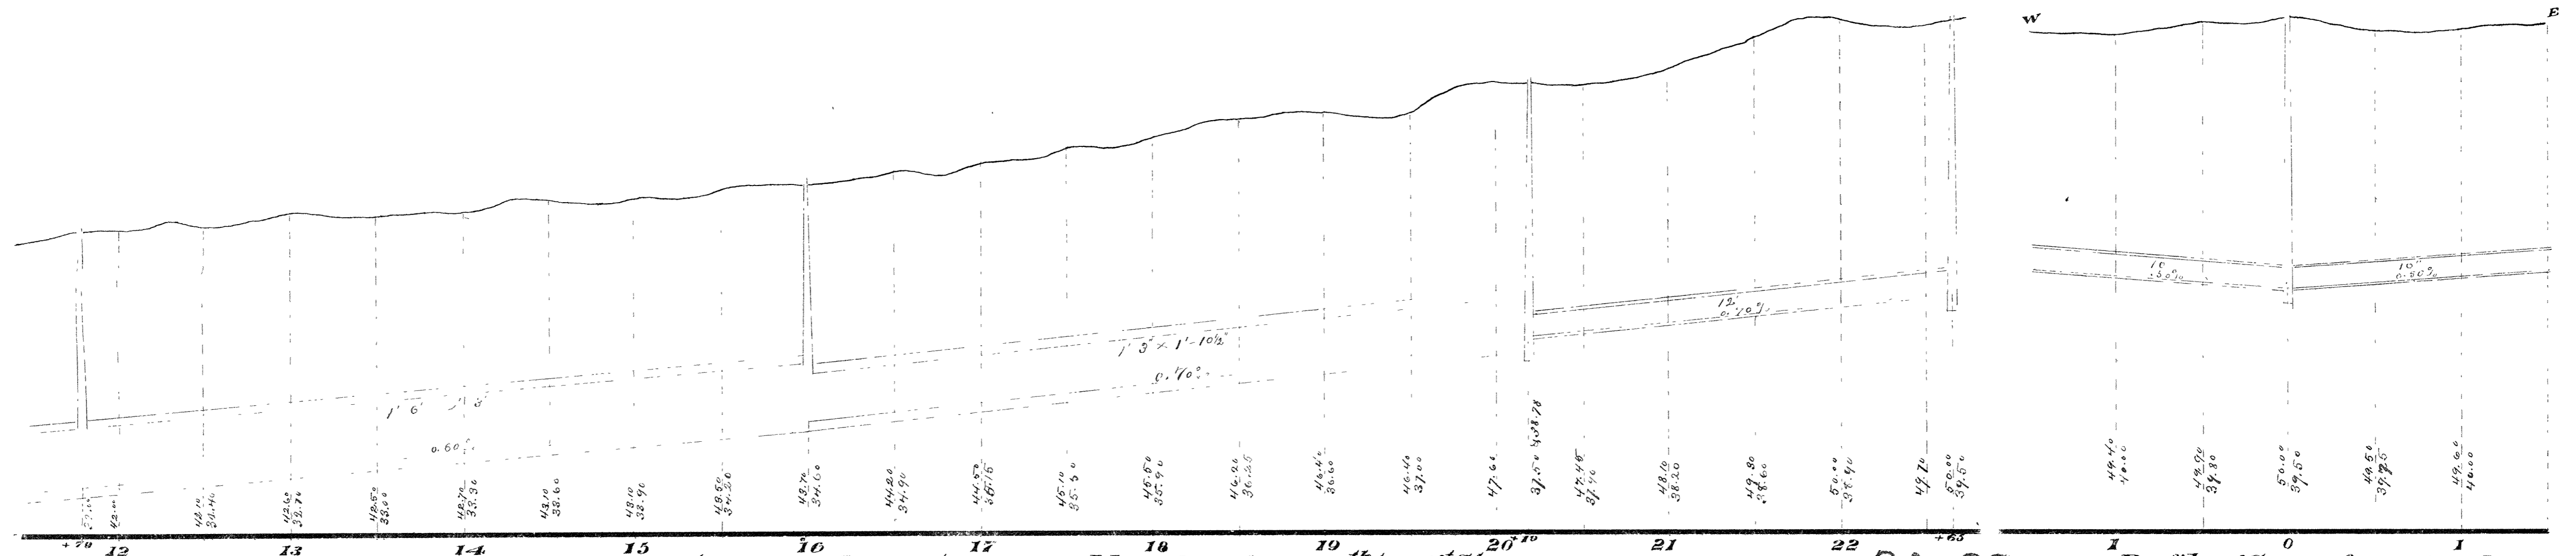

Note: Baseline 39ft. above City datum

Profile of Sewer in Alley betw. Ogden & John Aves. from 18th to 21st St.

2A-23

Profile of Sewer from A to B