



**CITY OF SUPERIOR
SEWER PLAN**

Contract let April 13, 1891
 Completed Aug. 20, 1891
 Joseph Wolf, Contractor
 J. H. Little & T. A. King, Inspectors
 E. B. Banks, City Engineer

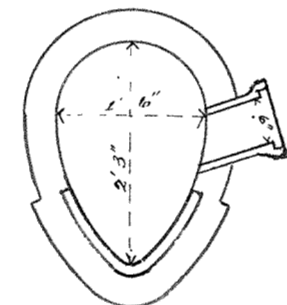


Section of 16x23" Sewer

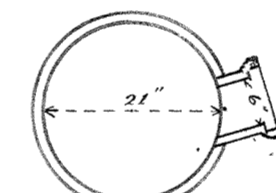

Section of 21 inch pipe

Scale: { Horizontal 1 inch = 60 ft.
 Vertical 1" = 4"
 Section 1" = 2"

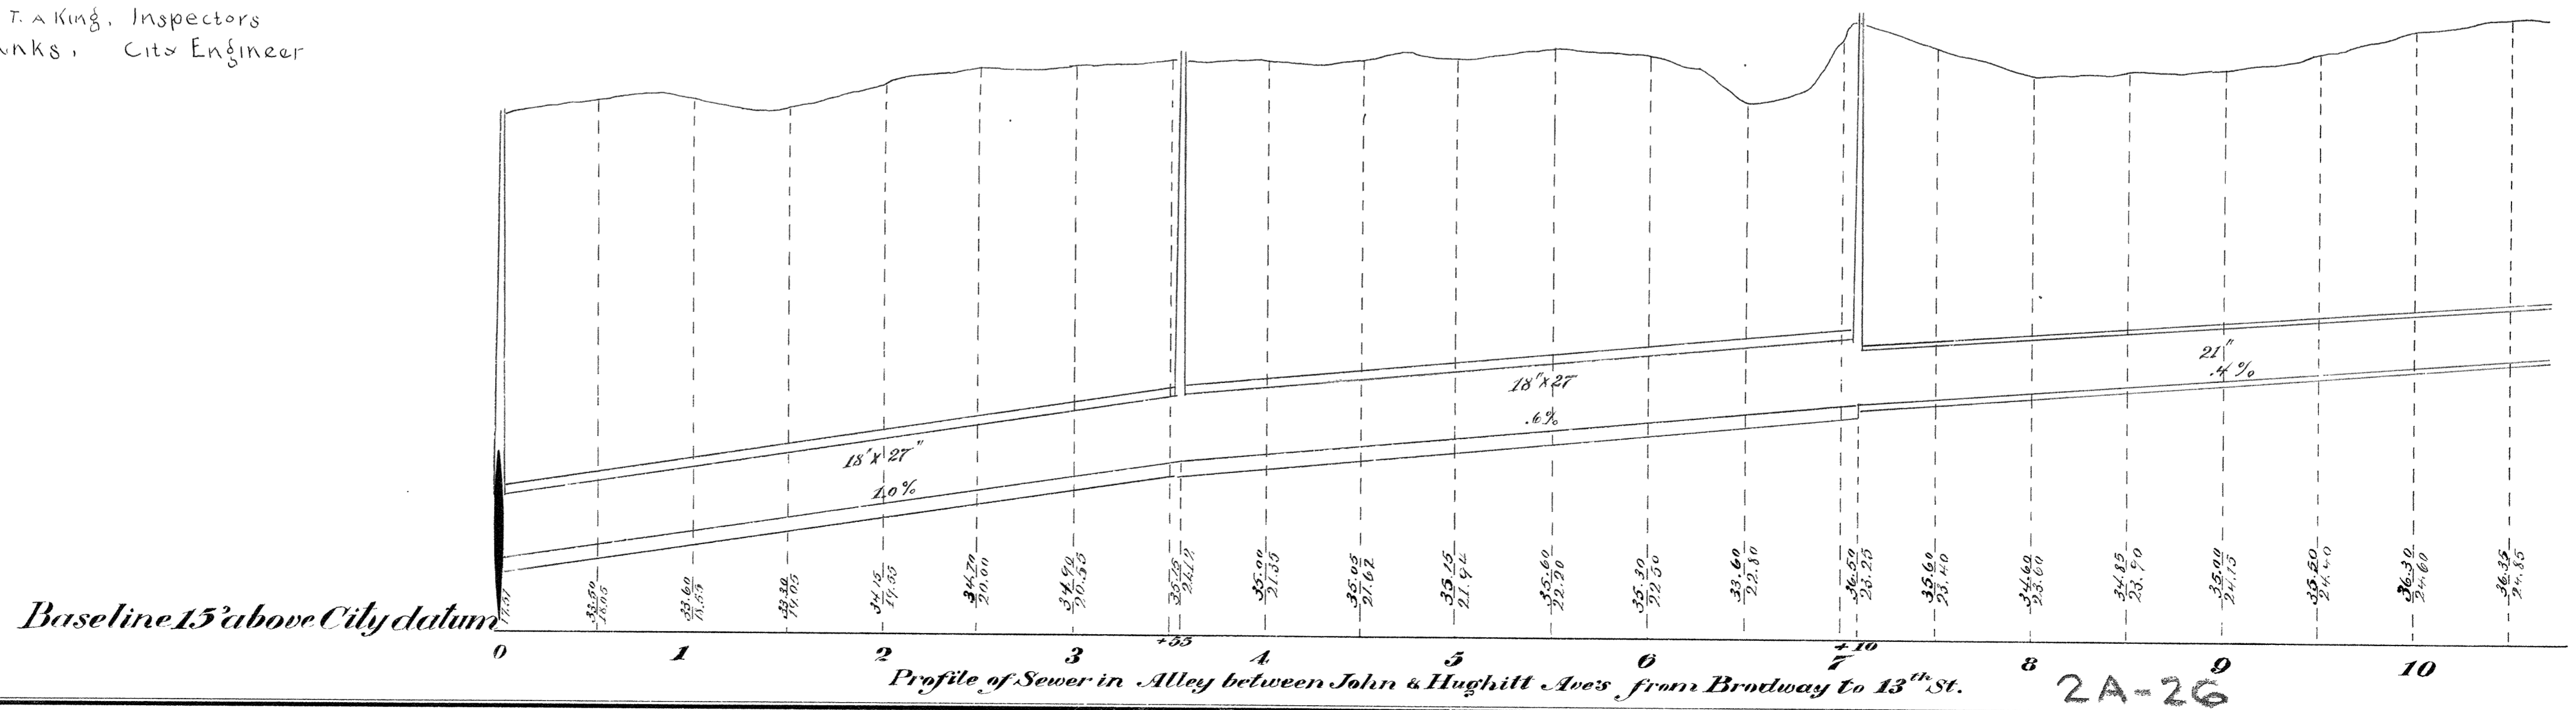

2A-26