



BELKNAP

ST.

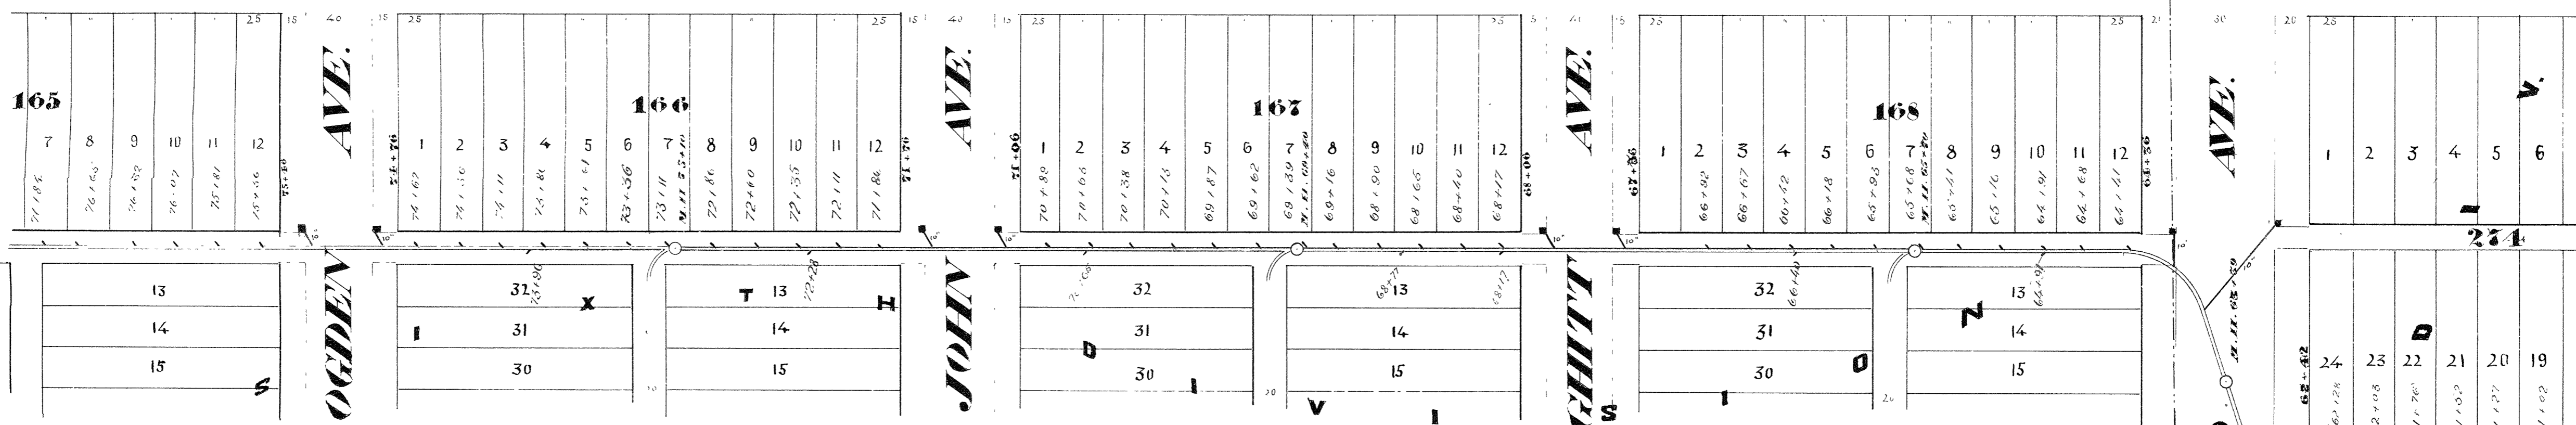


**CITY OF SUPERIOR
SEWER PLAN
1894**


Contract let June 15, 1890
 copld. June 1, 1891
 Kirkland & Starkey, Contr.
 John Dalley, Inspector
 E. B. Banks, City Engr.

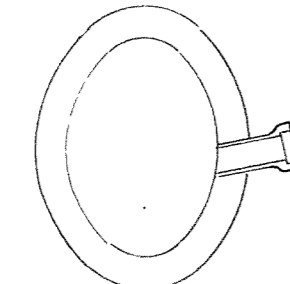


Section of 3'0" x 4'6" Sewer

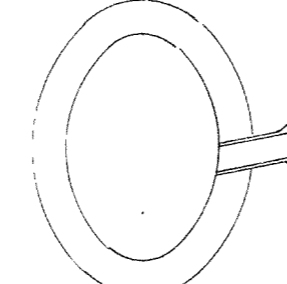

Section of 3'2" x 4'9" Sewer

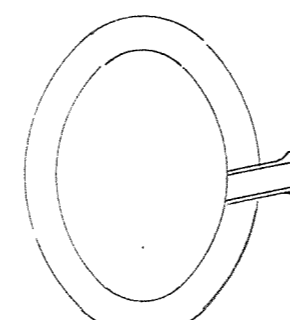


Section of 3'6" x 5'5" Sewer

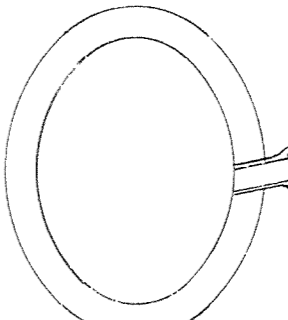

Section of 3'11" x 5'6" Sewer

Scale { Horizontal 60'-1"
 Vertical 4'-1"
 Section 4'-1"

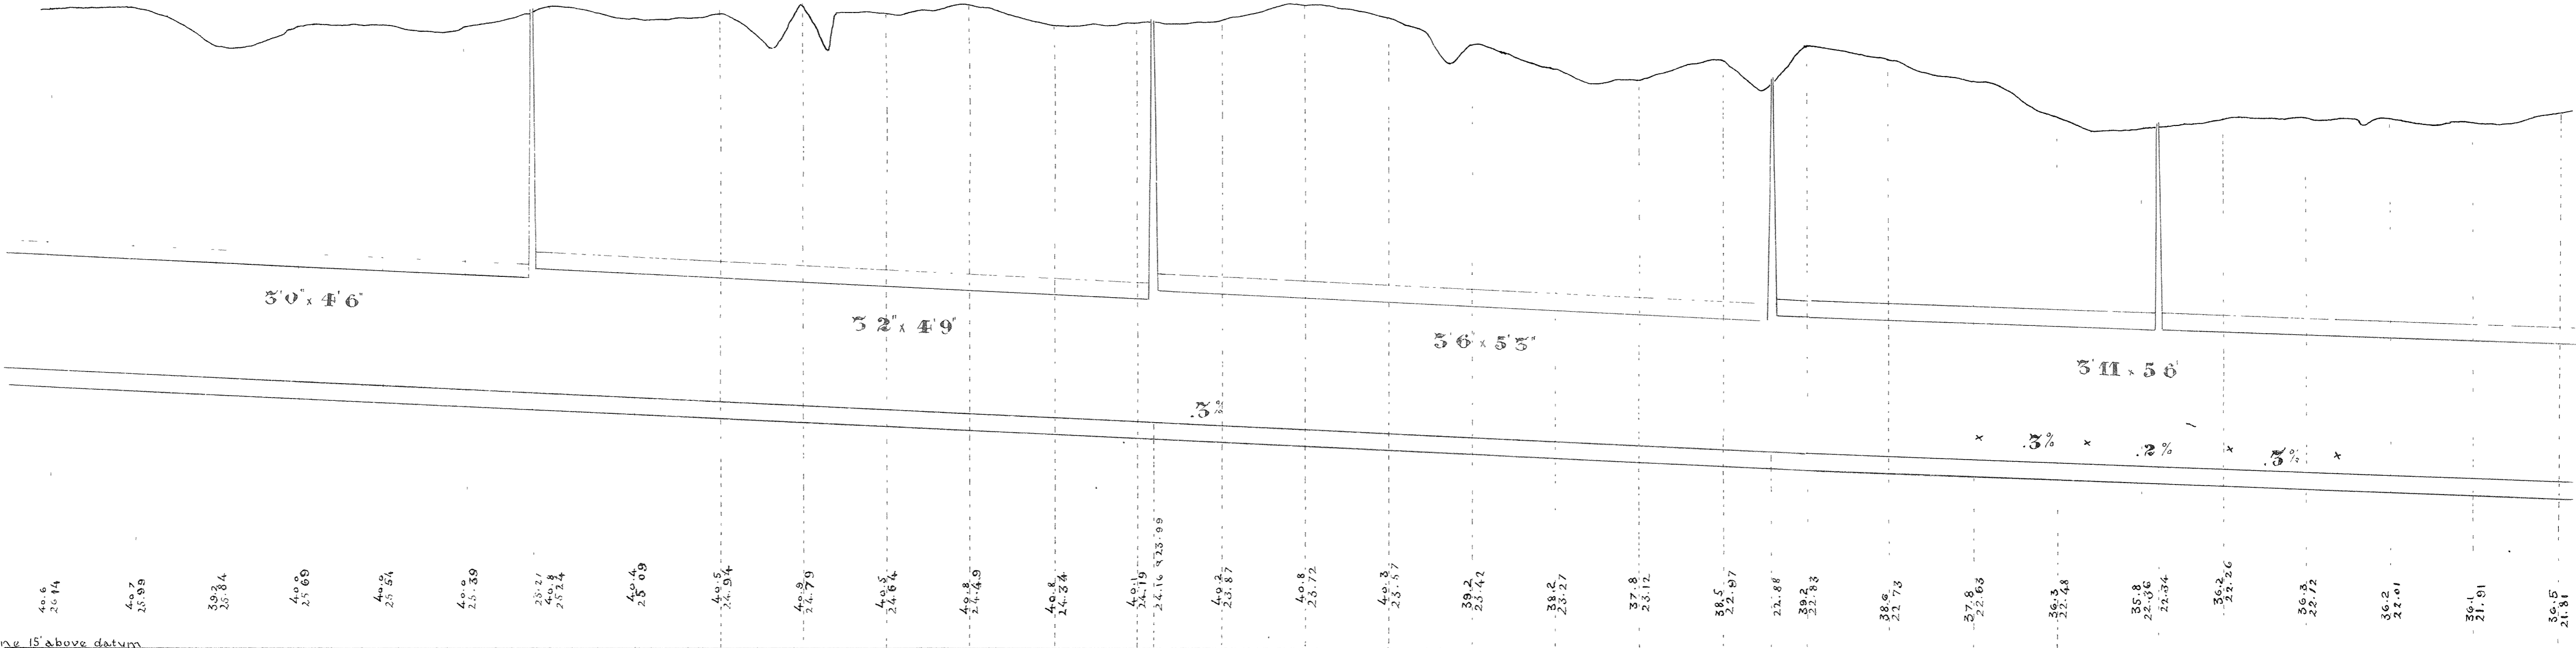

Plan & Profile of Sewer in Alley South of Belknap St. from Hammond Ave. to Alley betw. Ogden & Tower Aves.

2A-32