
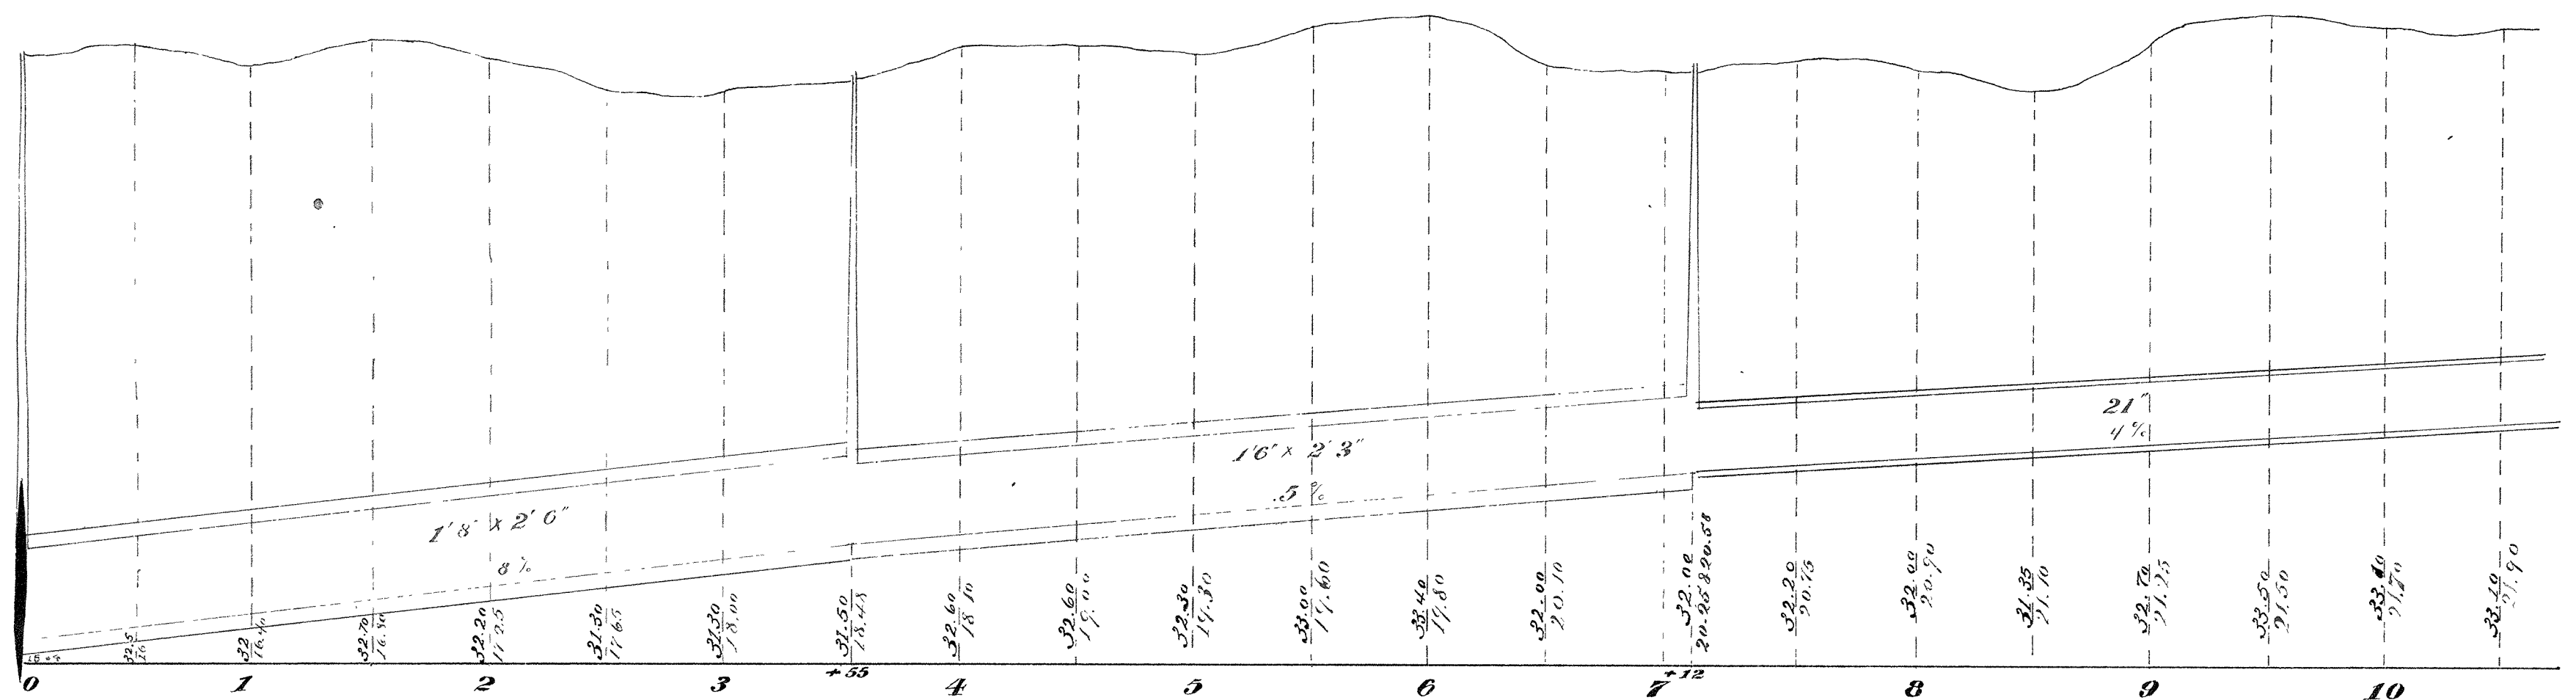
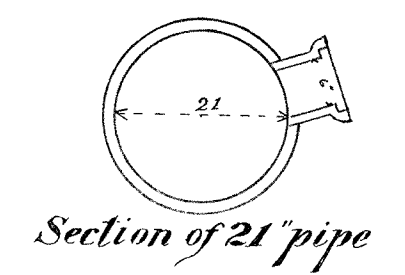
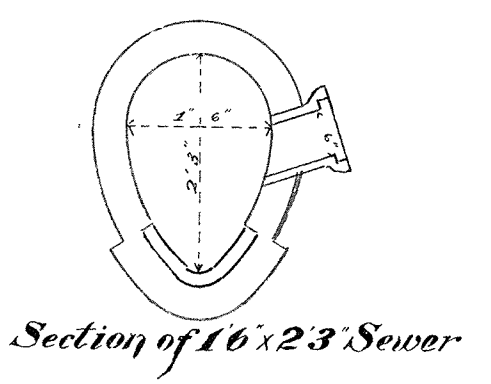


**CITY OF SUPERIOR  
SEWER PLAN**

Contract let April 3, 1891  
 " completed Aug. 20, 1891  
 Joseph Wolf, Contractor  
 Sam Sturgeon & Finlay Mc Kinzie, Inspl.  
 E. B. Banks, City Engineer

Scale: { Horizontal 1 inch = 60 ft.  
 Vertical 1" = 4"  
 Section 1" = 2"

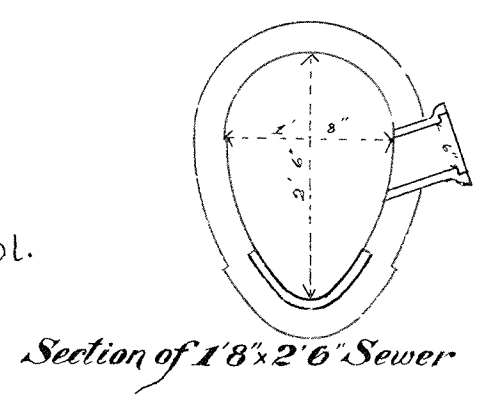

Base line 15' above City datum

Profile of Sewer in Alley below Hammond & Cumming Ave's from Broadway to 13th St.

2A-35