


1892

Note: Connections, left out, are not reported


**CITY OF SUPERIOR
SEWER PLAN**

Contract let May 26, 1890
 completed July 1, 1891
 Kirkland & Starkev, Contractor
 A. G. Earnshaw, Inspector
 E. B. Banks, City Engineer

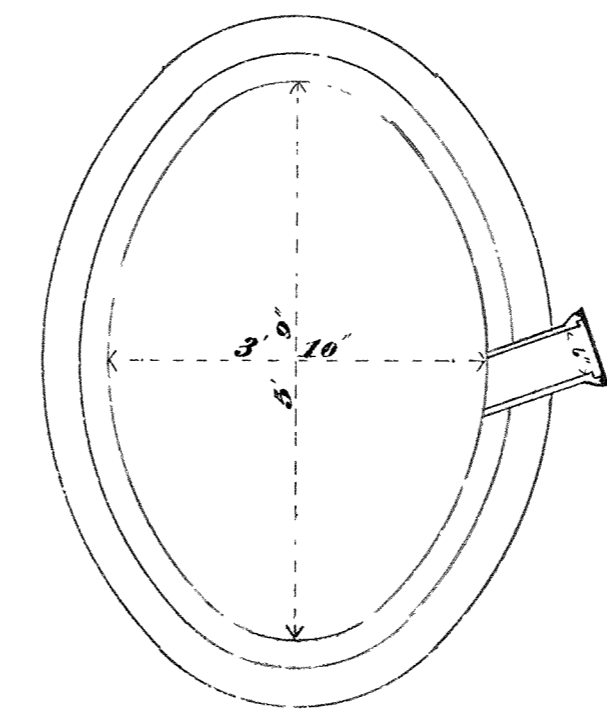

Section of 3'10" x 5'9" Sewer

Scale { Horizontal Inch = 60ft.
 Vertical 1" = 4"
 Section 1" = 2"

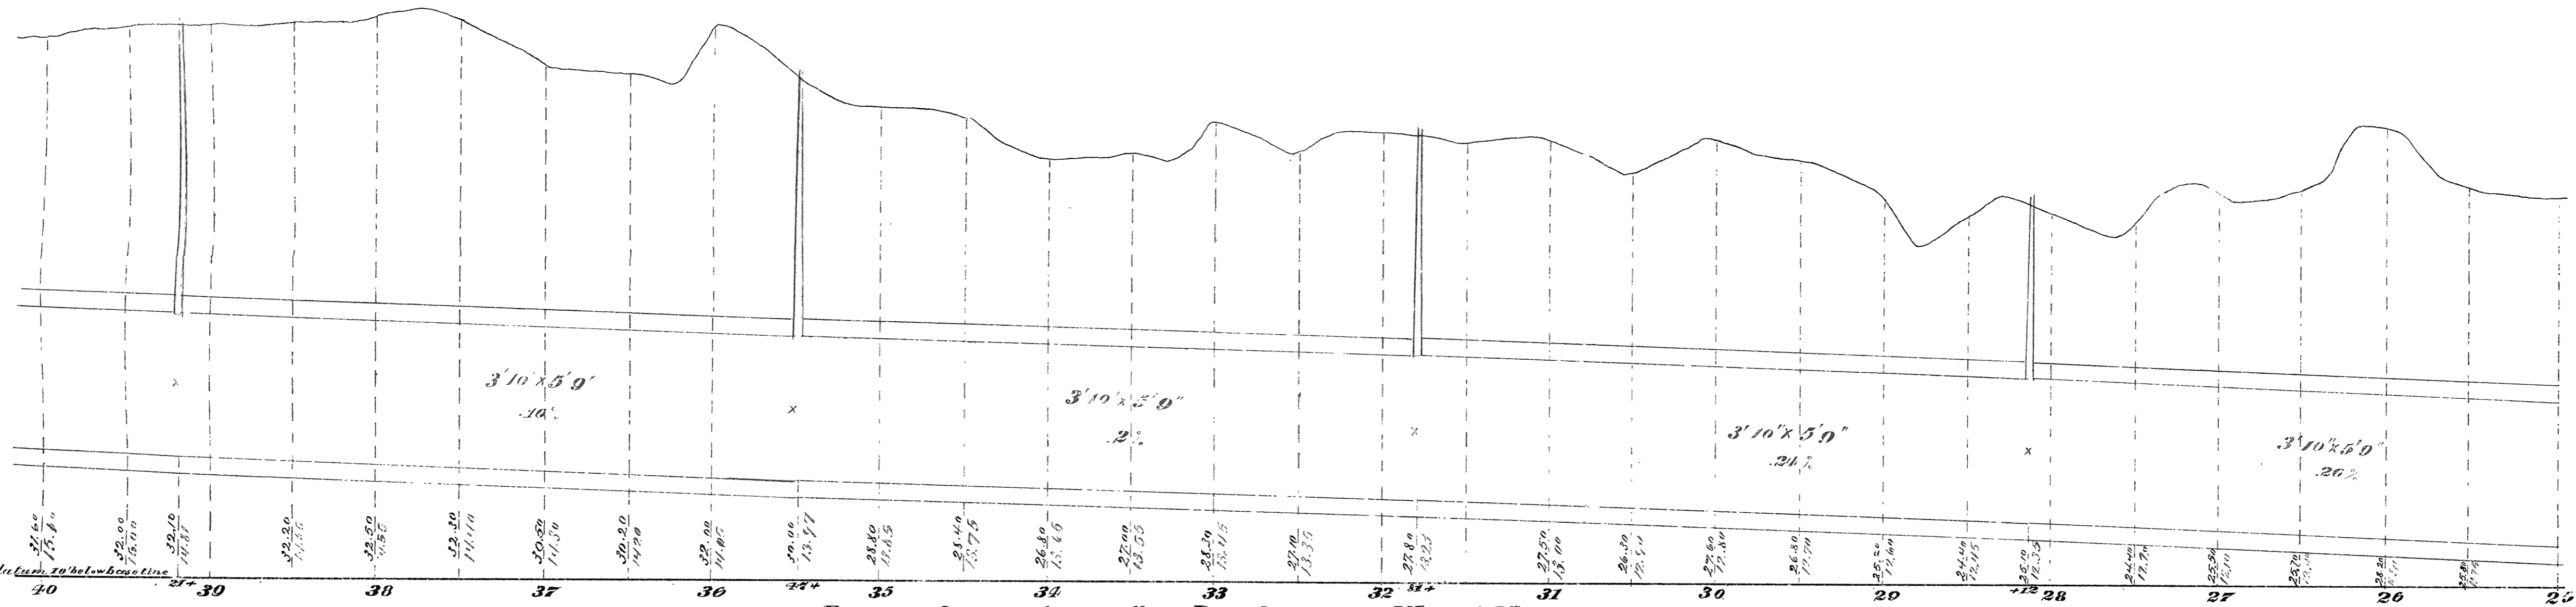

Profile of Sewer in Alley south of Broadway from Weeks to Hammond Ave.

2A-39