



CITY OF SUPERIOR SEWER PLAN

Contract let April 3, 1891
 completed Aug. 20, 1891
 Joseph Wolf, Contractor
 P. J. McHugh, Inspector
 E. B. Banks, City Engineer

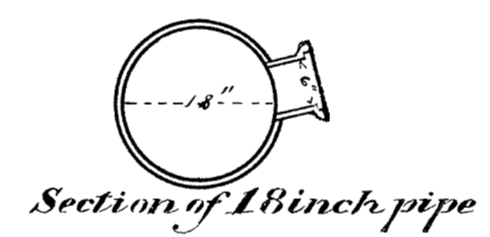

Scale: { Horizontal 1 inch = 60 ft.
 Vertical 1 " = 4 "
 Section 1 " = 2 "

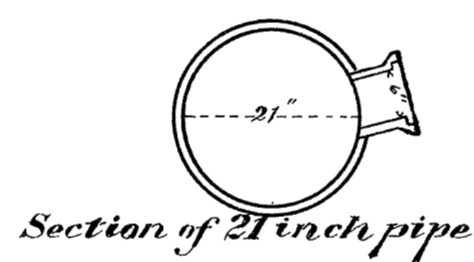