



### CITY OF SUPERIOR SEWER PLAN


Contract let October 23<sup>rd</sup> 1899  
 " completed December 9<sup>th</sup> 1899  
 L.E. Scoon & Co. Contractors  
 William Silver Inspector  
 A.T. Thomas City Engineer

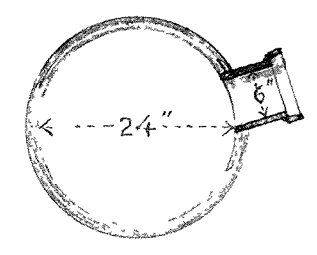

Section of 24" pipe

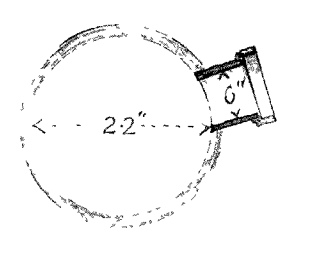


Section of 22" pipe

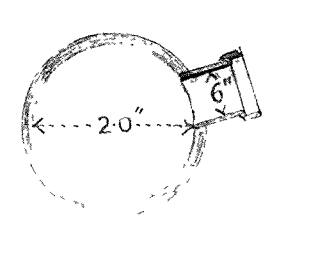

Section of 20" pipe

Scale { Horizontal 1" = 60'  
 Vertical 1" = 4'  
 Sections 1" = 2'

Base line 10' above City Datum

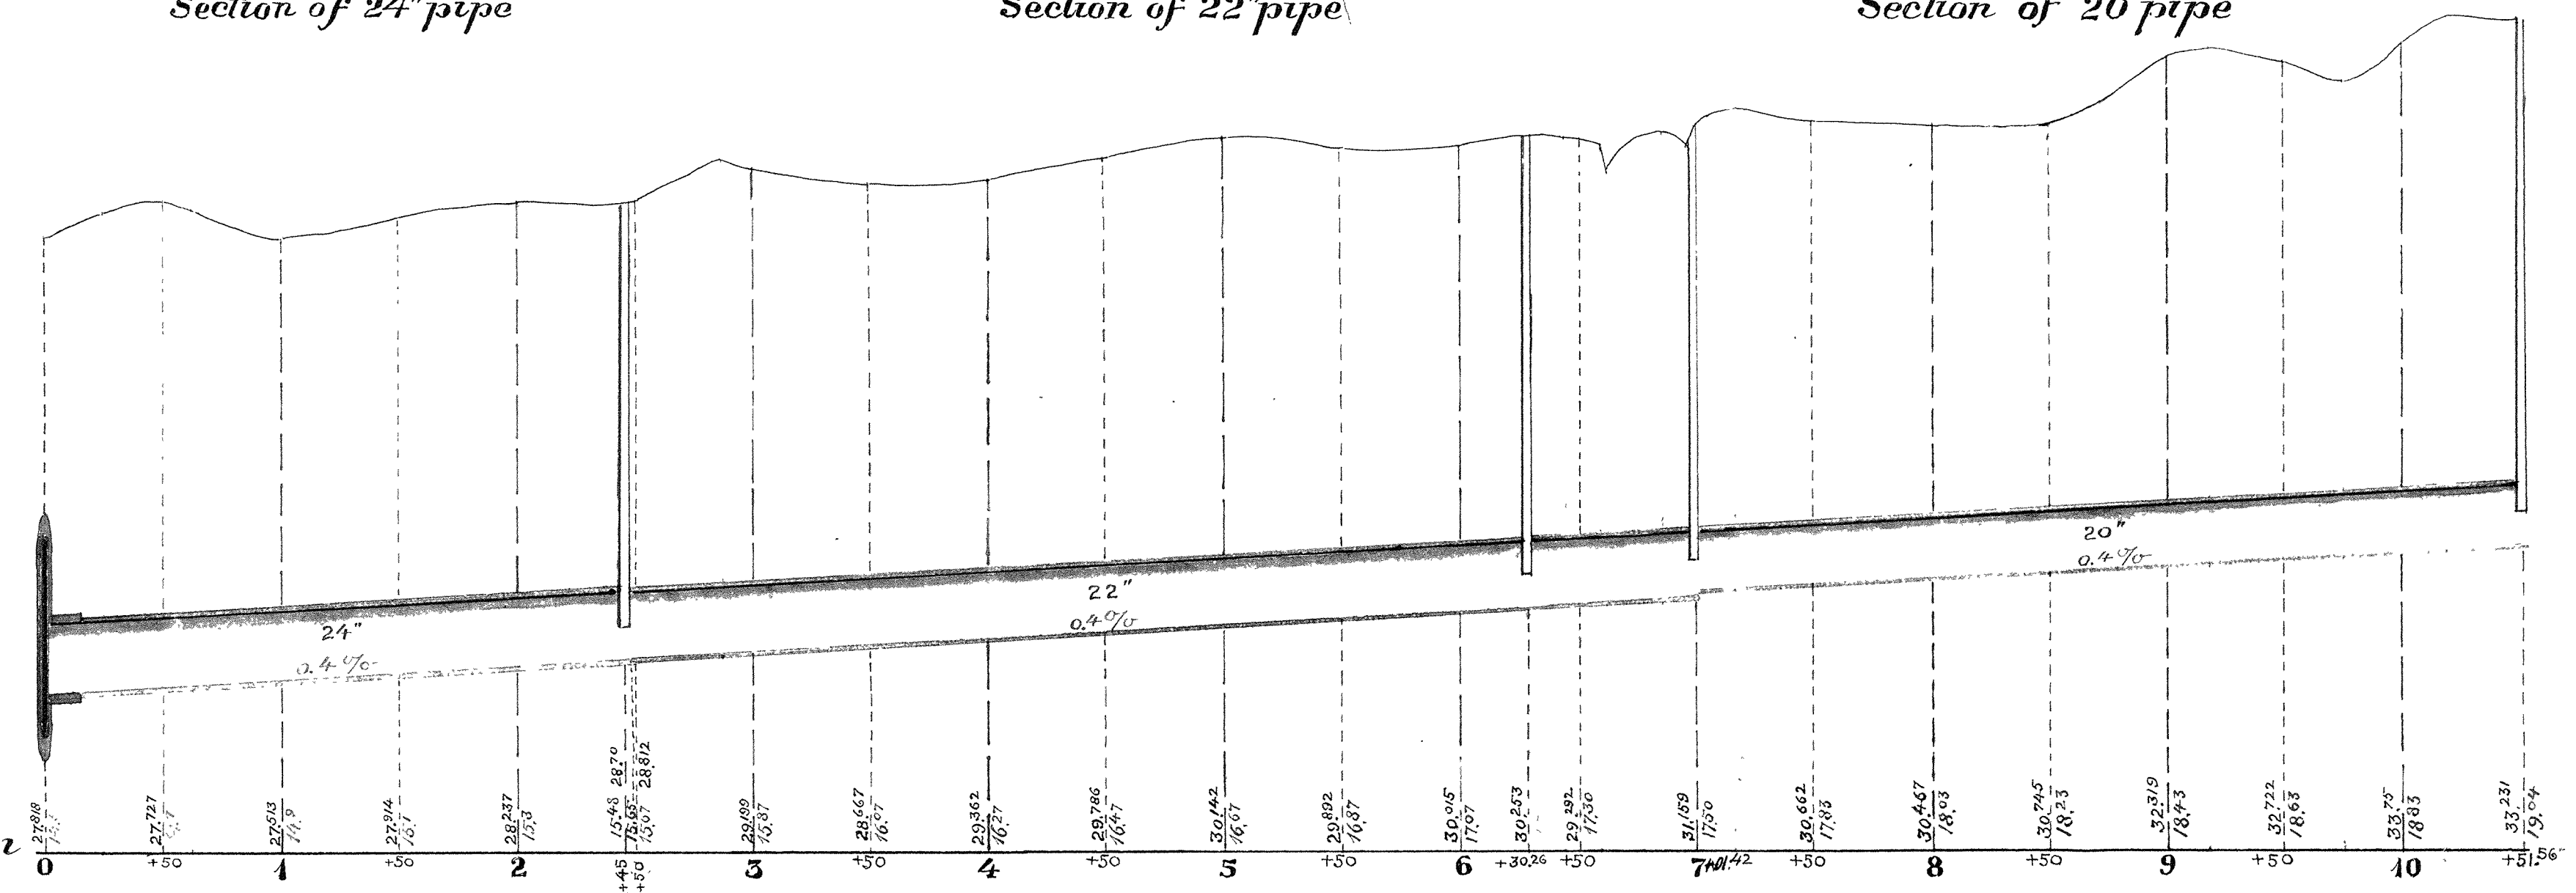

Profile of Sewer in Alley betw. Baxter & Grand Ave's from Alley south of Broadway to 13th St.

2B-45