


SECTION OF 8" PIPE

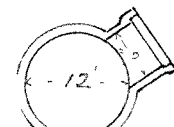

SECTION OF 12" PIPE




SECTION OF 18" PIPE

SCALE: { HORIZONTAL 1" = 60 FT
 VERTICAL 1" = 4' "
 SECTION 1" = 2' "

1902
 CITY OF SUPERIOR
SEWER PLAN

CONTRACT LET JUNE 12TH
 COMPLETED JUL. 7TH 1902
 CONT # 681 G. SKAMSER
 CONTR
 FRANK RICHARDSON
 INSPECTOR
 HOWARD THOMAS
 CITY ENGR.

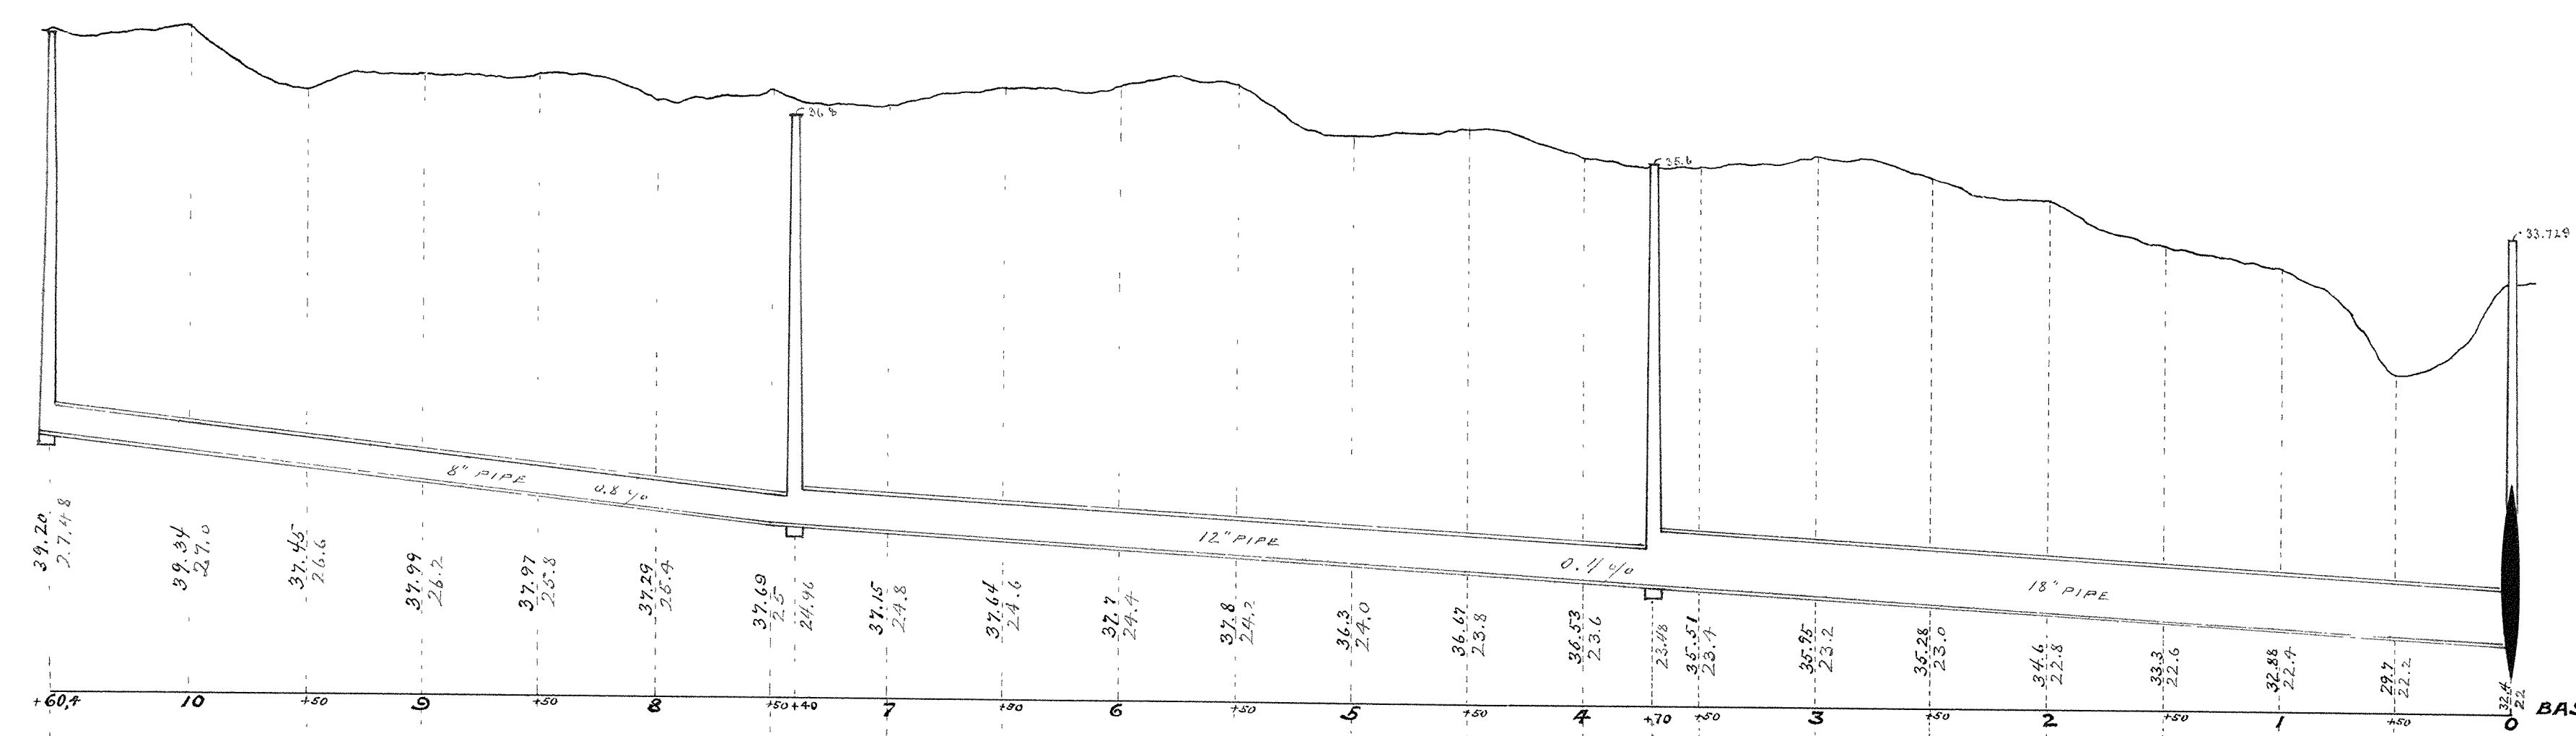

DRAWN
 BASE LINE, 20' ABOVE CITY DATUM

2B-47