


1902
**CITY OF SUPERIOR
 SEWER PLAN**


CONTRACT LET AUG. 29TH
 COMPLETED OCT. 15TH
 CONT. #698 STACK BROS
 CONTRS.
 FRANK RICHARDSON
 INSPECTOR
 HOWARD THOMAS
 CITY ENGR.



SECTION OF 15" PIPE

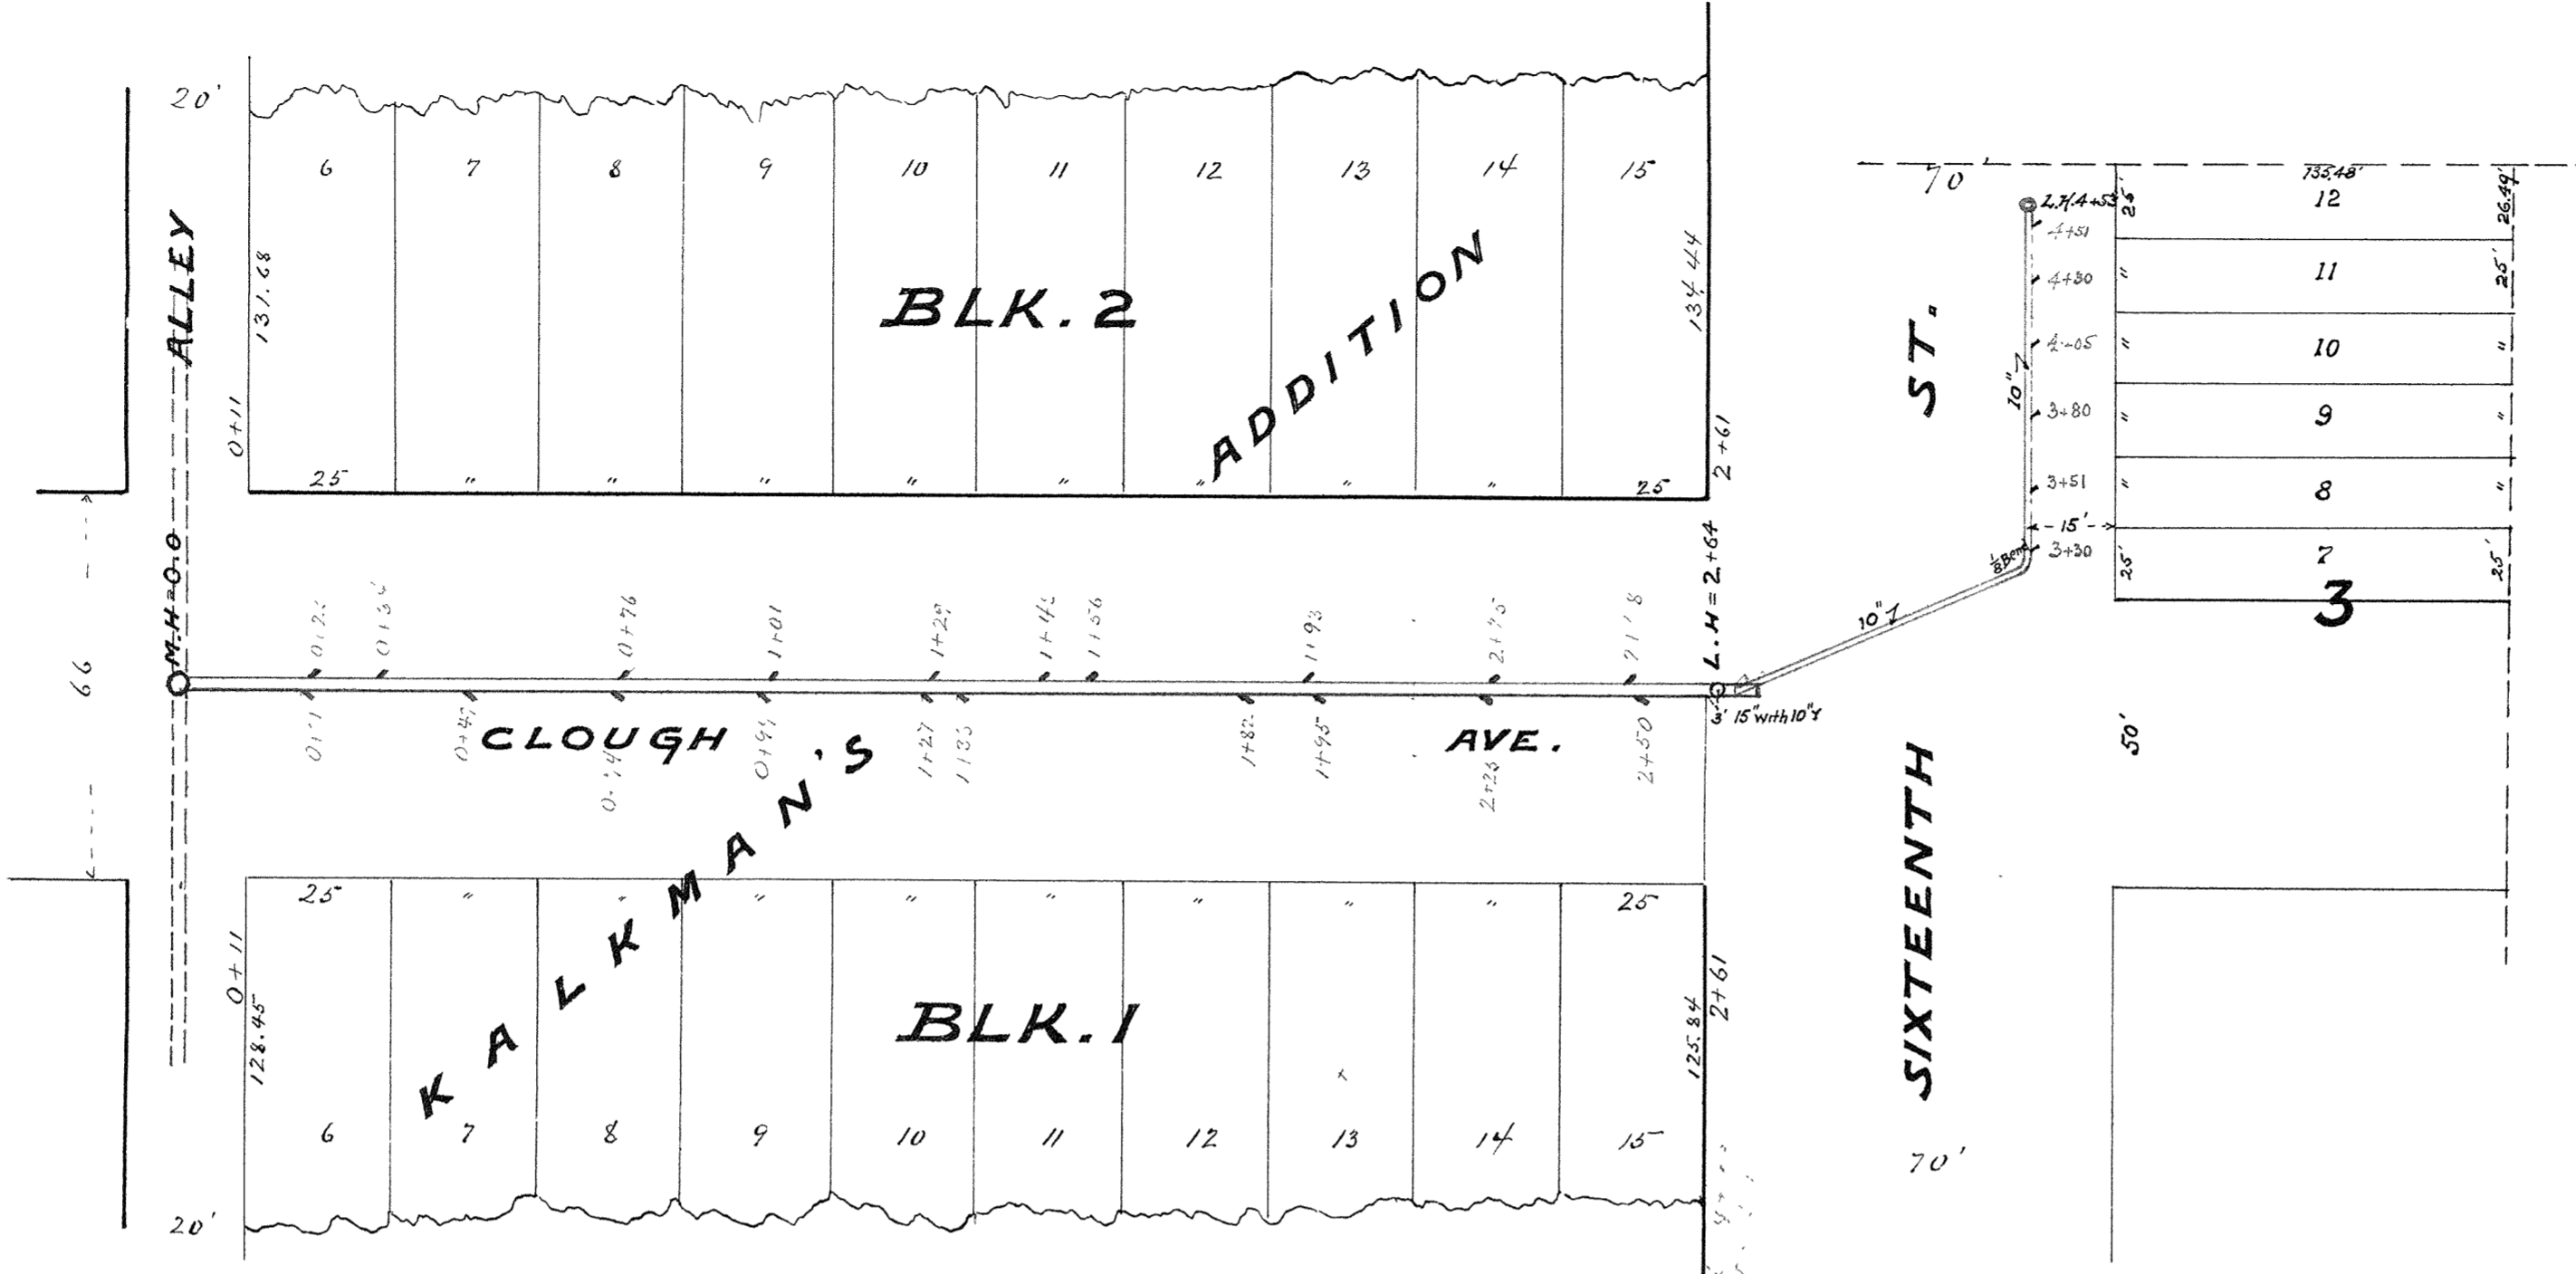


SCALE: ... { HORIZONTAL 1" = 30 FT.
 VERTICAL 1" = 4 FT.
 SECTION 1" = 4 FT.

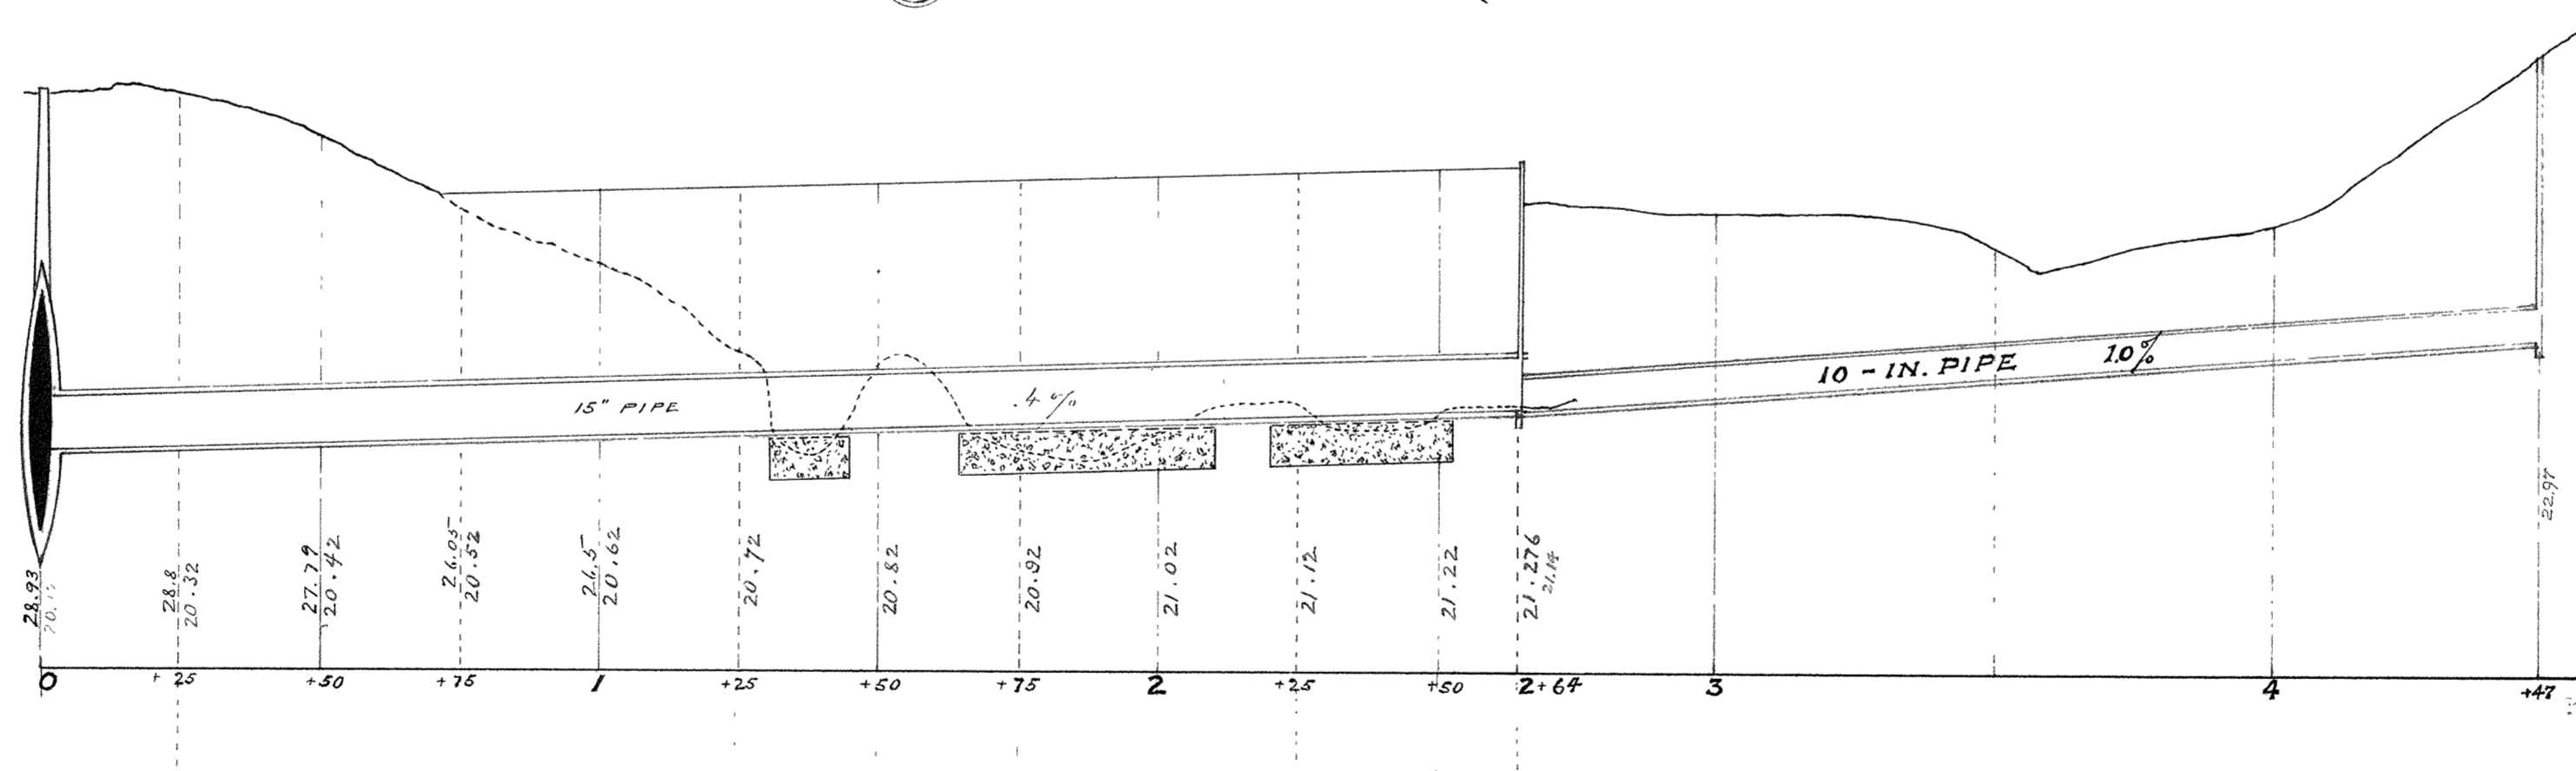

BASE LINE DRAWN 15' ABOVE CITY DATUM

SECTION OF 15" PIPE ON CONCRETE

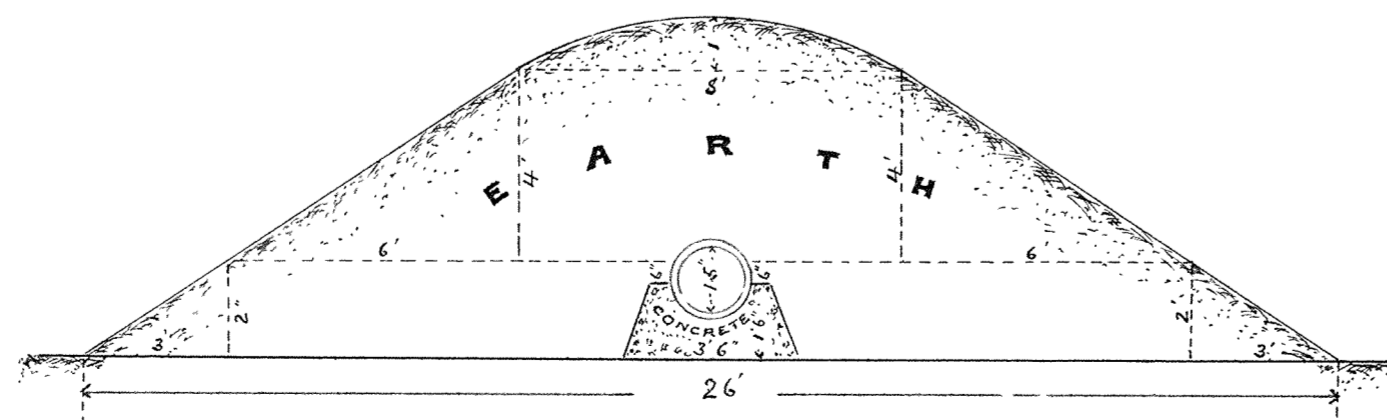

2B-48