


**CITY OF SUPERIOR
SEWER PLAN.**

Horizontal Scale : 1 in. = 60 ft.
Vertical Scale 1 in. = 4 ft.

CONTRACT NO 1117
Contract let Aug. 26, 1908.
Contract completed Oct. 16, 1908.
Anderson, Johnson & Co. Contractors.
F. L. Clark Inspector.
E. B. Banks City Engineer.

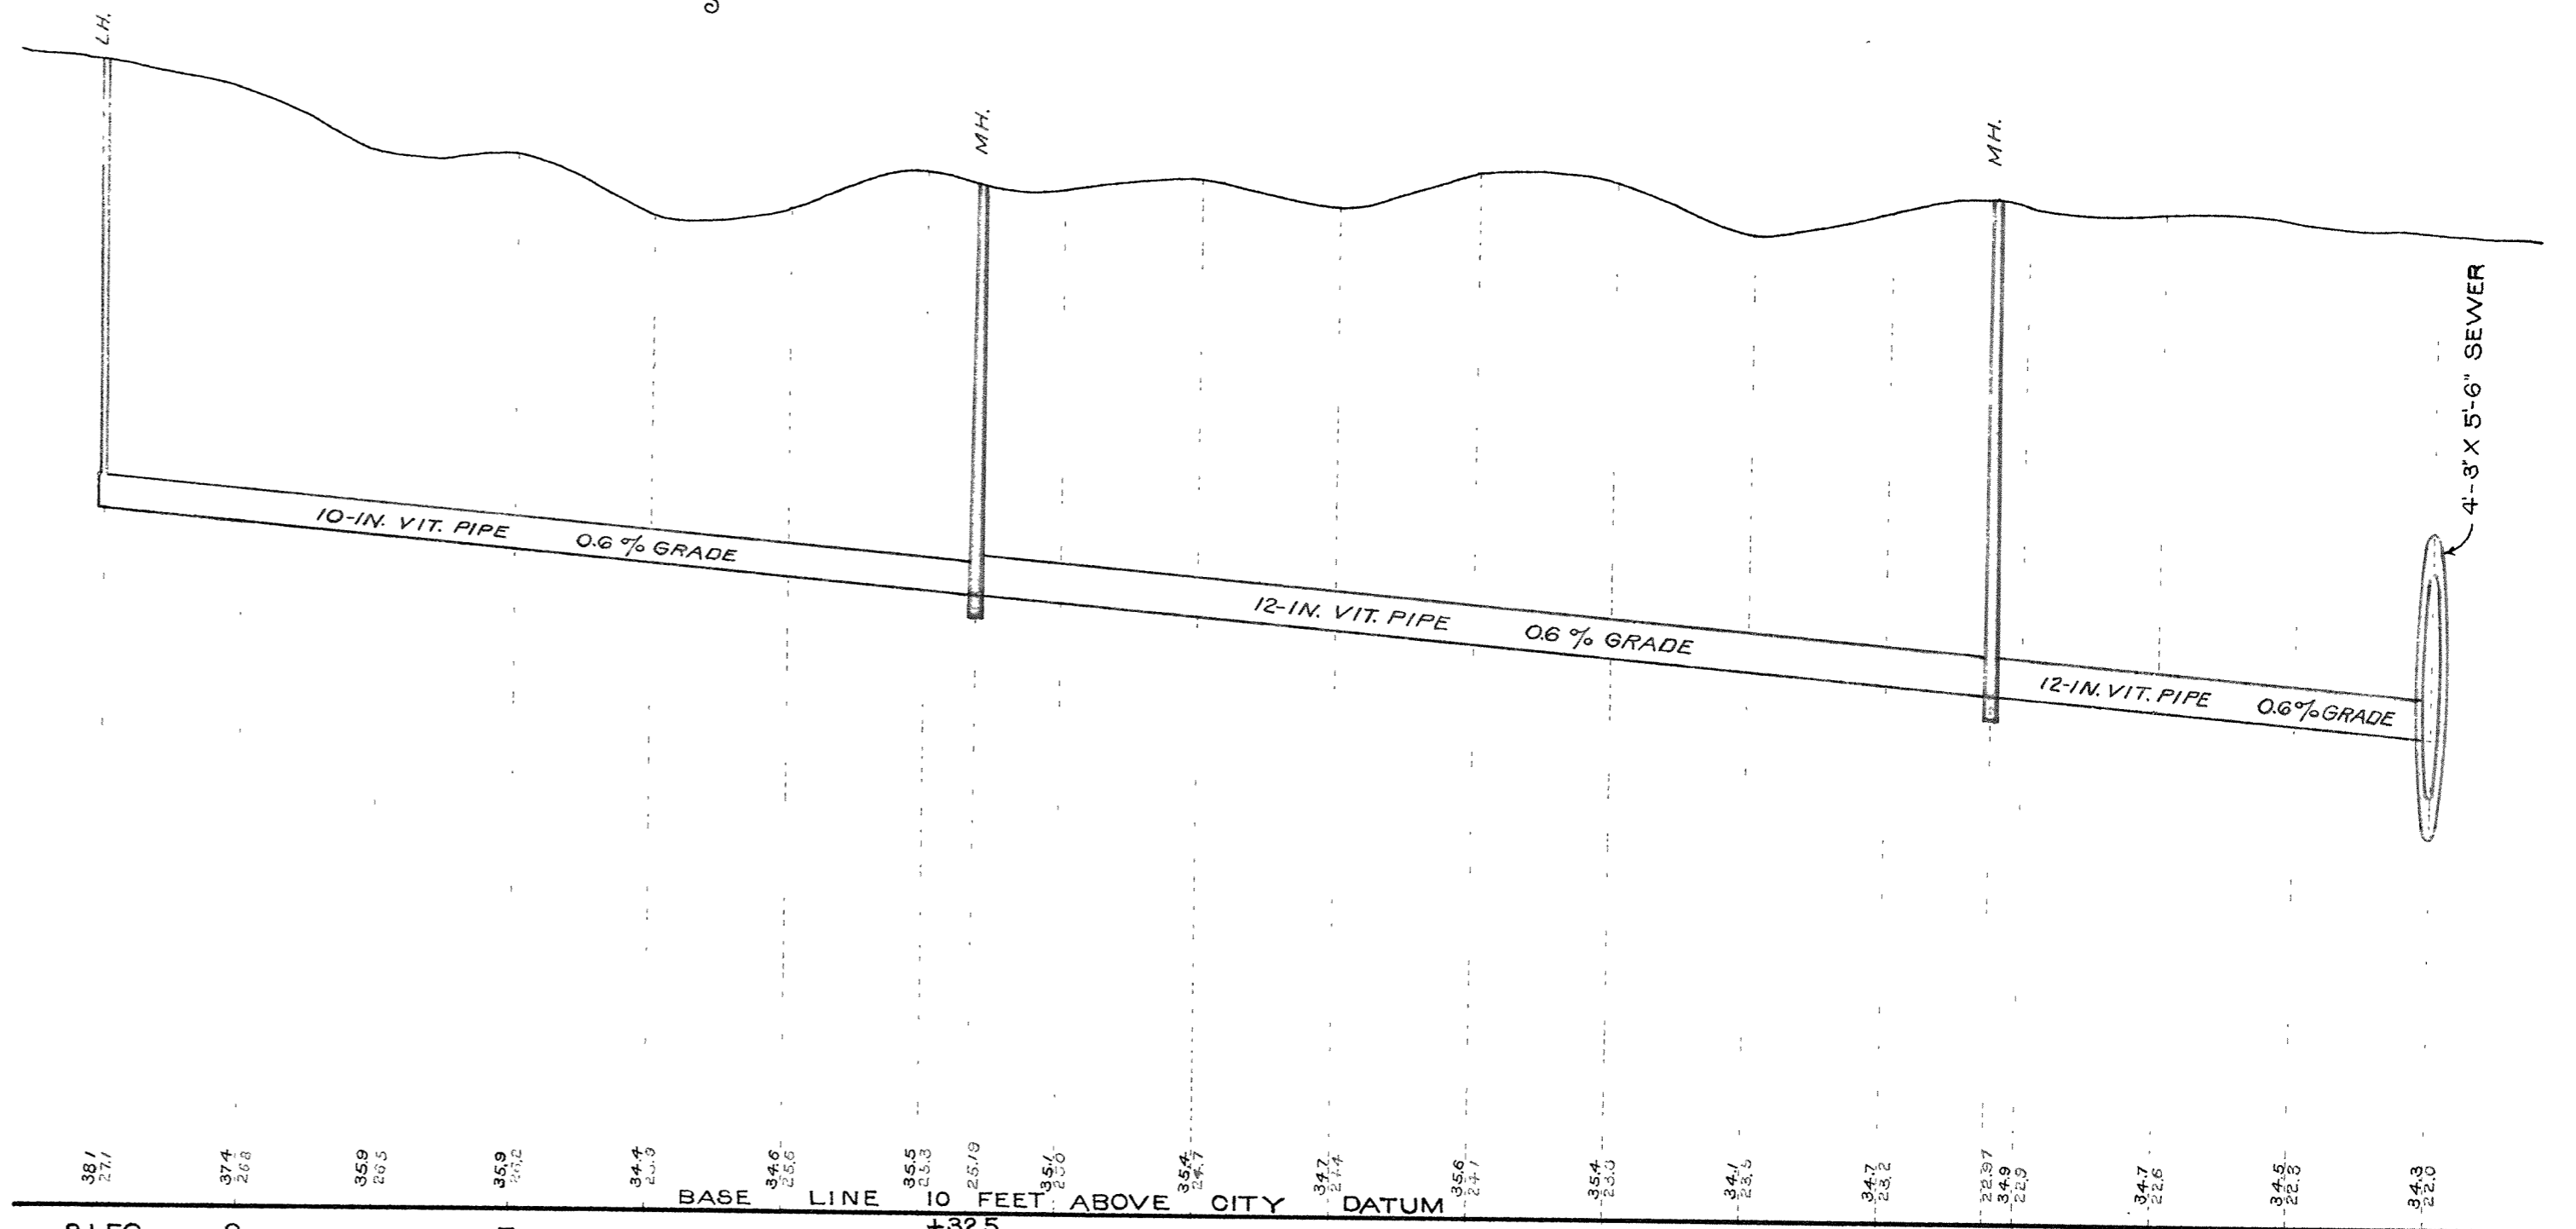

Sewer in Alley between Belknap & N. 16th St. from Hammond to Baxter Ave. and in Baxter Ave. to N. 16th St.