

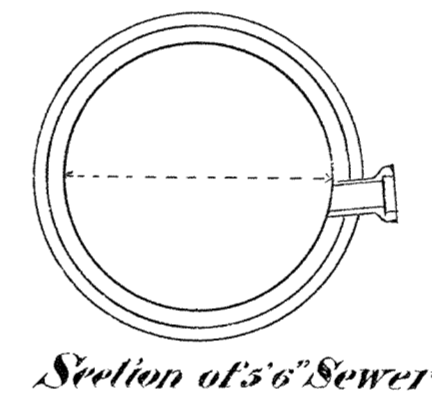


**CITY OF SUPERIOR
SEWER PLAN 1893**

Contract let May 30, 1892
 completed Nov. 10, 1892
 Kirkland & Starke, Contractor
 John Extrom, Inspector
 A. S. Cooper, City Engineer

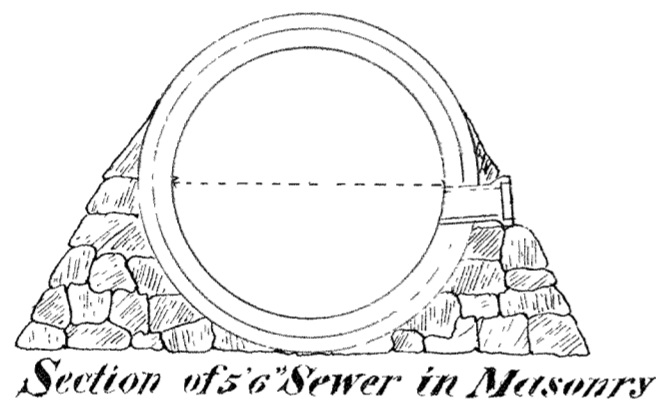

Scale: { Horizontal 60' = 1"
 Vertical 4' = 1"
 Section 4' = 1"

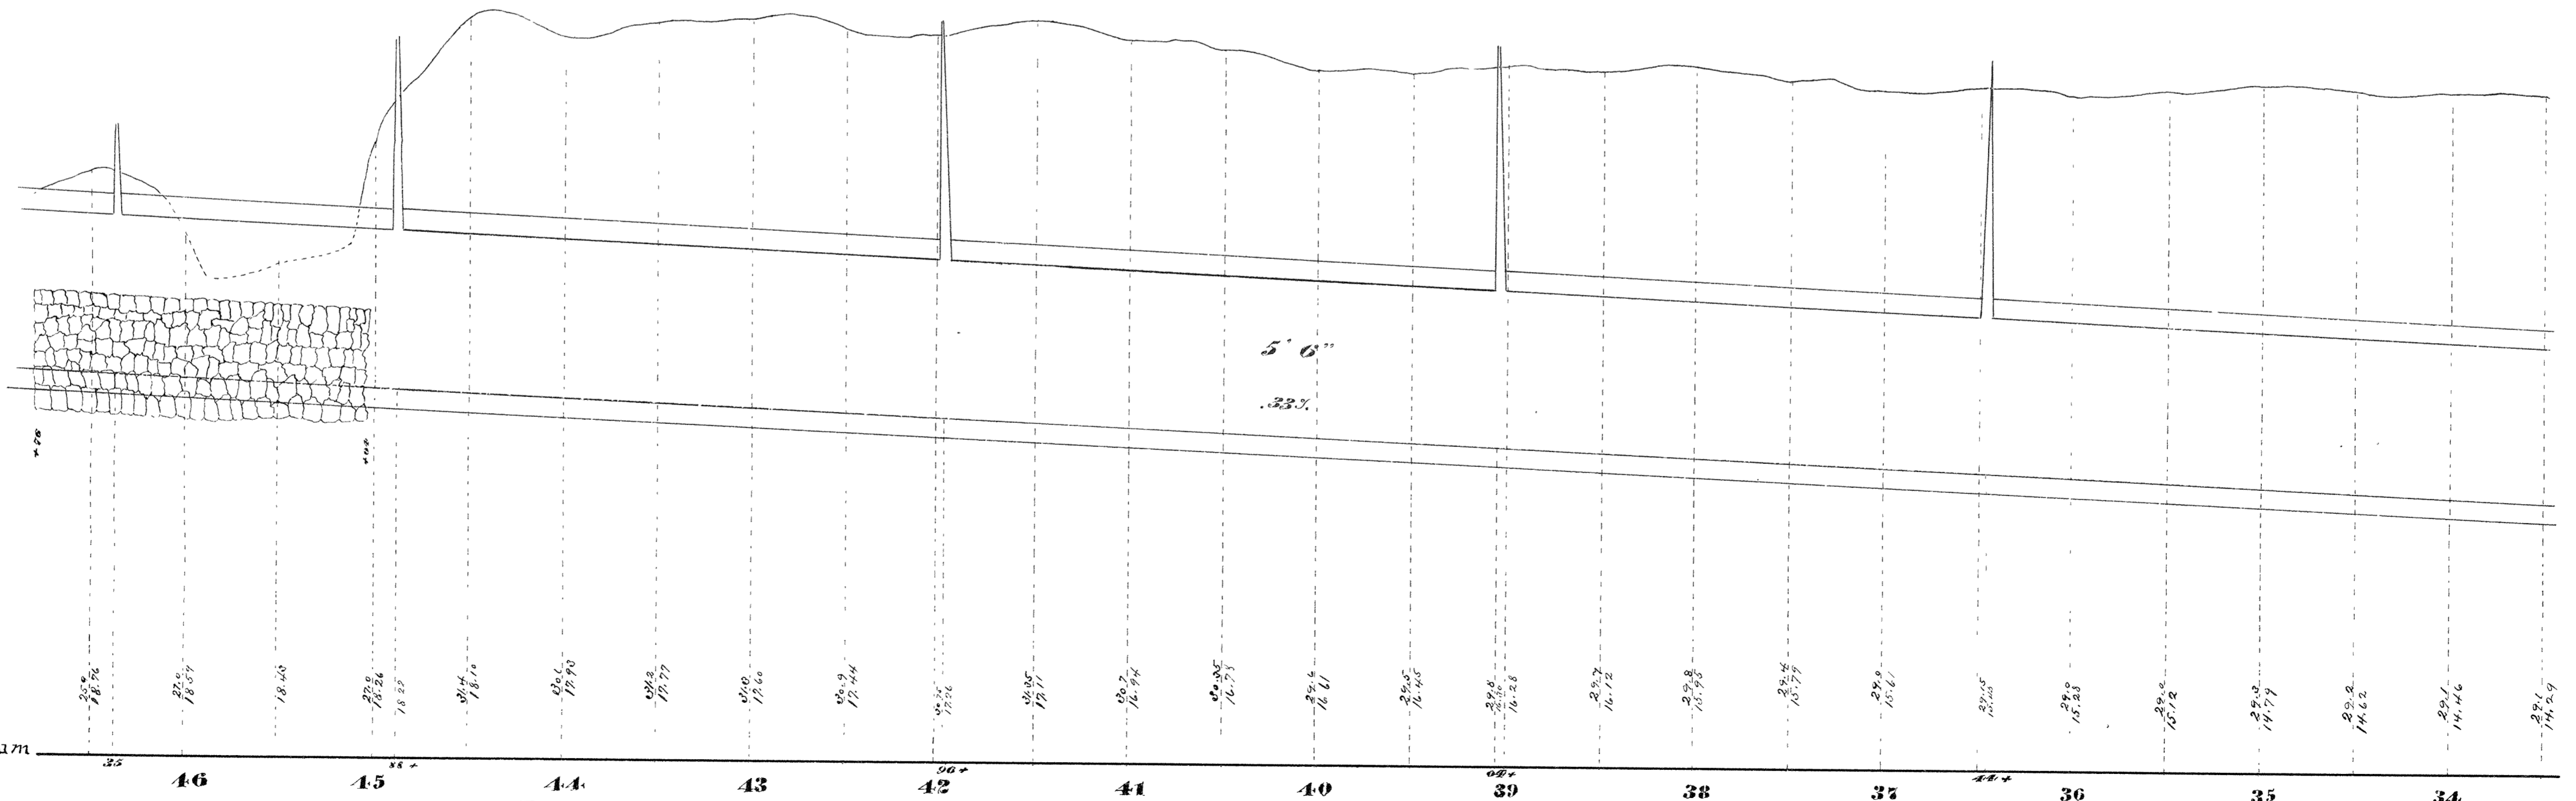

2B-53