

BIRCH
AVE.

+1+32.5

-82.5

-175
0+00

CATLIN

BELKNAP
326.07'

345'

320'

330'

16TH ST.

HARRISON ST.

17TH ST.


AVE.

M.H. 4+50.5

M.H. 9+00.5

8+44.7

55'

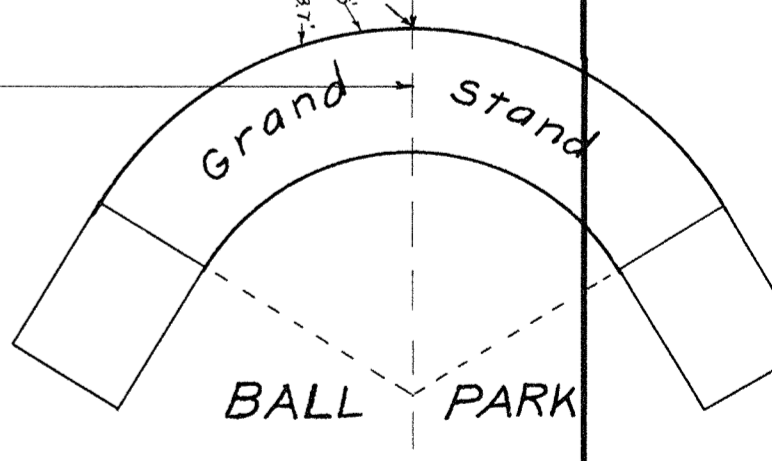

CITY OF SUPERIOR SEWER PLAN

HORIZONTAL SCALE $1'' = 60'$
VERTICAL SCALE $1'' = 4'$

JOB STARTED JAN. 1938
JOB COMPLETED MAY 1938
W.P.A. LABOR
F.BIRCH INSPECTOR
T.M.BASTERASH CITY ENGINEER

