



CITY OF SUPERIOR
SEWER PLAN
 Contract let May 30, 1892
 Completed Nov. 10, 1892
 Kirkland & Starke, Contractor
 John Extrom, Inspector
 A. S. Cooper, City Engr.

1893


Horizontal 1" = 60'
 Scale: Vertical 1" = 4'
 Section 1" = 4'

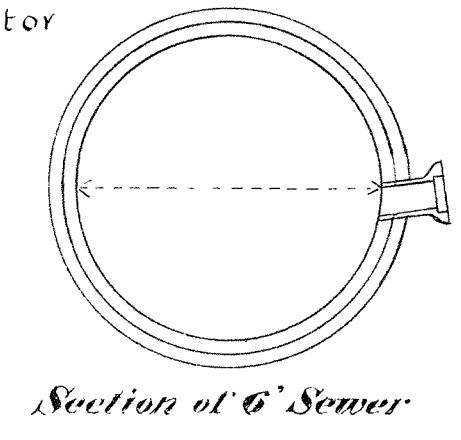


Section of 6' Sewer

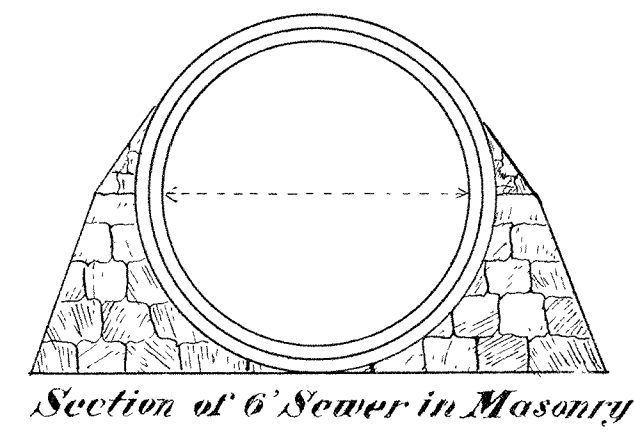


Section of 6' Sewer in Masonry

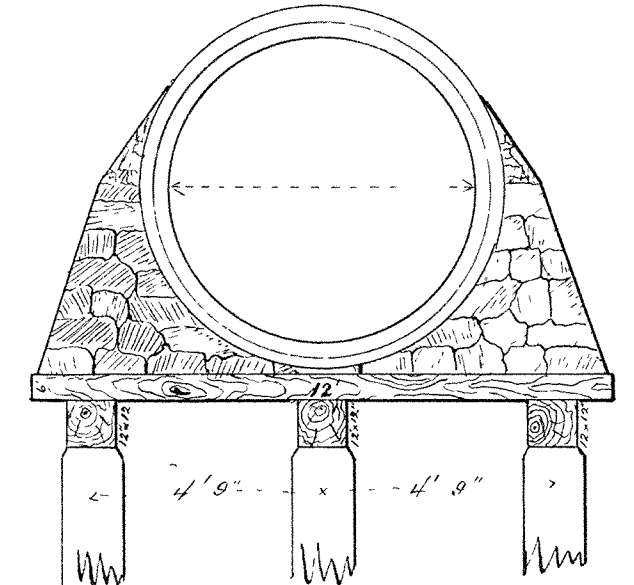


Section of 6' Sewer on Piles

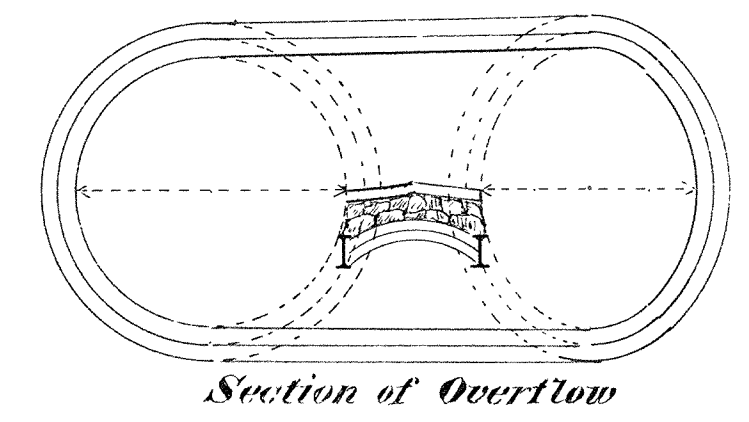

Section of Overflow

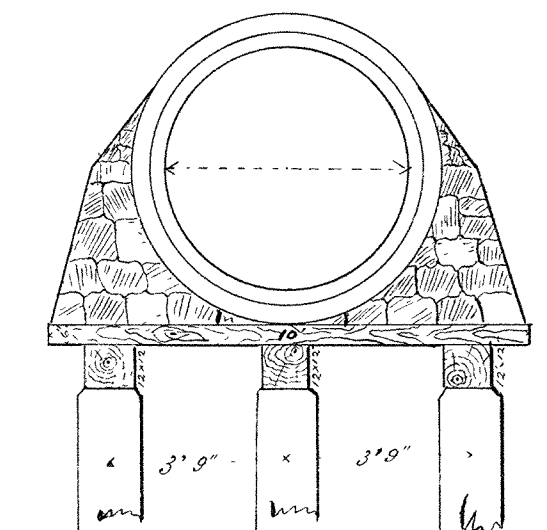

Section of 5' Sewer on Piles

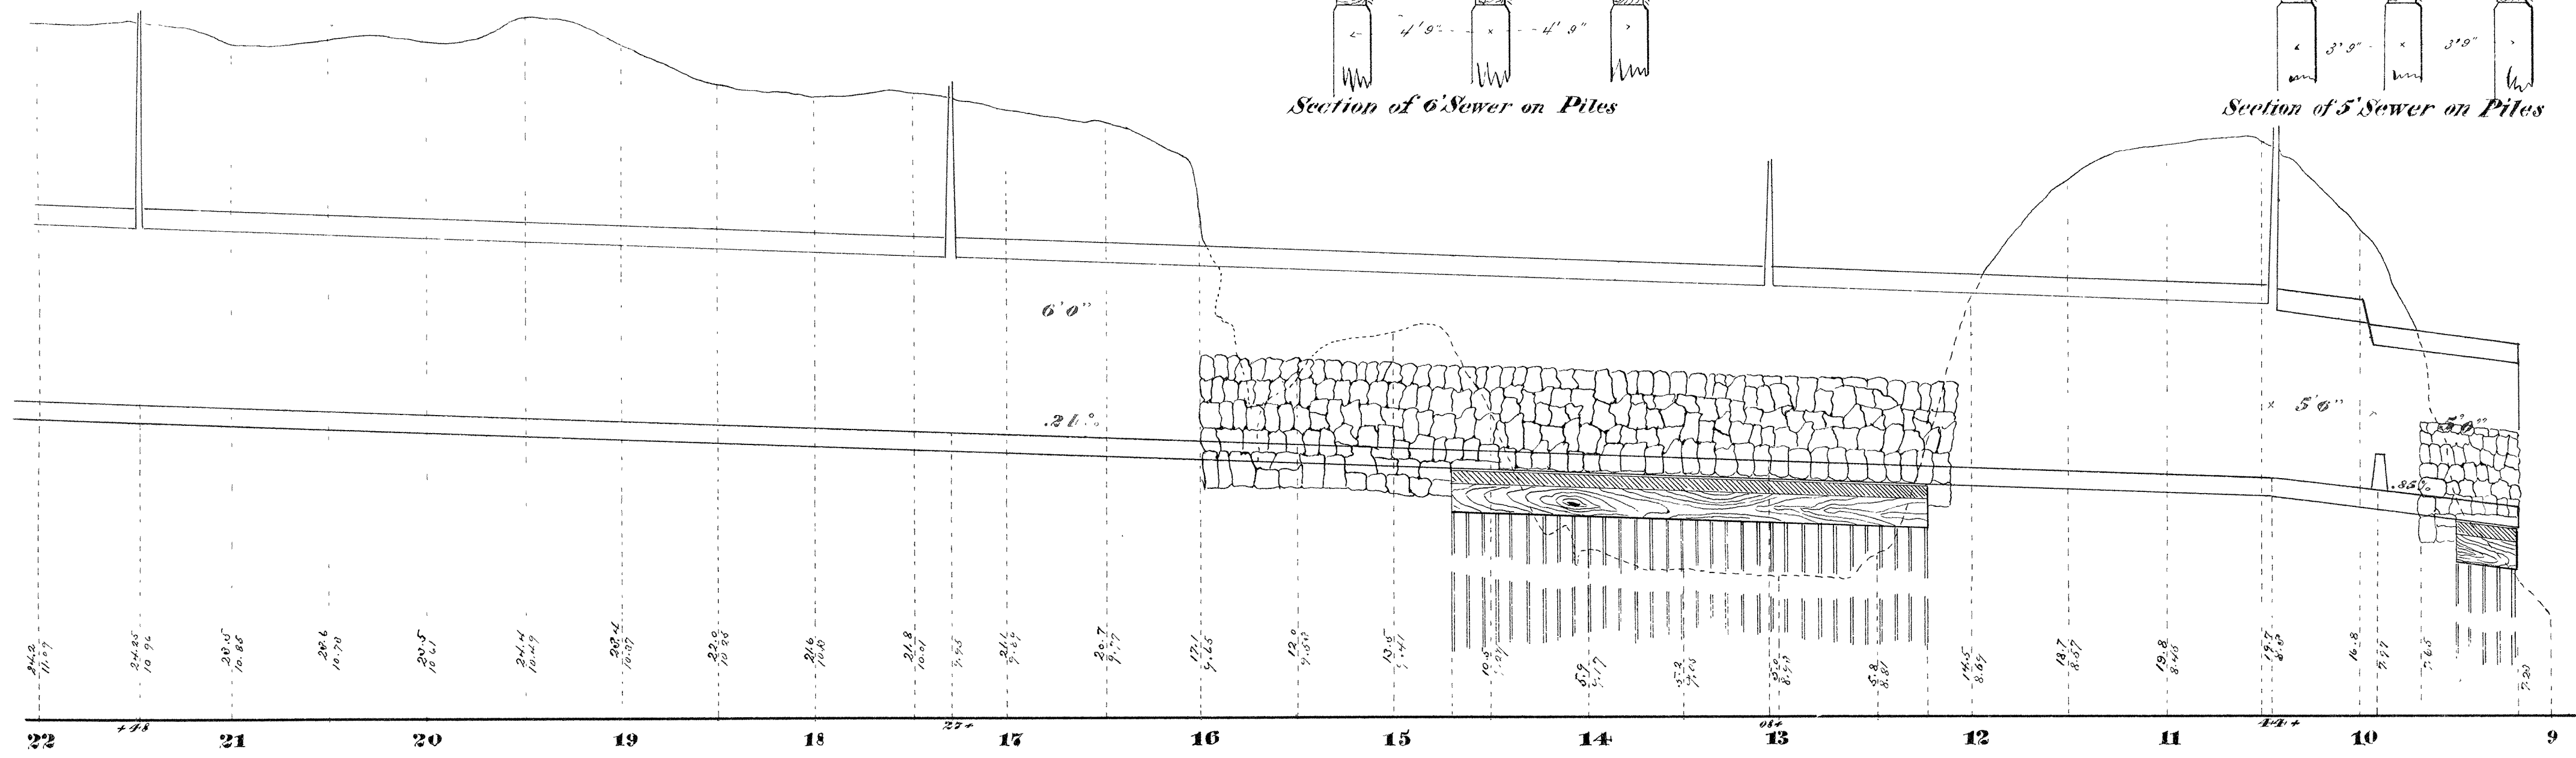

Plan & Profile of Sewer in Alley betw. Cypress and Birch from Broadway to 13th St.

2B-55