


CITY OF SUPERIOR
SEWER PLAN
 HORIZONTAL SCALE 1 60
 VERTICAL SCALE 1 4
 JOB STARTED JAN 5 1937
 JOB COMPLETED JAN 11 1937
 W.P.A. LABOR
 INSPECTOR M. S. SKAMSER
 CITY ENGINEER L.W. PELESKE

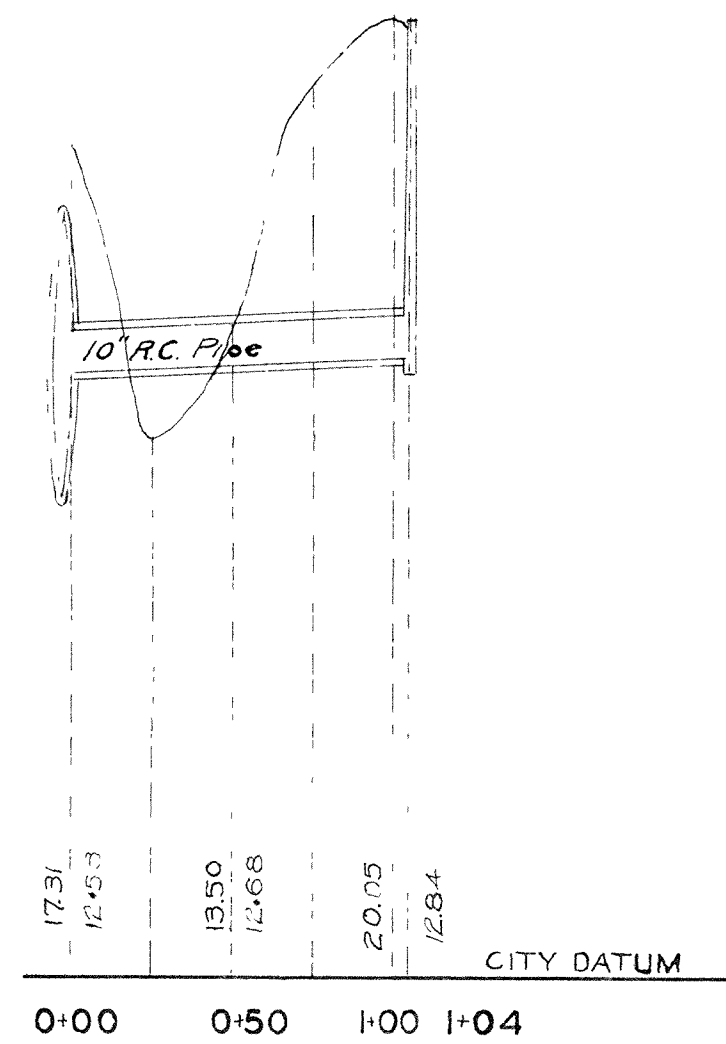

PLAN AND PROFILE OF SEWER IN ALLEY BETWEEN 11TH AND 12TH ST.
 FROM 72 IN SEWER WEST

2B-55A