


Scale { Horizontal 1 inch = 60 ft.
 Vertical 1" = 4"
 Section 1" = 2"

CITY OF SUPERIOR
SEWER PLAN

Contract let July 27, 1891
 completed Oct. 23, 1891
 F. A. Dole, Contractor
 T. King, Inspector
 E. B. Banks, City Engineer

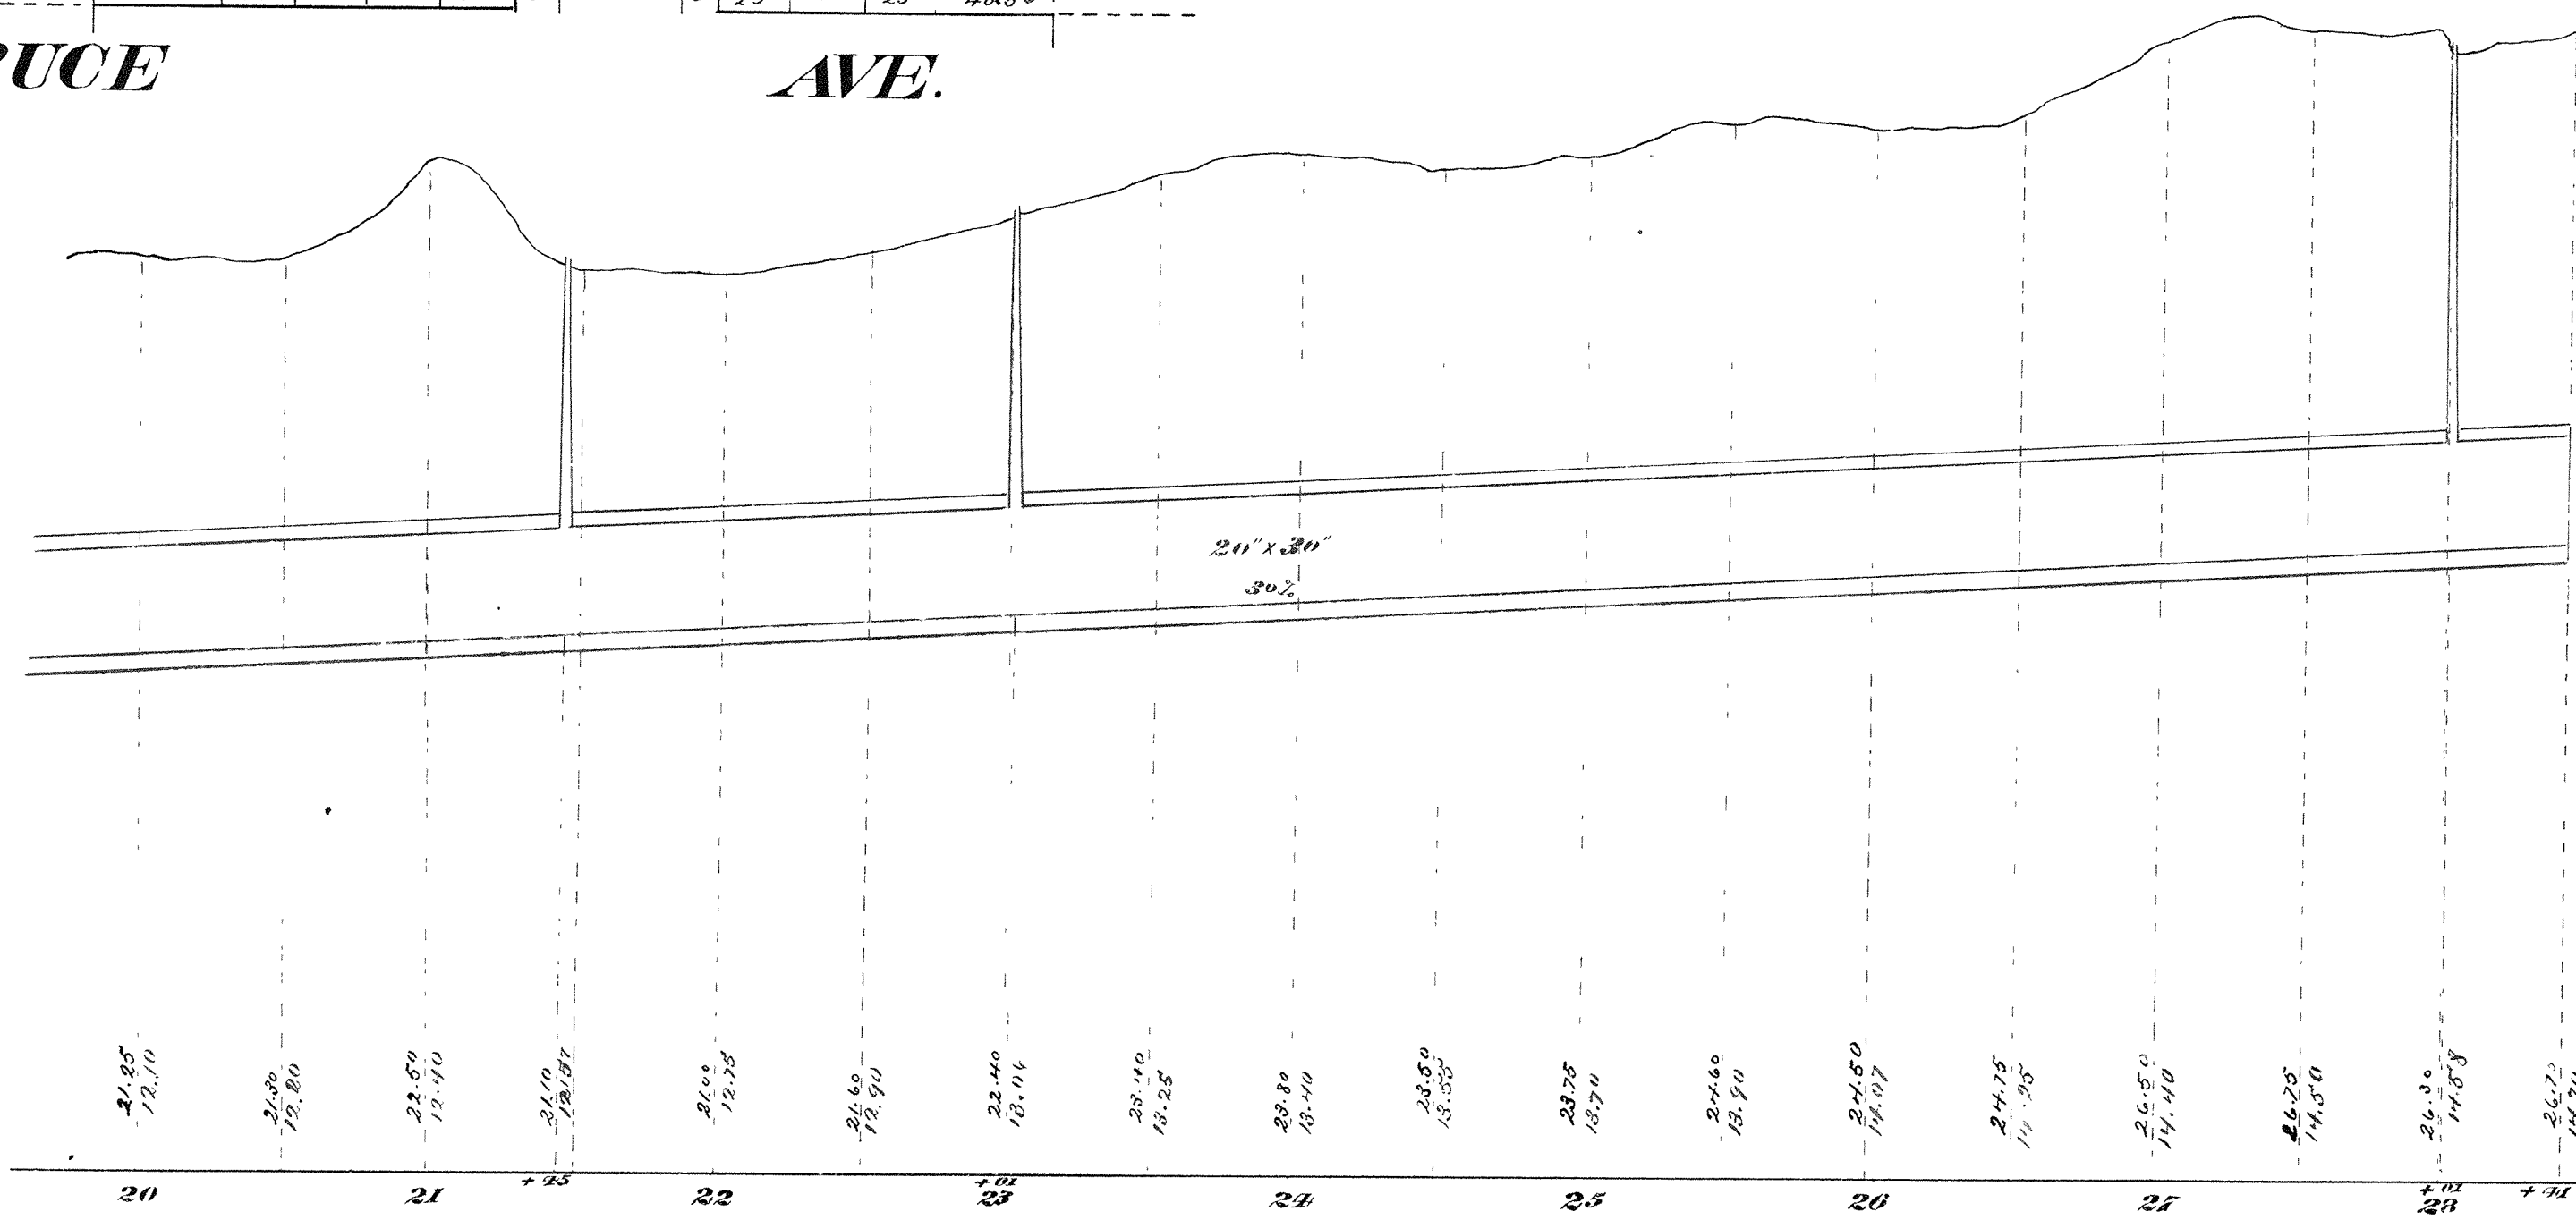

Plan & Profile of Sewer in Alley betw. Spruce & Pine Aves, also in 10th St. & Pine Ave. to Belknap St.

2B-62