
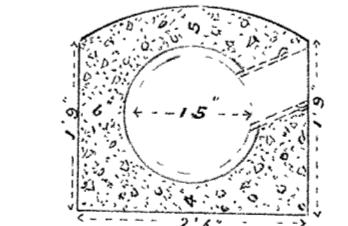
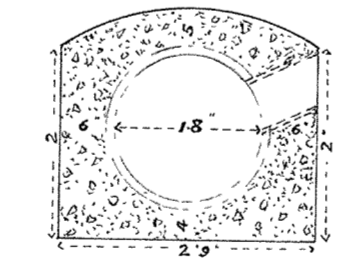
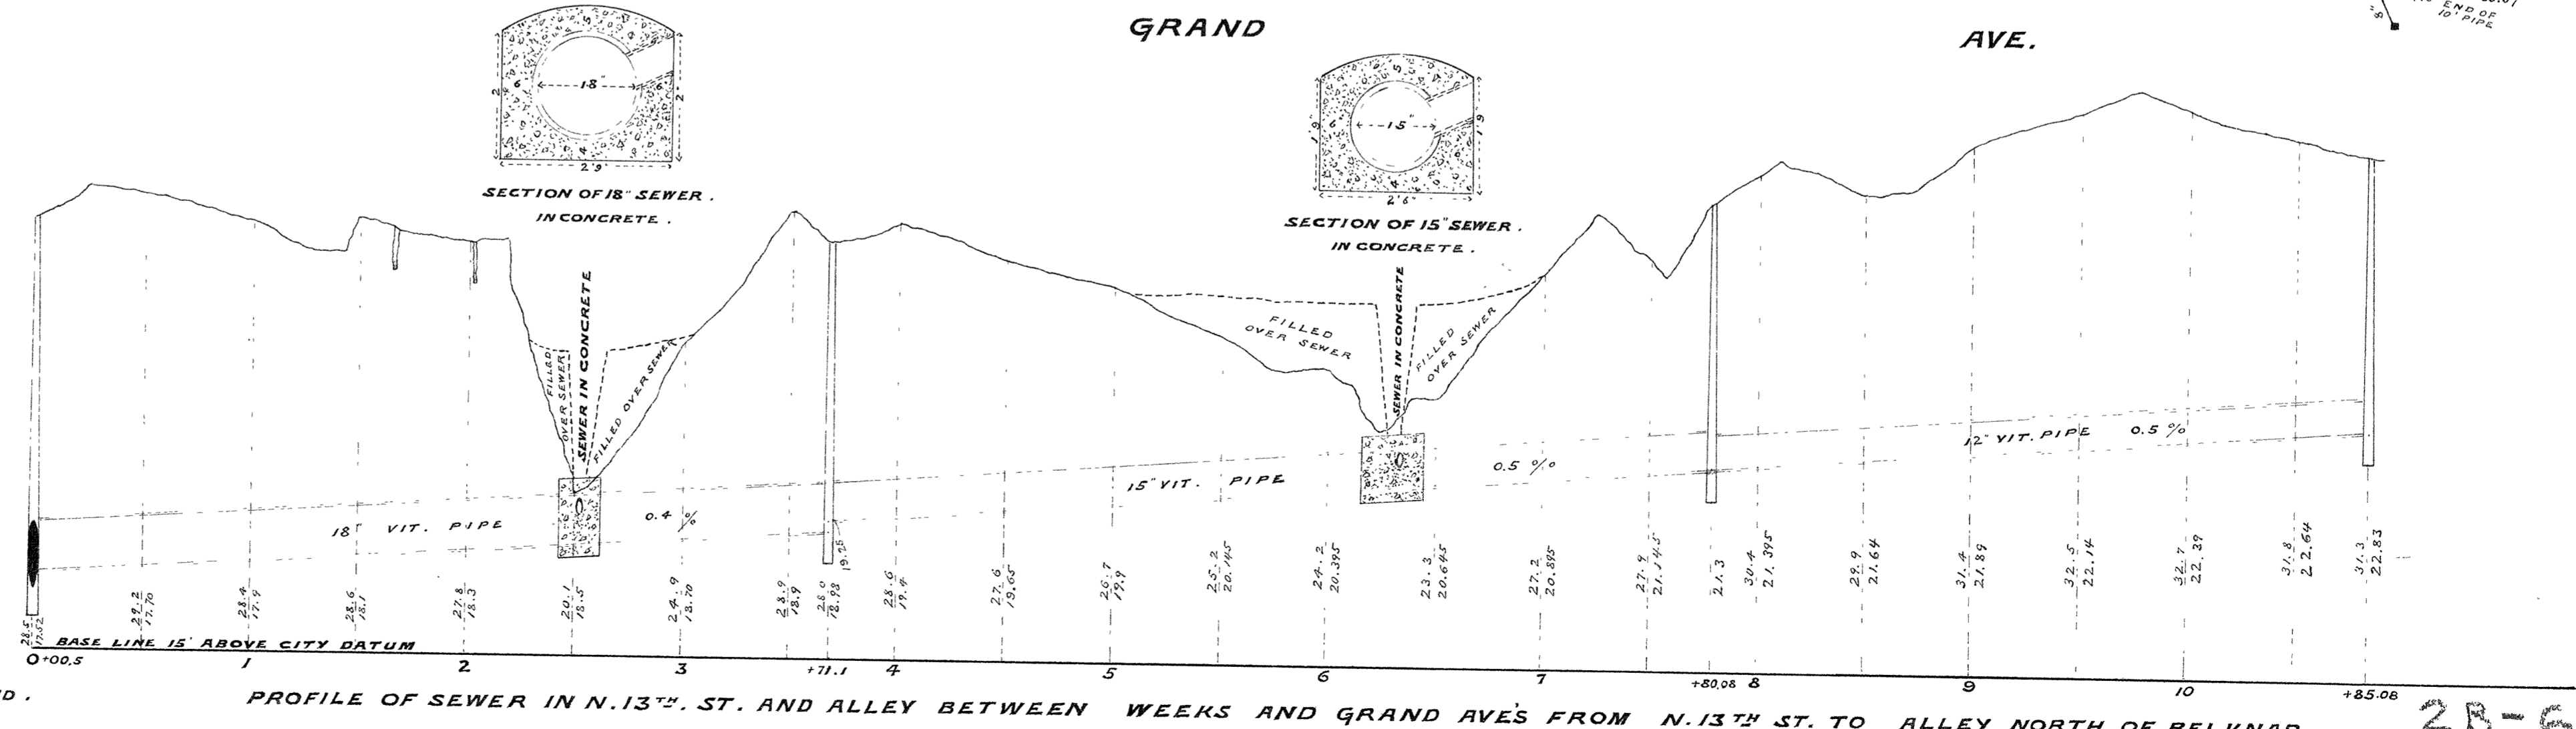
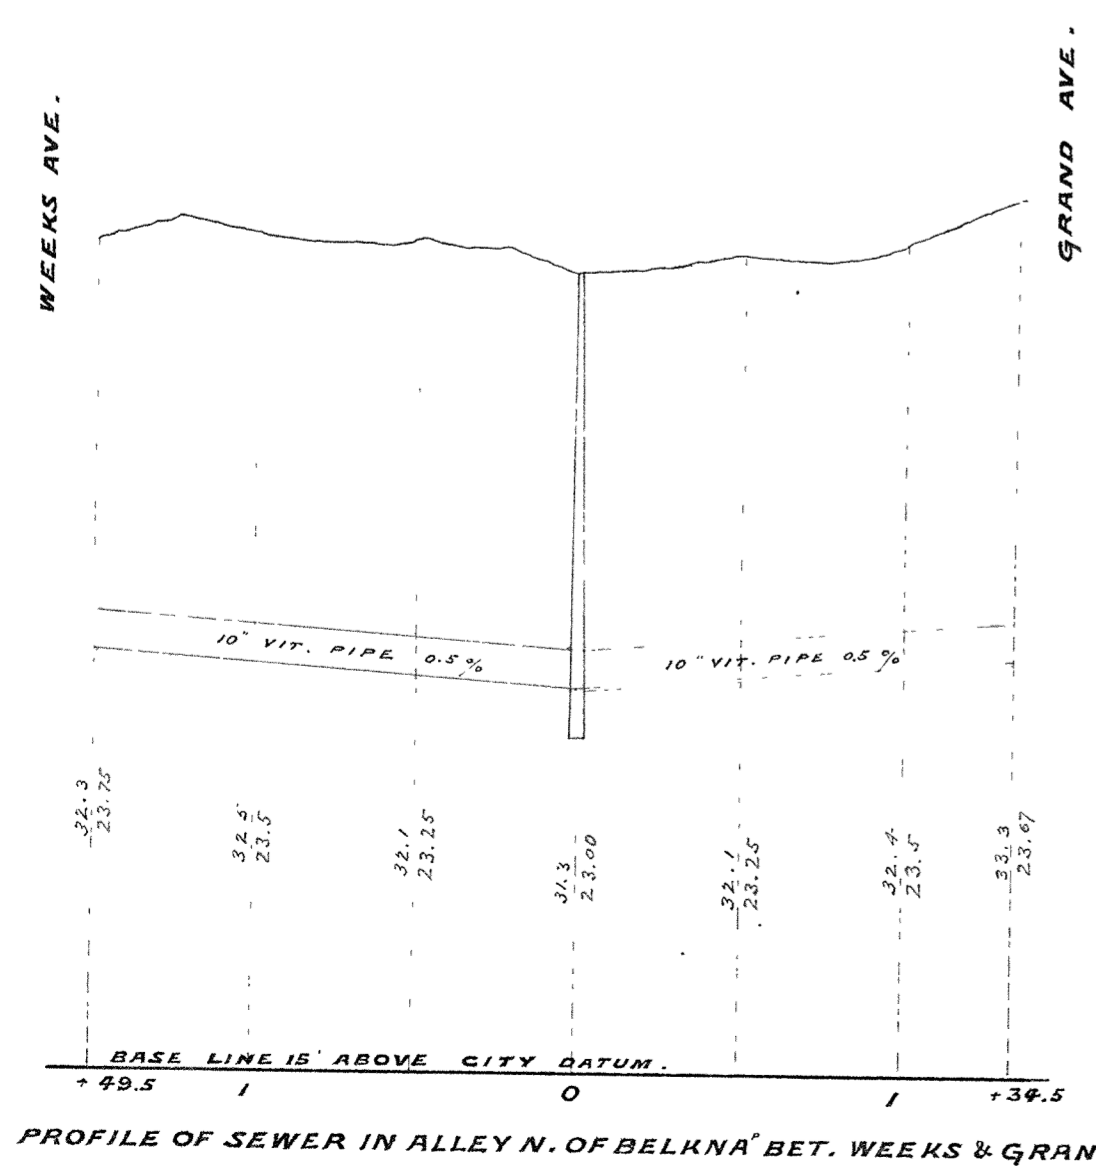


# CITY OF SUPERIOR. SEWER PLAN.

CONTRACT LET SEPT. 1<sup>ST</sup> 1905.  
SEWER COMPLETED DEC. 20<sup>TH</sup> 1905.  
CATCH BASINS " JULY 13<sup>TH</sup> 1906  
OLSON, JOHNSON & CO., CONTRACTORS.  
FRANK RICHARDSON, INSPECTOR.  
S. M. WHITE, CITY ENGINEER.

SCALE: { HORIZONTAL : 1" = 60 FT.  
VERTICAL : 1" = 4"  
SECTION : 1" = 2"

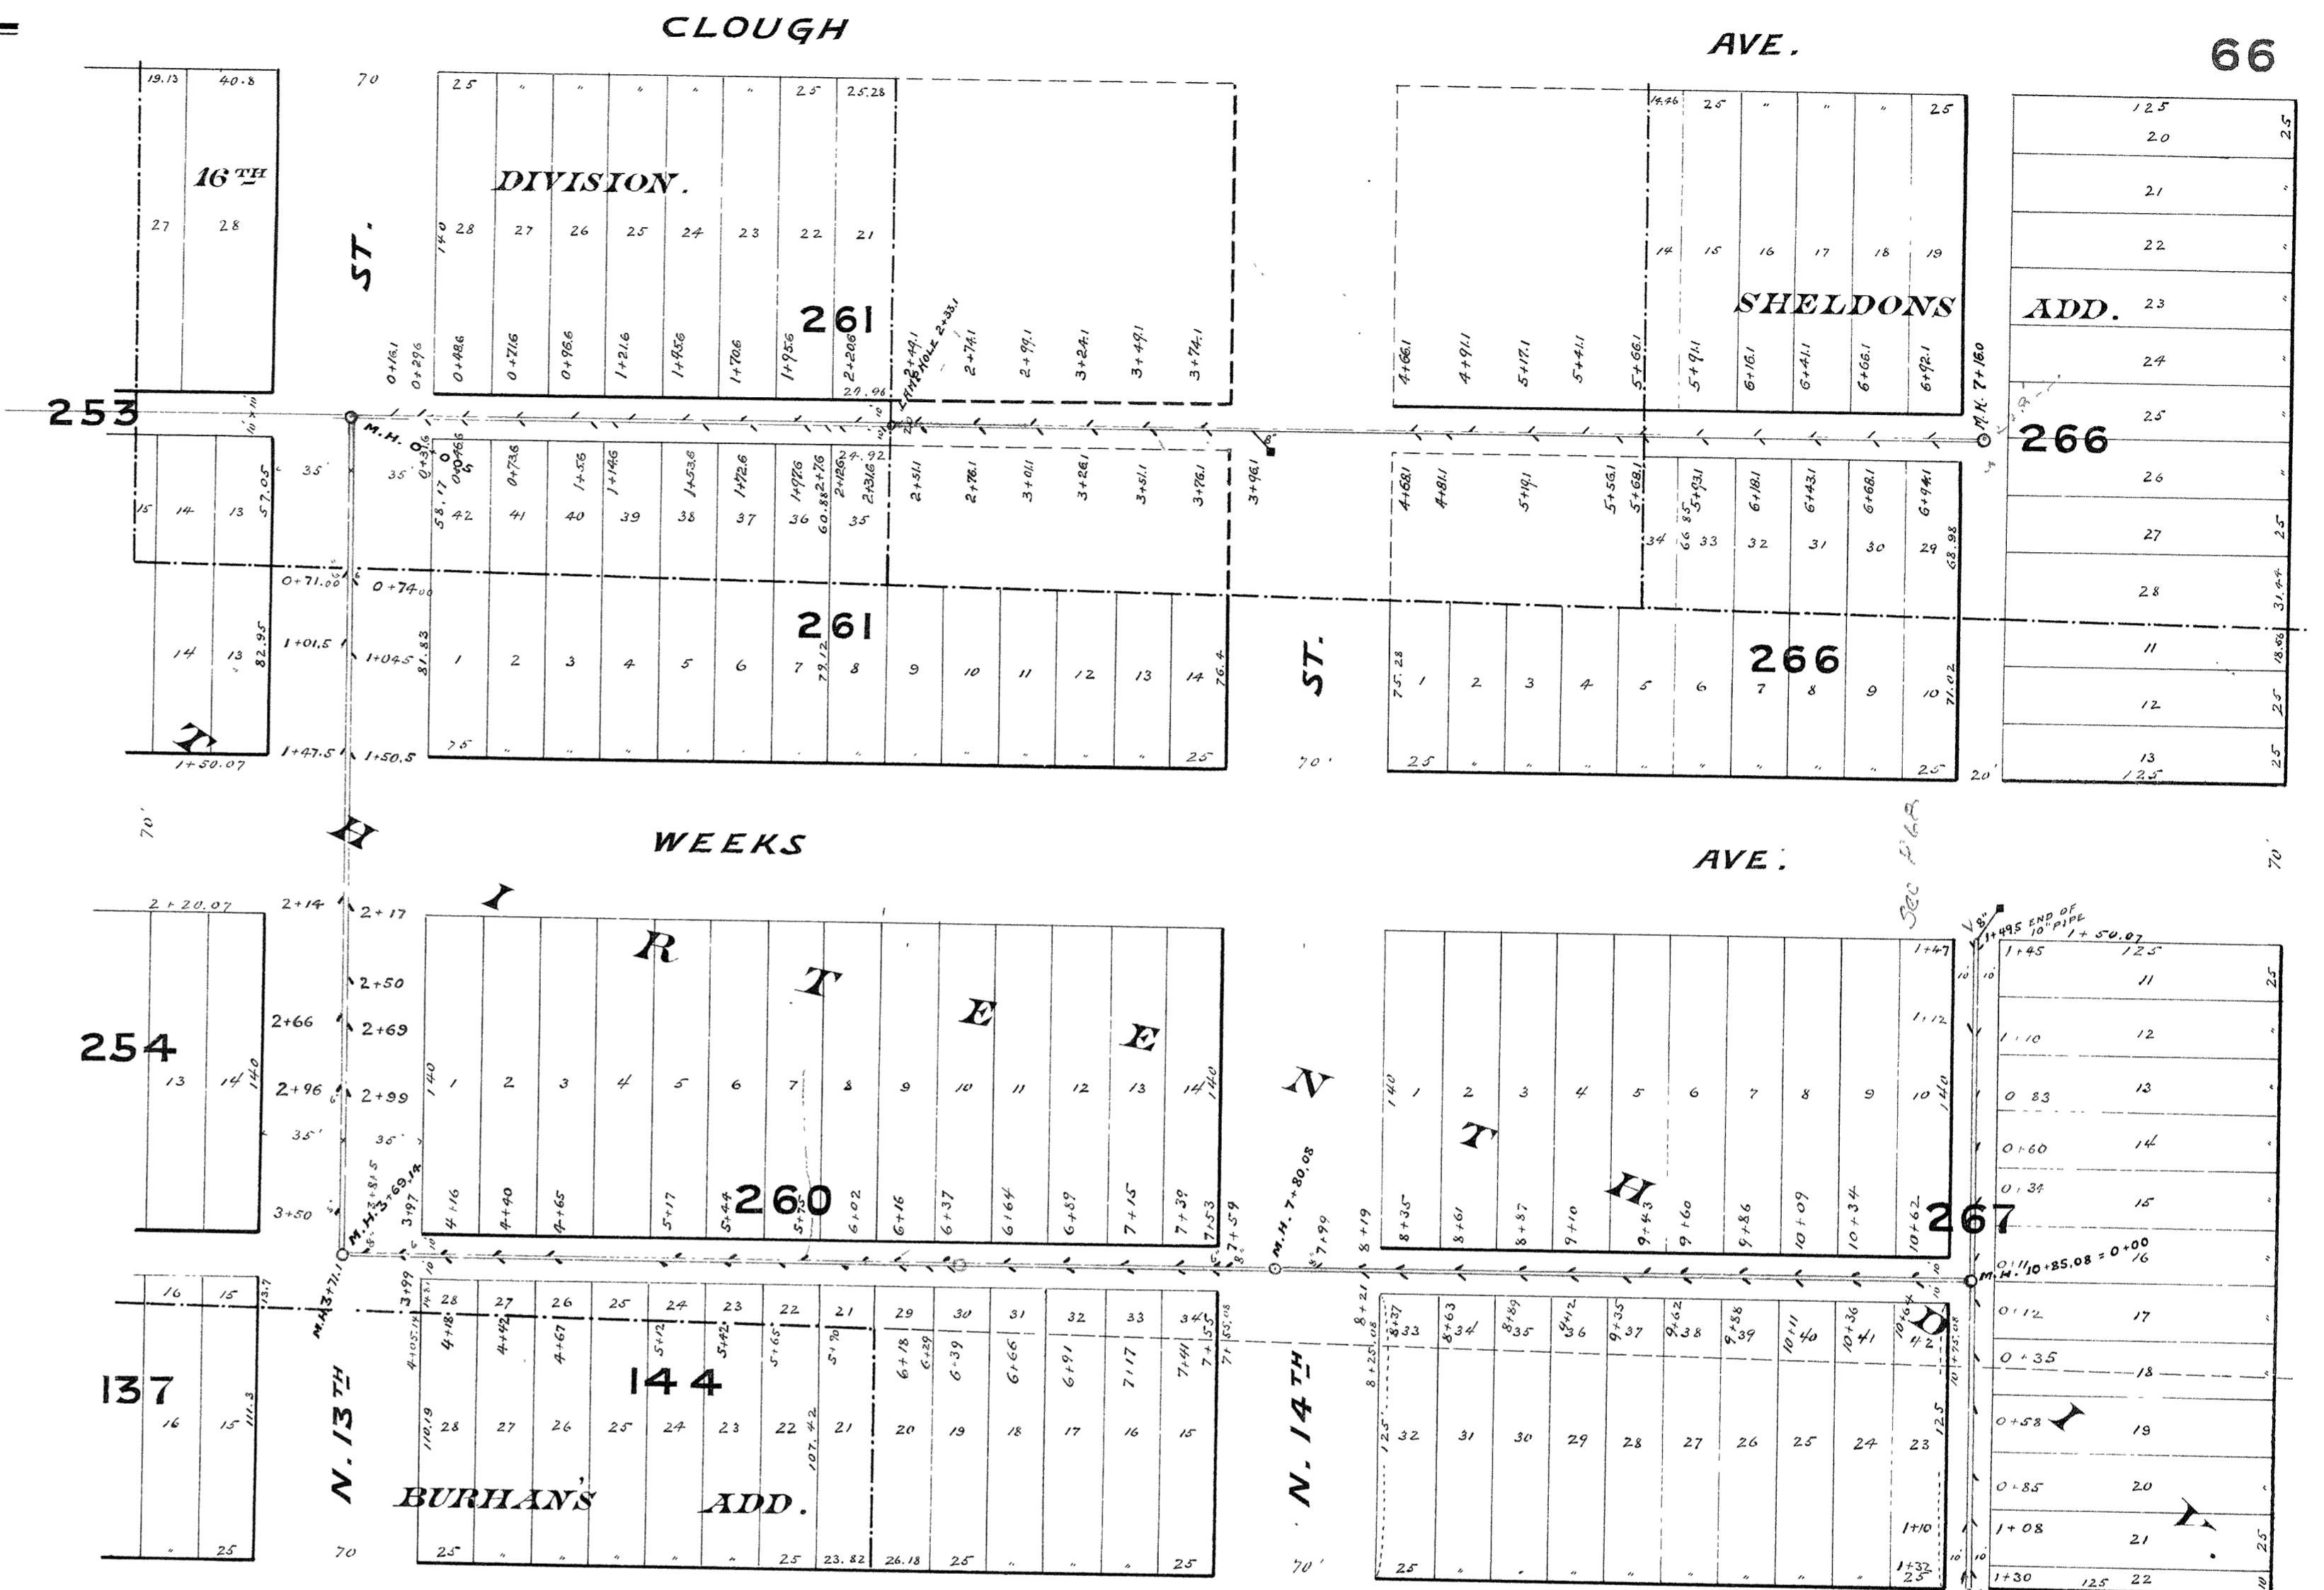

28-66

M. SPARBY, DEL.

28-66