

CITY OF SUPERIOR. SEWER PLAN.

CONTRACT LET JULY 12TH 1905 .



COMPLETED AUG. 23RD "

ANDERSON & JOHNSON CONTRACTORS .

CURTIS PAULING INSPECTOR .

S.M. WHITE CITY ENGINEER .

SCALE : { HORIZONTAL : 1" = 60'
VERTICAL : 1" = 4'

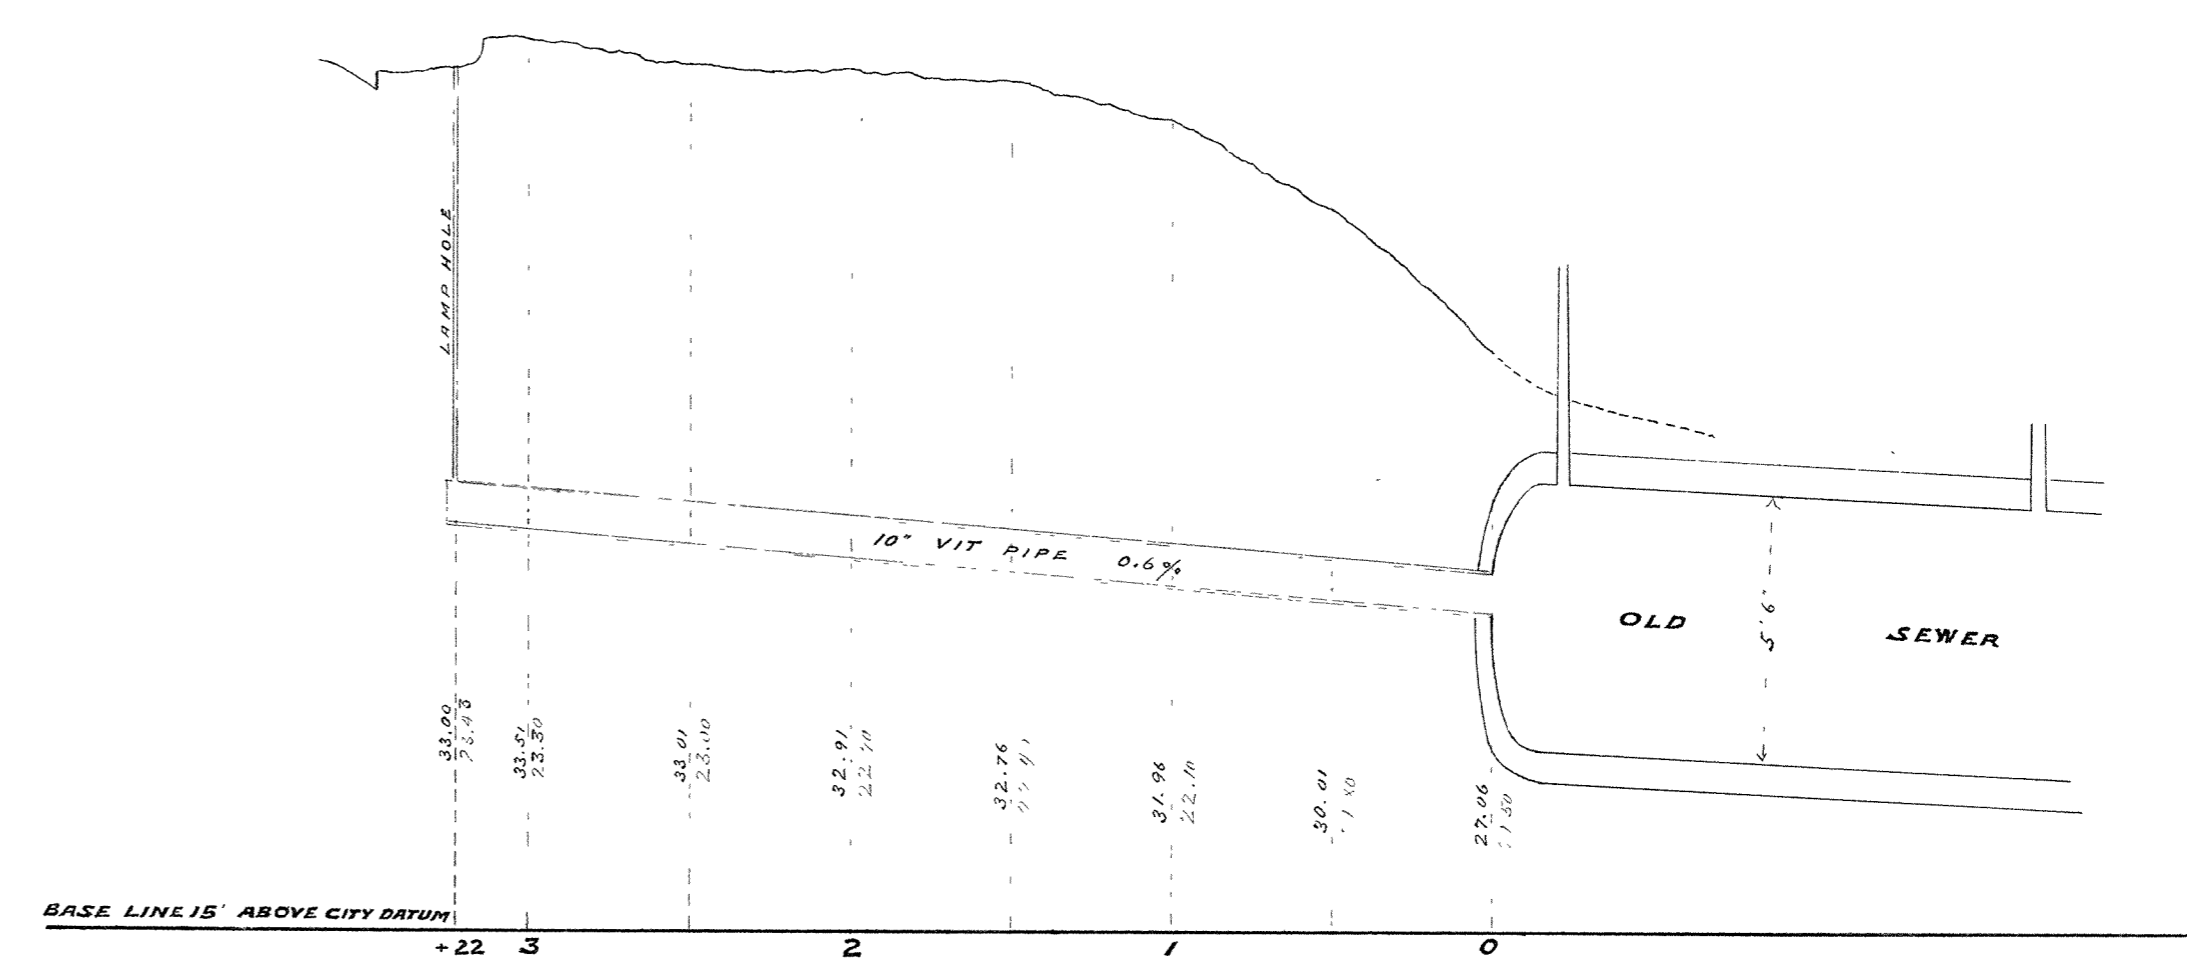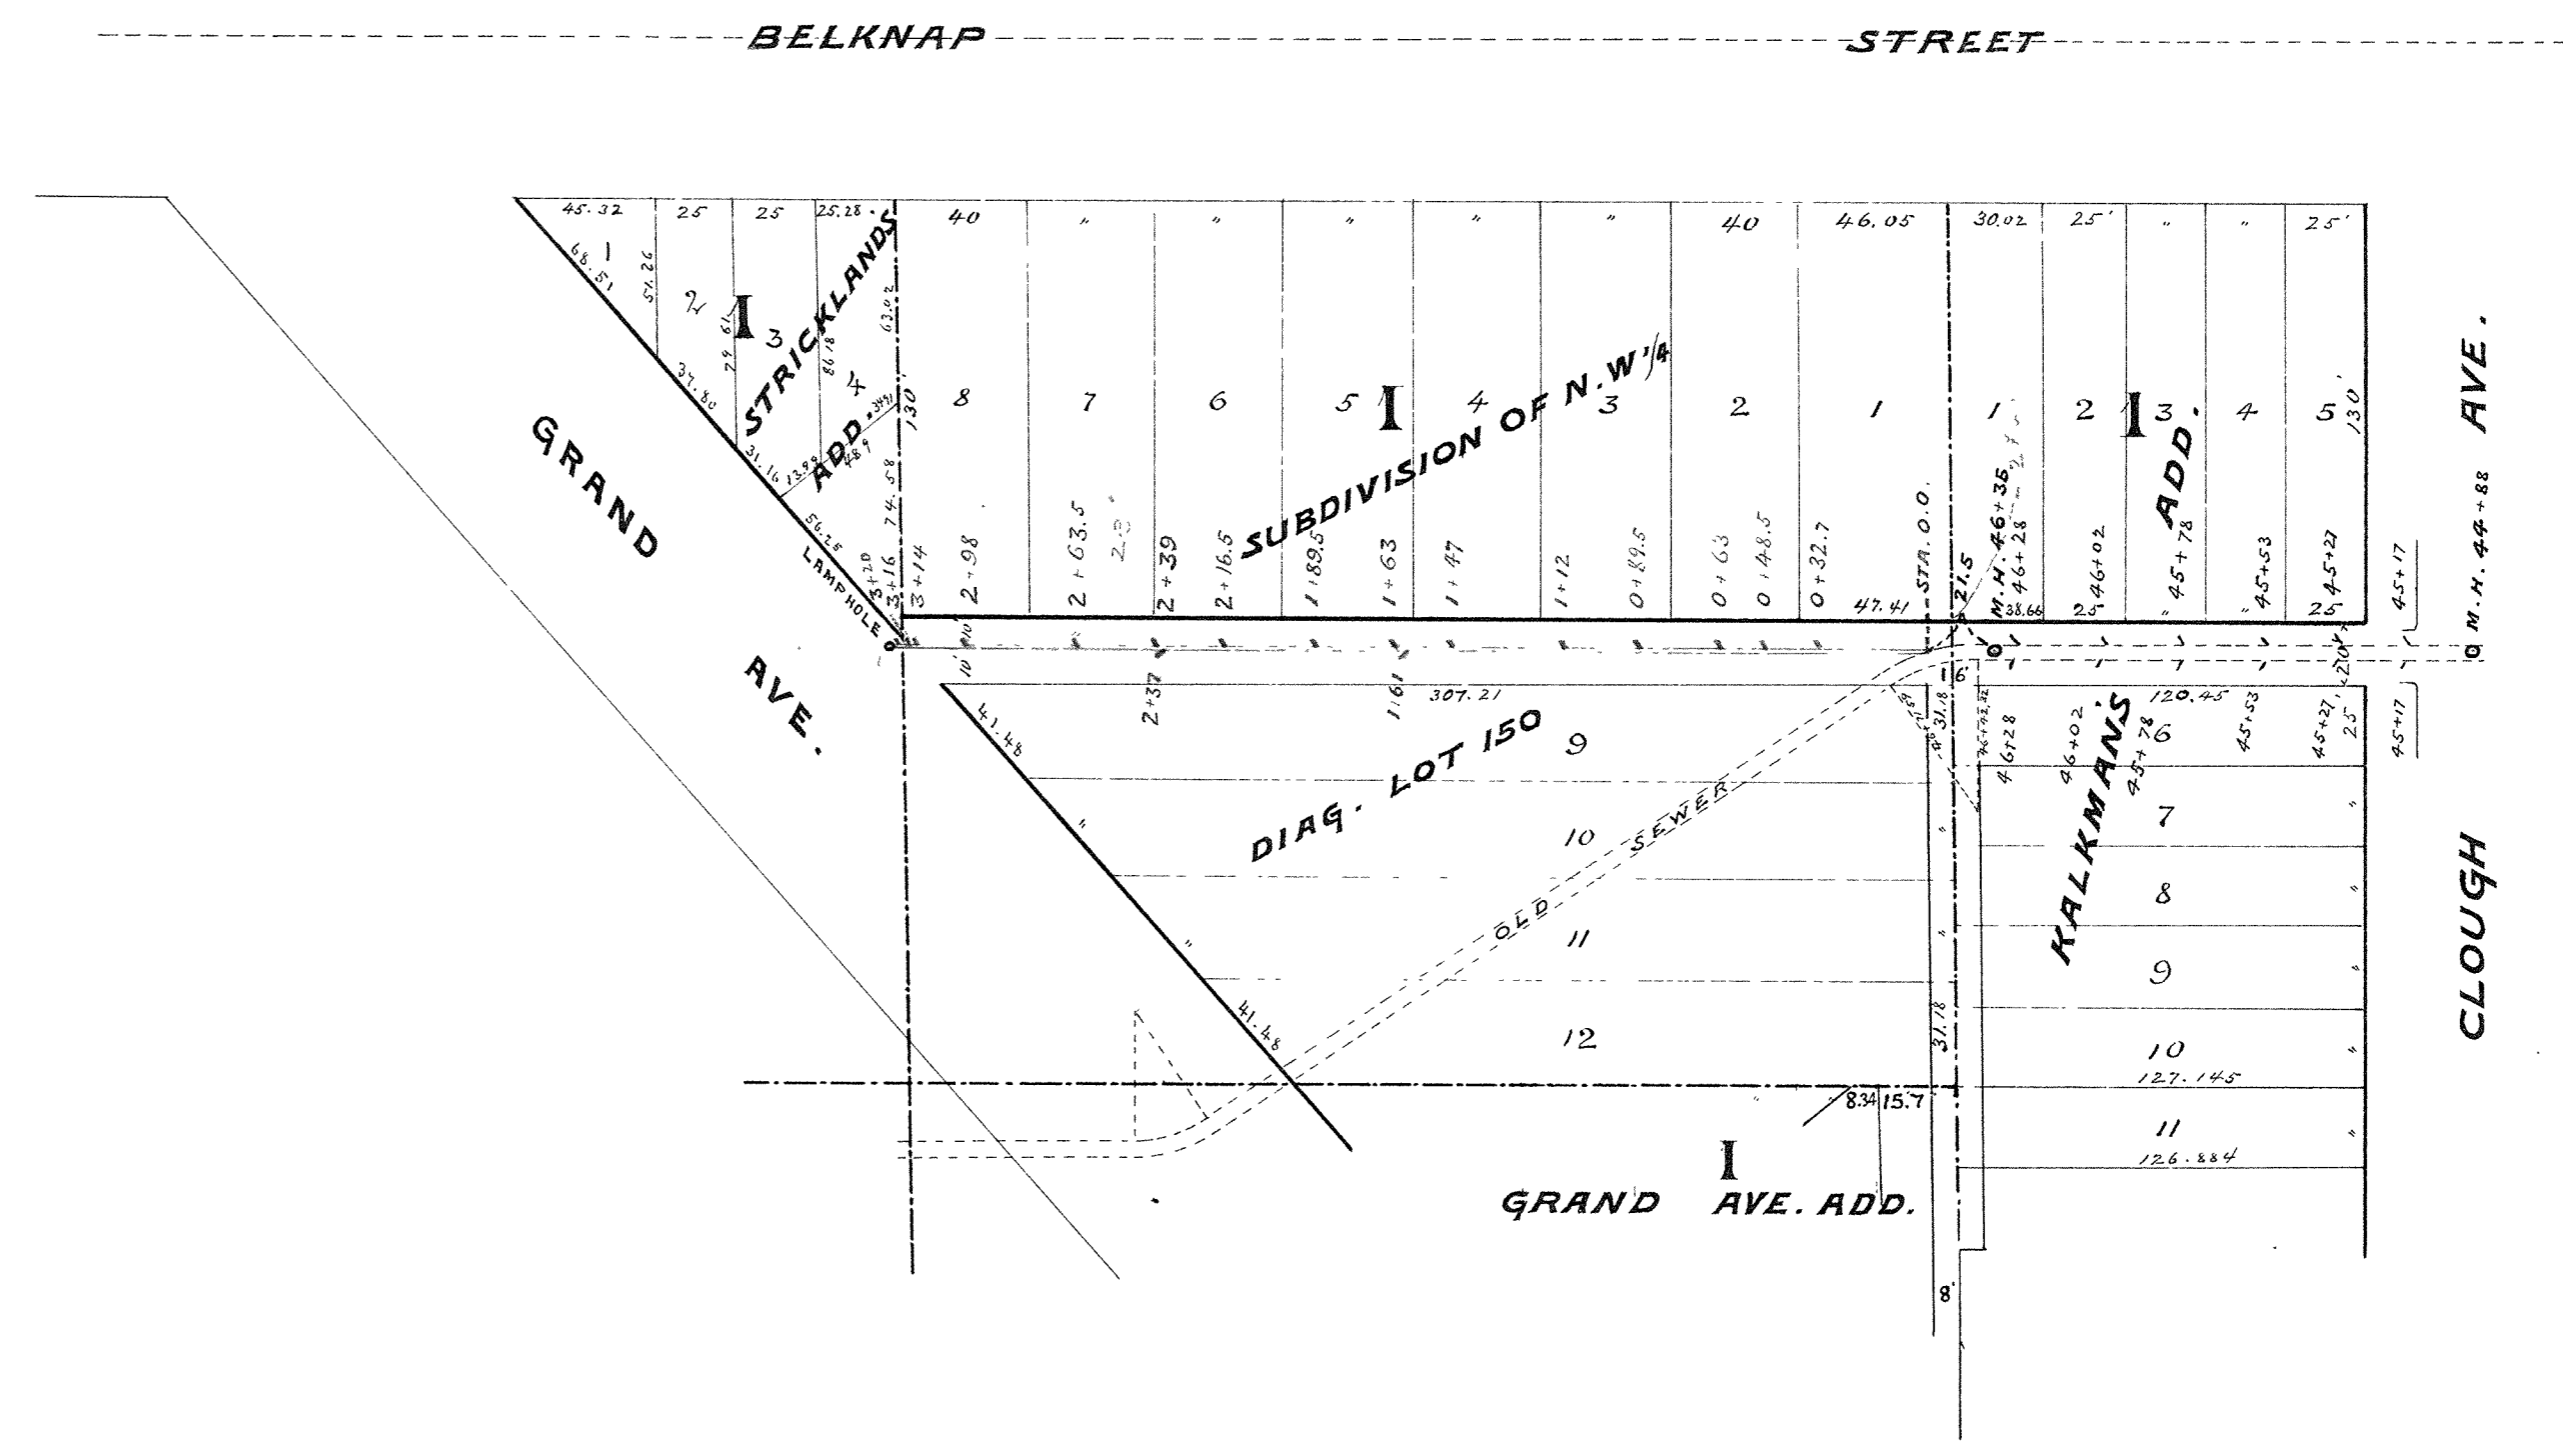

PROFILE OF SEWER IN ALLEY SOUTH OF BELKNAP BETWEEN COUGH & GRAND AVES.

2B-67

JAN. 1906. M. Spradley, S.E.E.