

CITY OF SUPERIOR SEWER PLAN

CONTRACT LET OCTOBER 5TH 1906


" COMPLETED NOV. 3RD "

JOHNSON & EKQUIST CONTRACTORS

FRITZ HENDERSON INSPECTOR

E. B. BANKS CITY ENGINEER

SCALE : { HORIZONTAL : 1" = 30 FT.
VERTICAL ... : 1" = 4 FT.

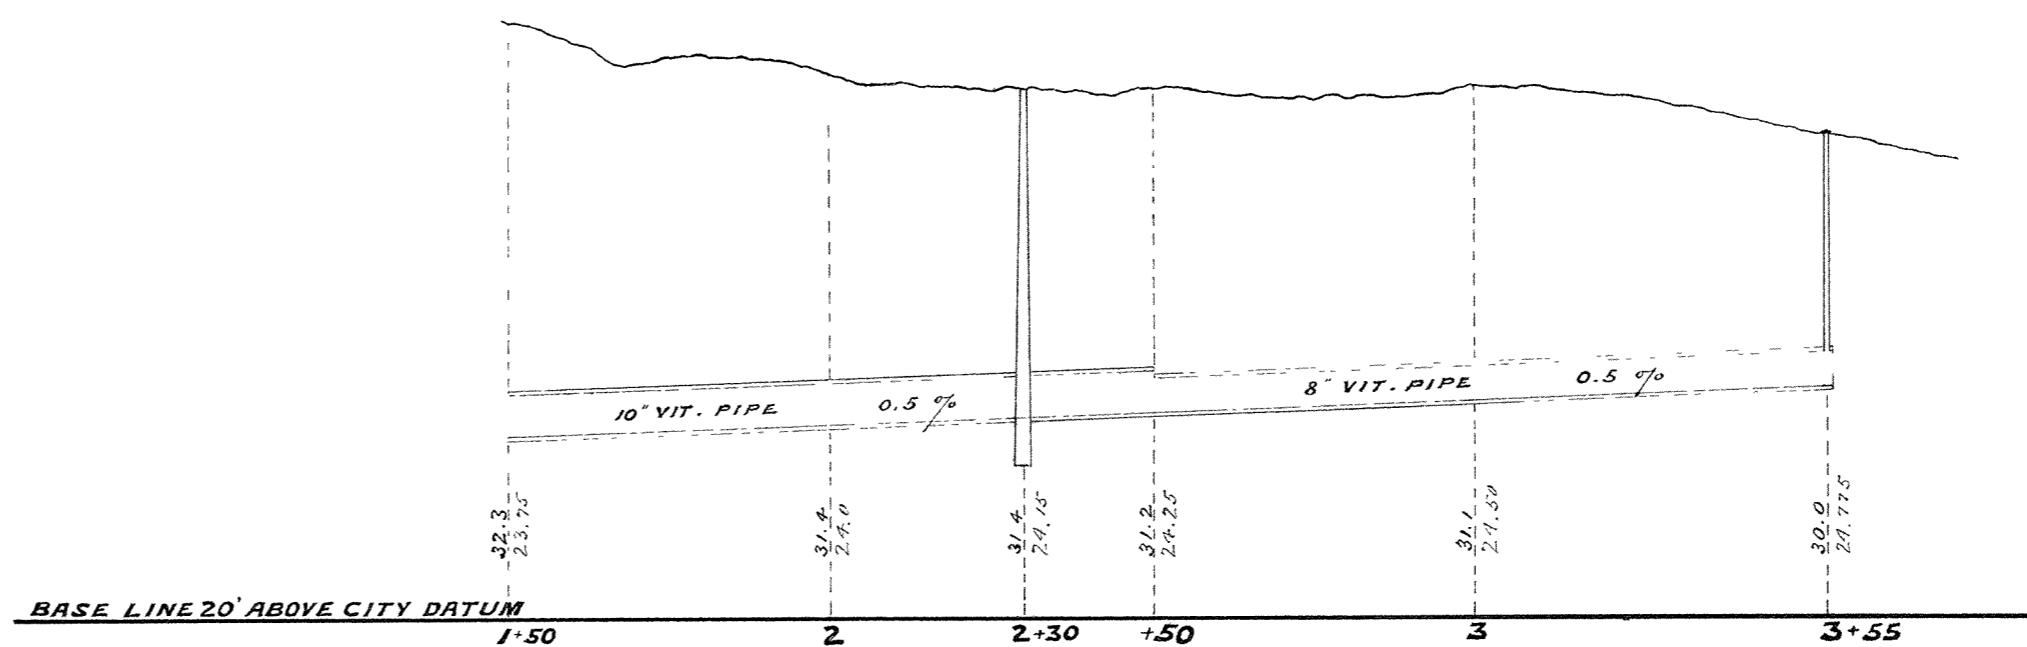

2B-68