


CITY OF SUPERIOR SEWER PLAN

Horizontal Scale: 1 inch = 60 feet.
Vertical Scale: 1 inch = 4 feet.

CONTRACT N° 1327
 Contract let..... June 17, 1912.
 Contract completed..... Aug. 15, 1912.
 John Anderson..... Contractor.
 A. Solin..... Inspector.
 D. Duffy..... Inspector.
 E. B. Banks..... City Engineer.

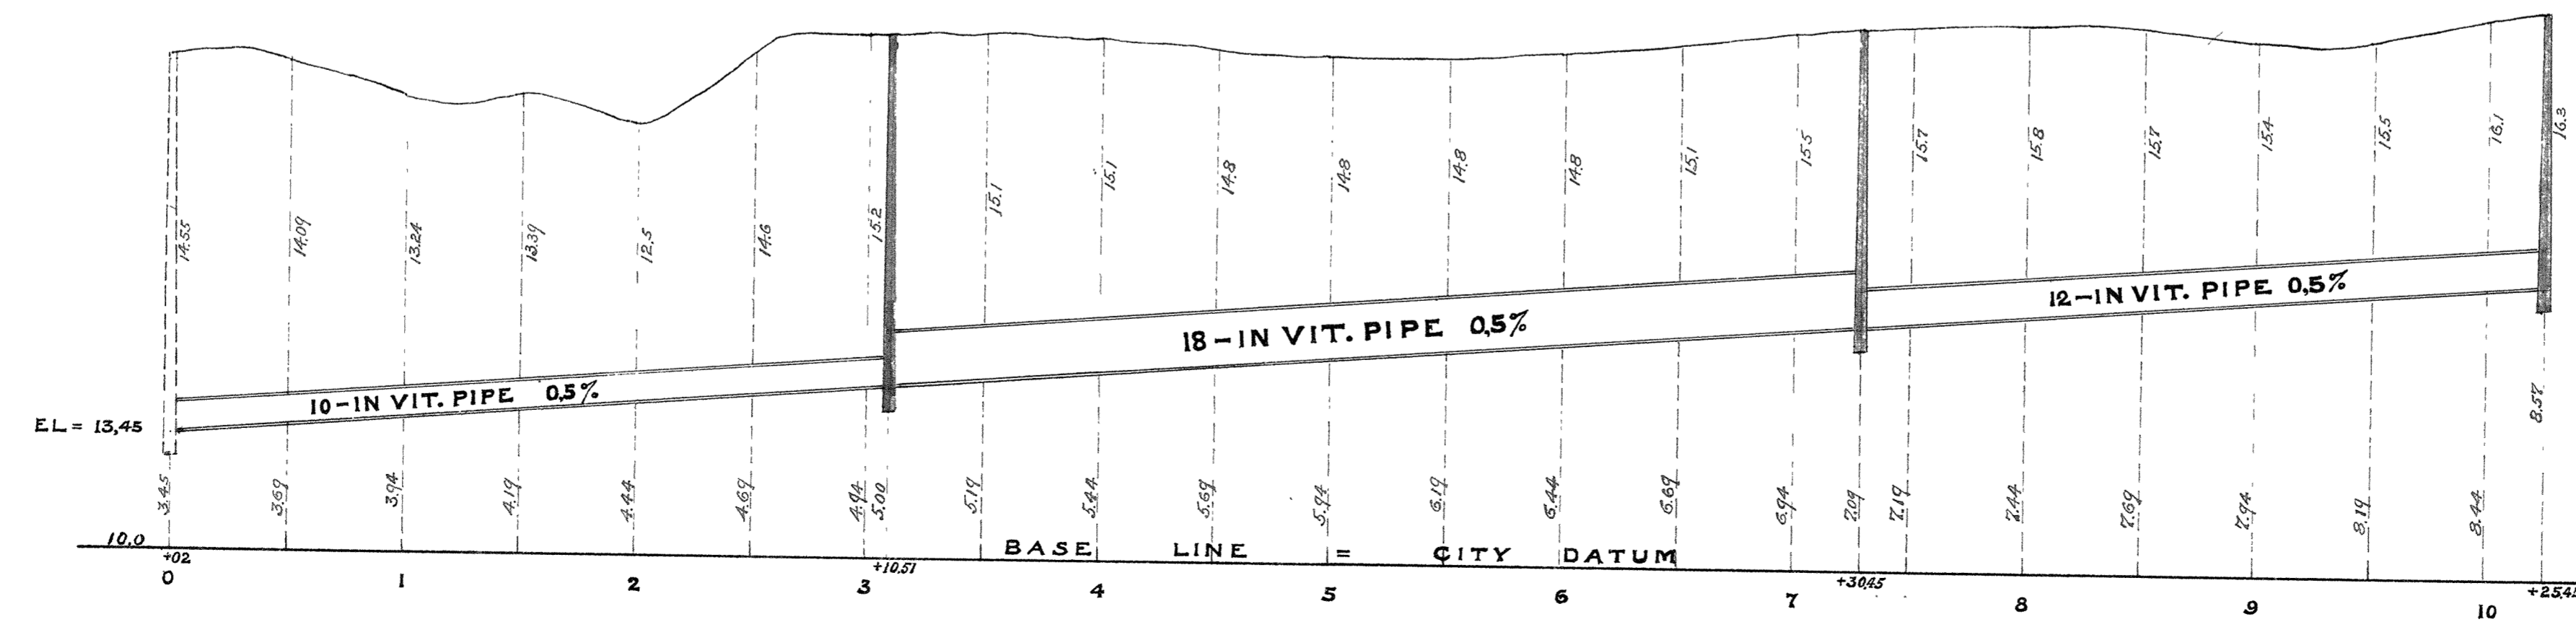

2B-73