


**CITY OF SUPERIOR**  
**SEWER PLAN.**  
 Horizontal Scale: lin. = 60 ft.  
 Vertical Scale: lin. = 4 ft.  
 CONTRACT No 1369  
 Contract let June 5, 13.  
 Contract completed Dec. 1, 13.  
 Russell Constr. Co. Contractors  
 J. B. Graham Inspector  
 E. B. Banks City Engineer.

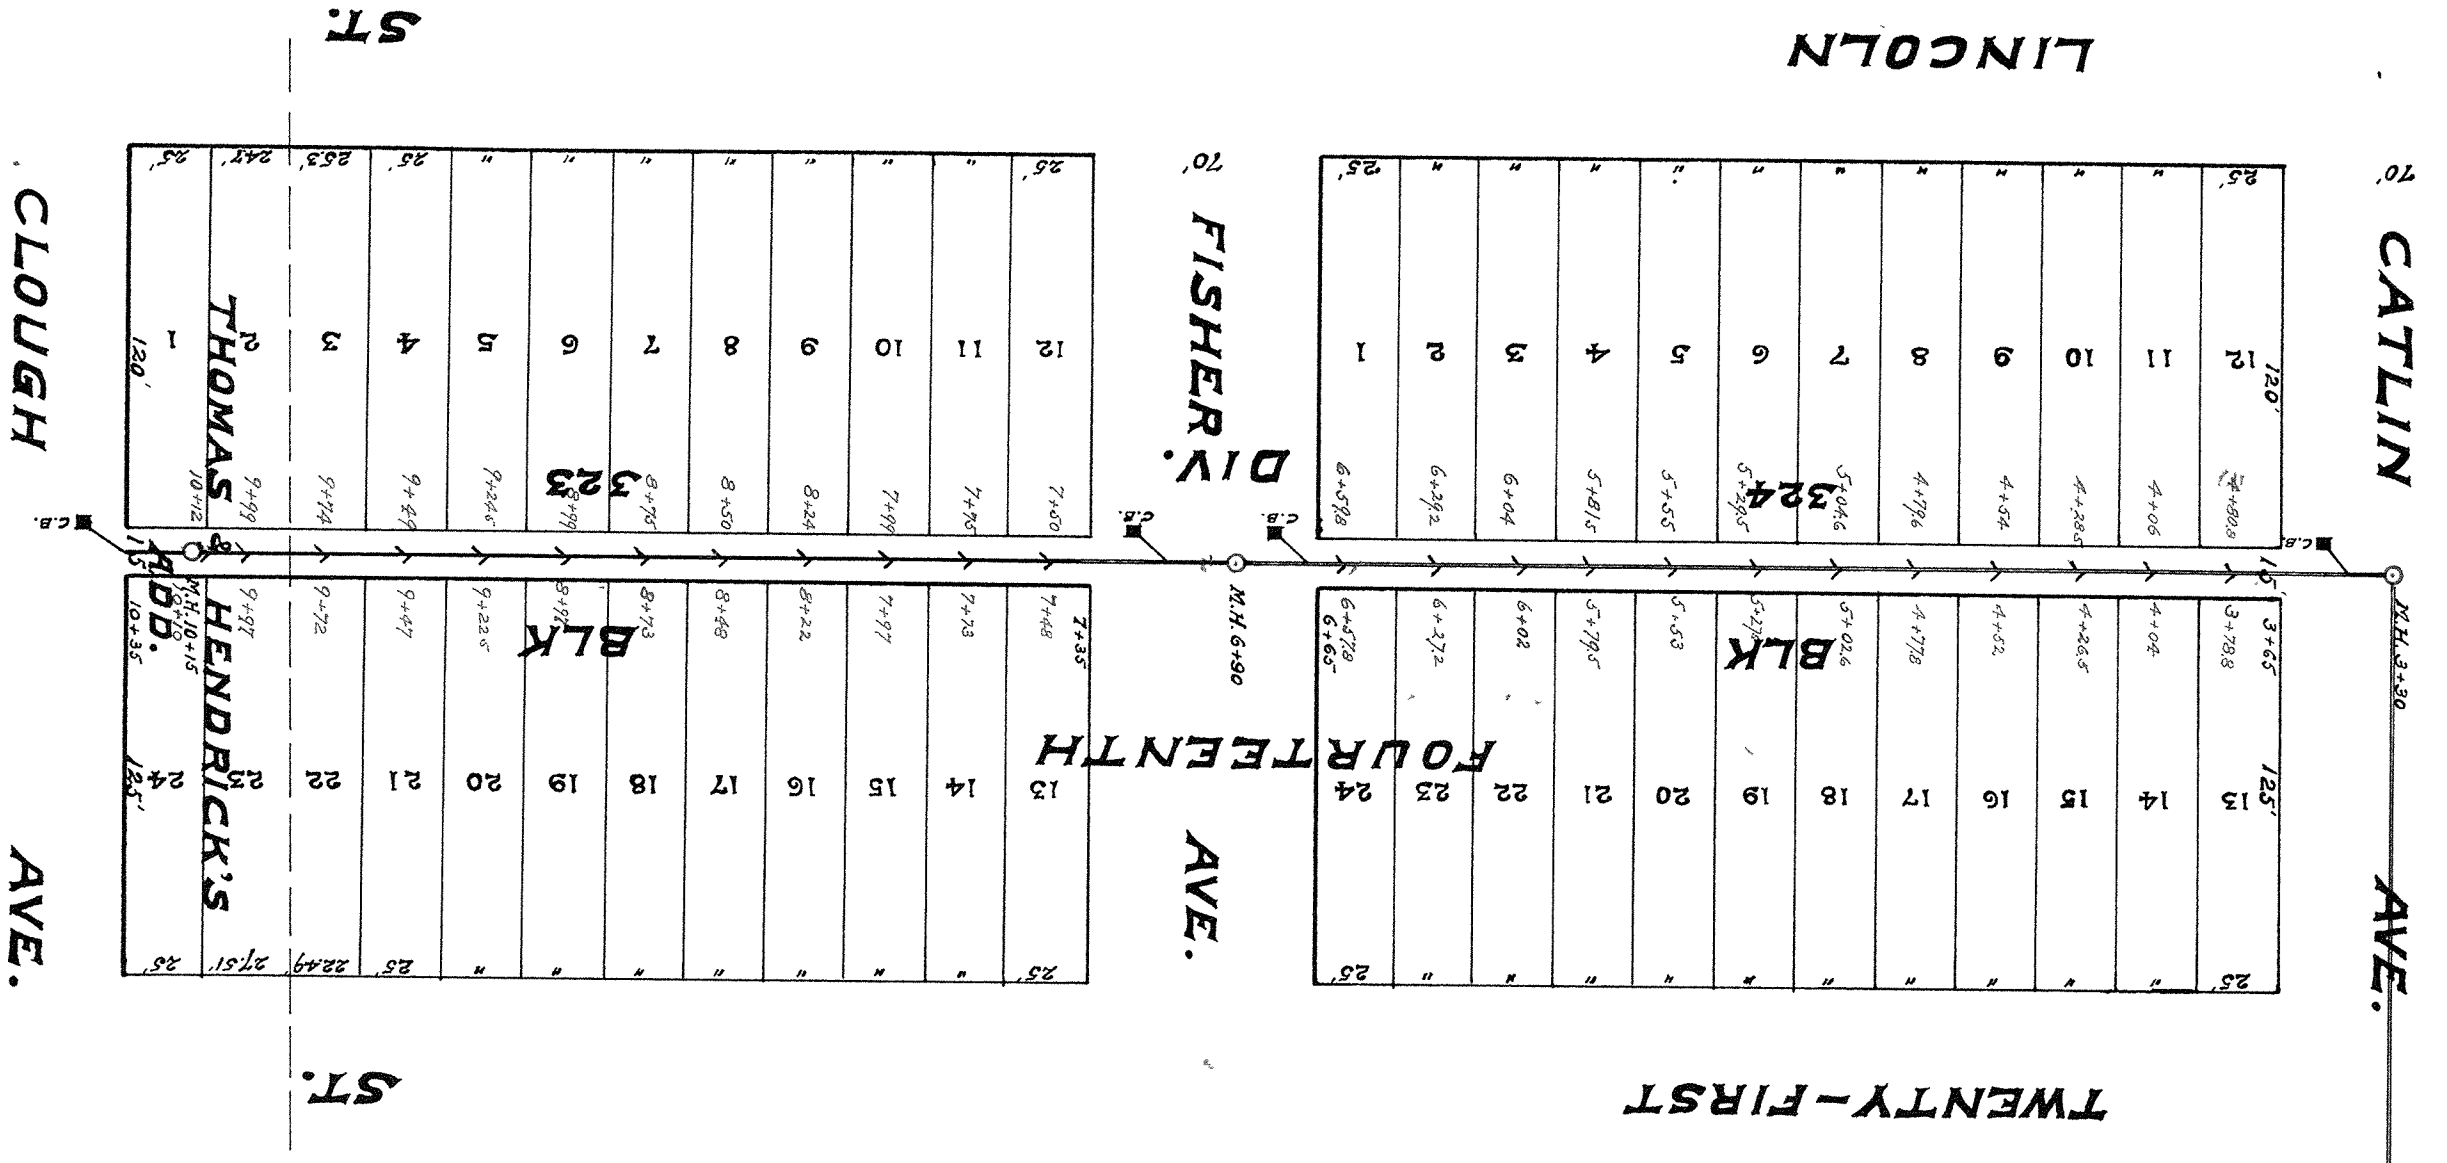

2B-75