

Horizontal Scale: 1 in. = 80 FT.
 Vertical Scale: 1 in. = 4 FT.

CONTRACT No. 1513.

Contract let Apr. 26th 1916.

Contract completed _____



Riches & Son _____ Contractor

J. B. Graham _____ Inspector

E. B. Banks _____ City Engineer.

RICHES CEMENT PIPE USED

5+0 TO 5+56 EXTENDED 1960
 CONTRACTOR - BUILDERS SUPPLY CO.
 MORTAR JOINTS

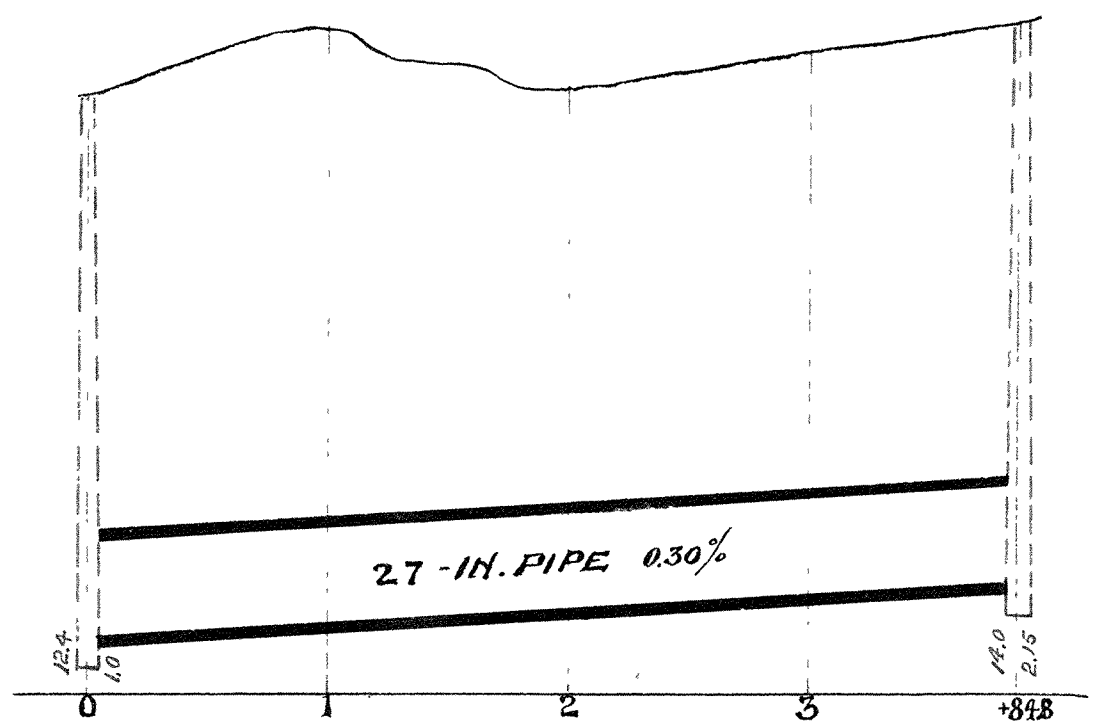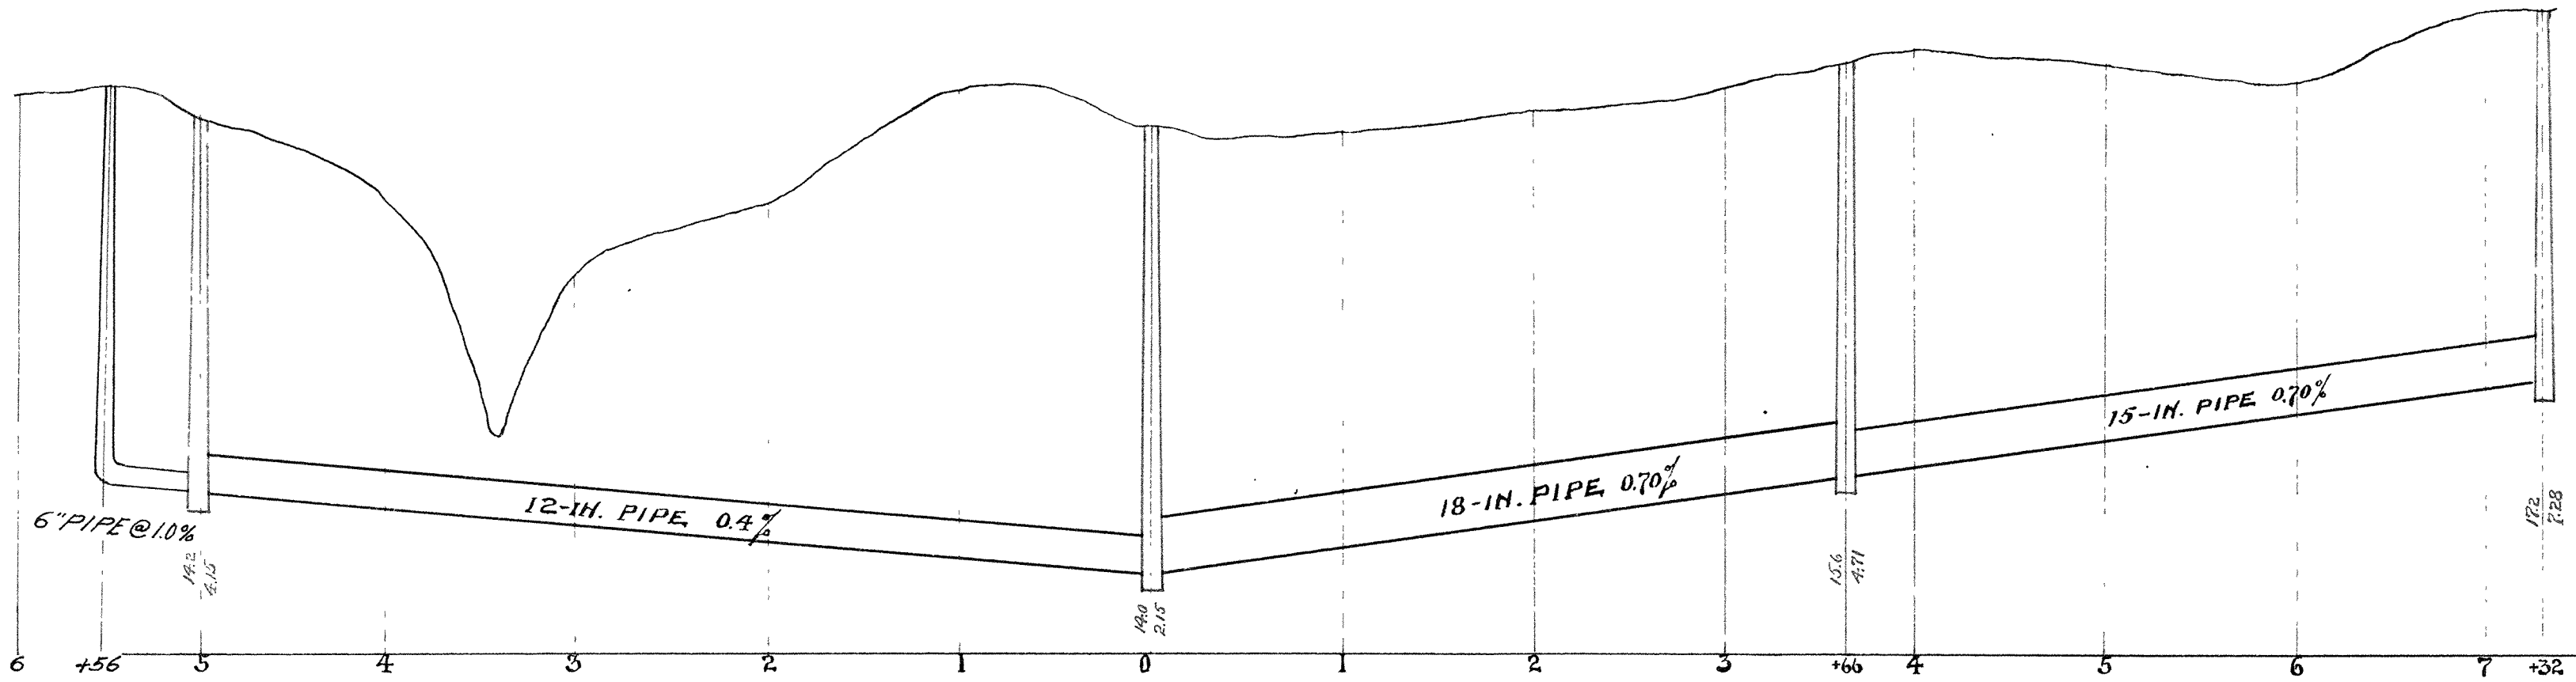

2B-80