

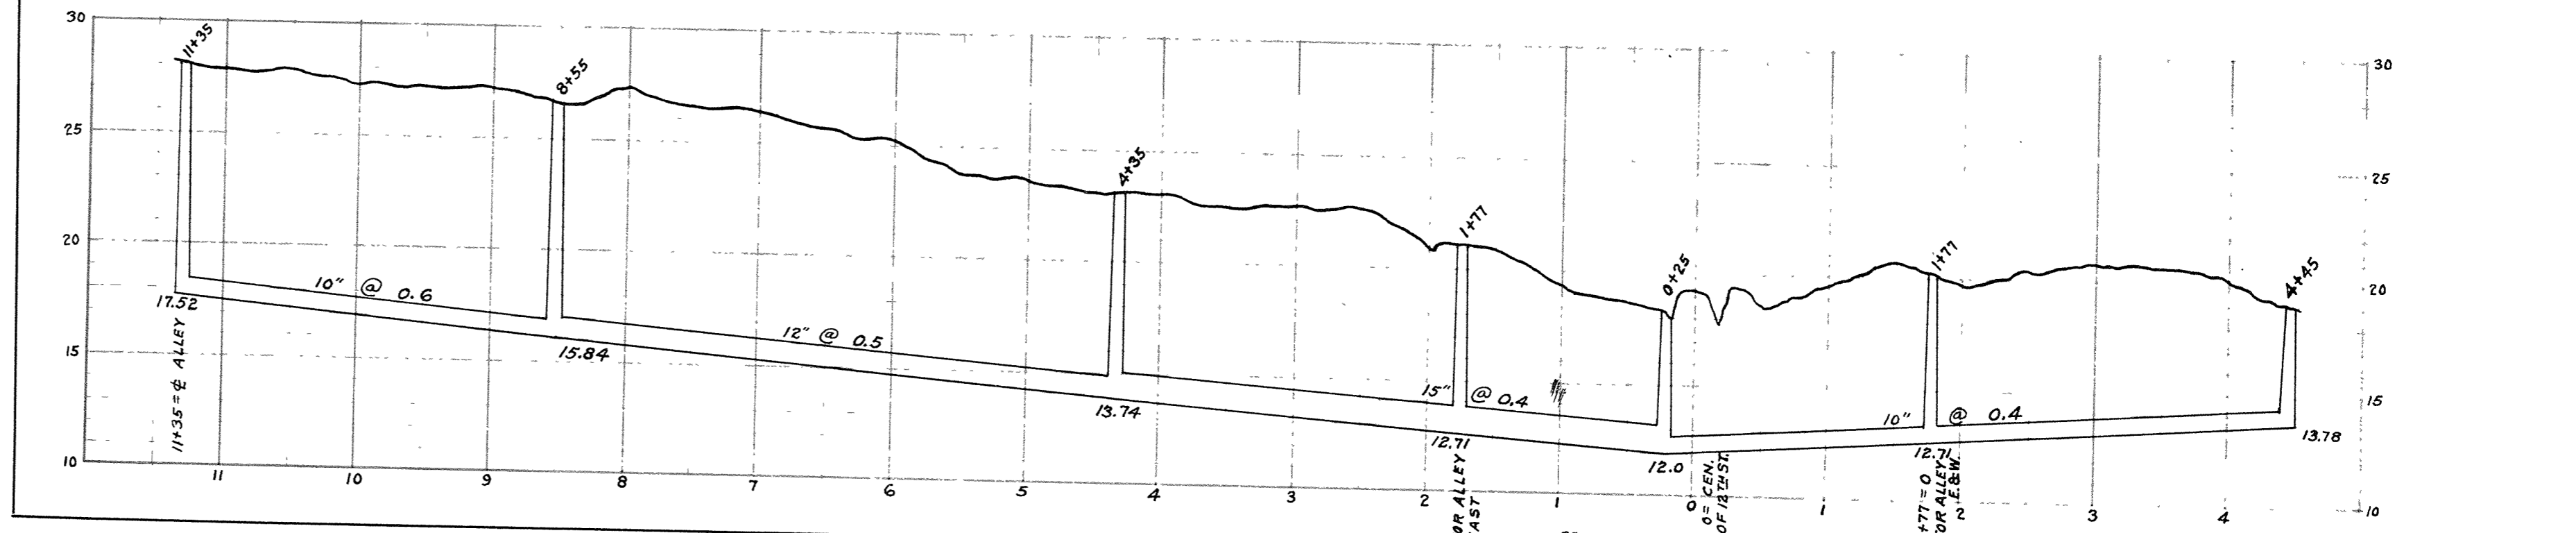
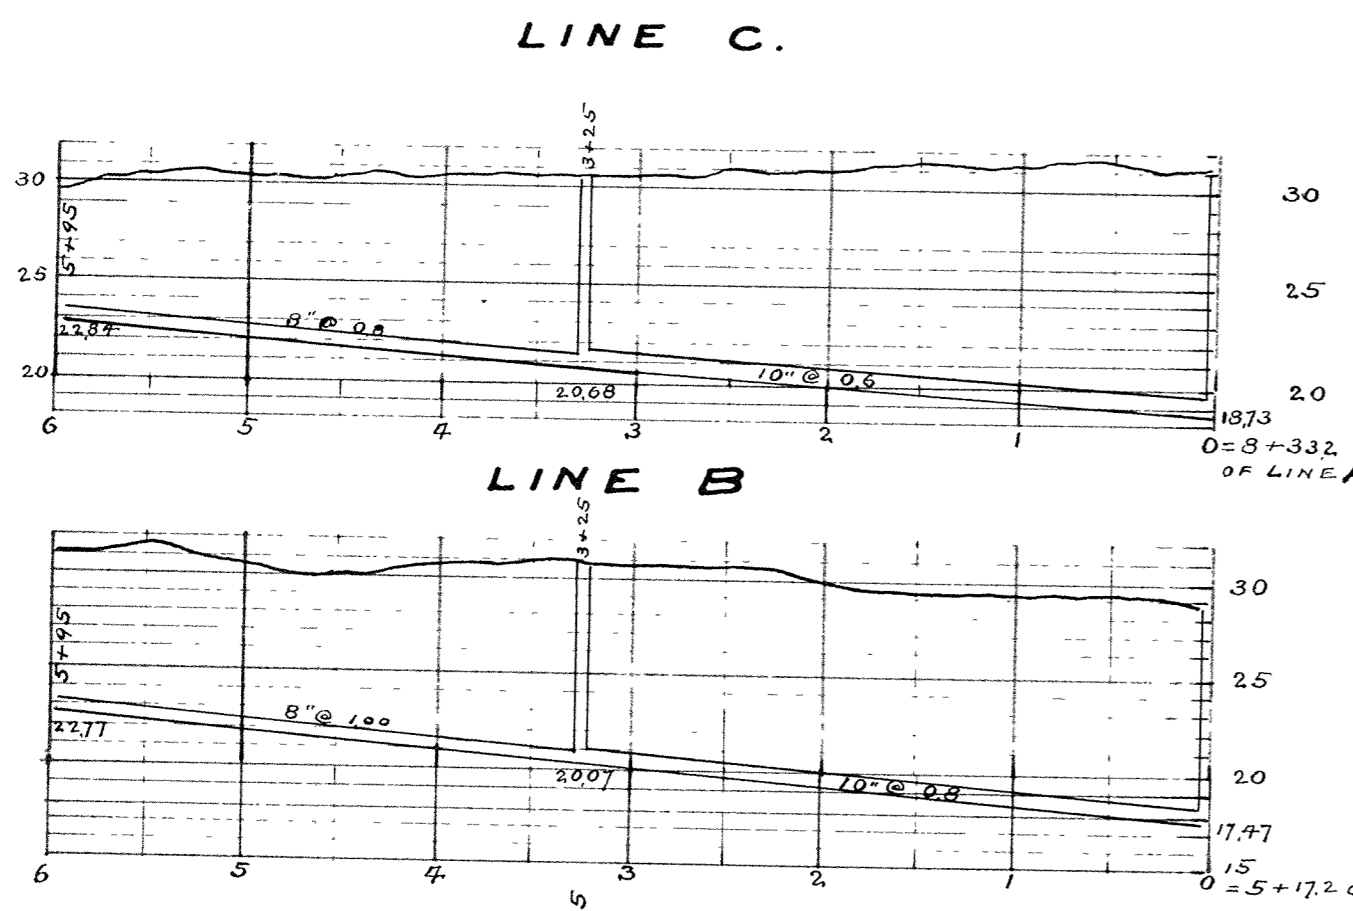
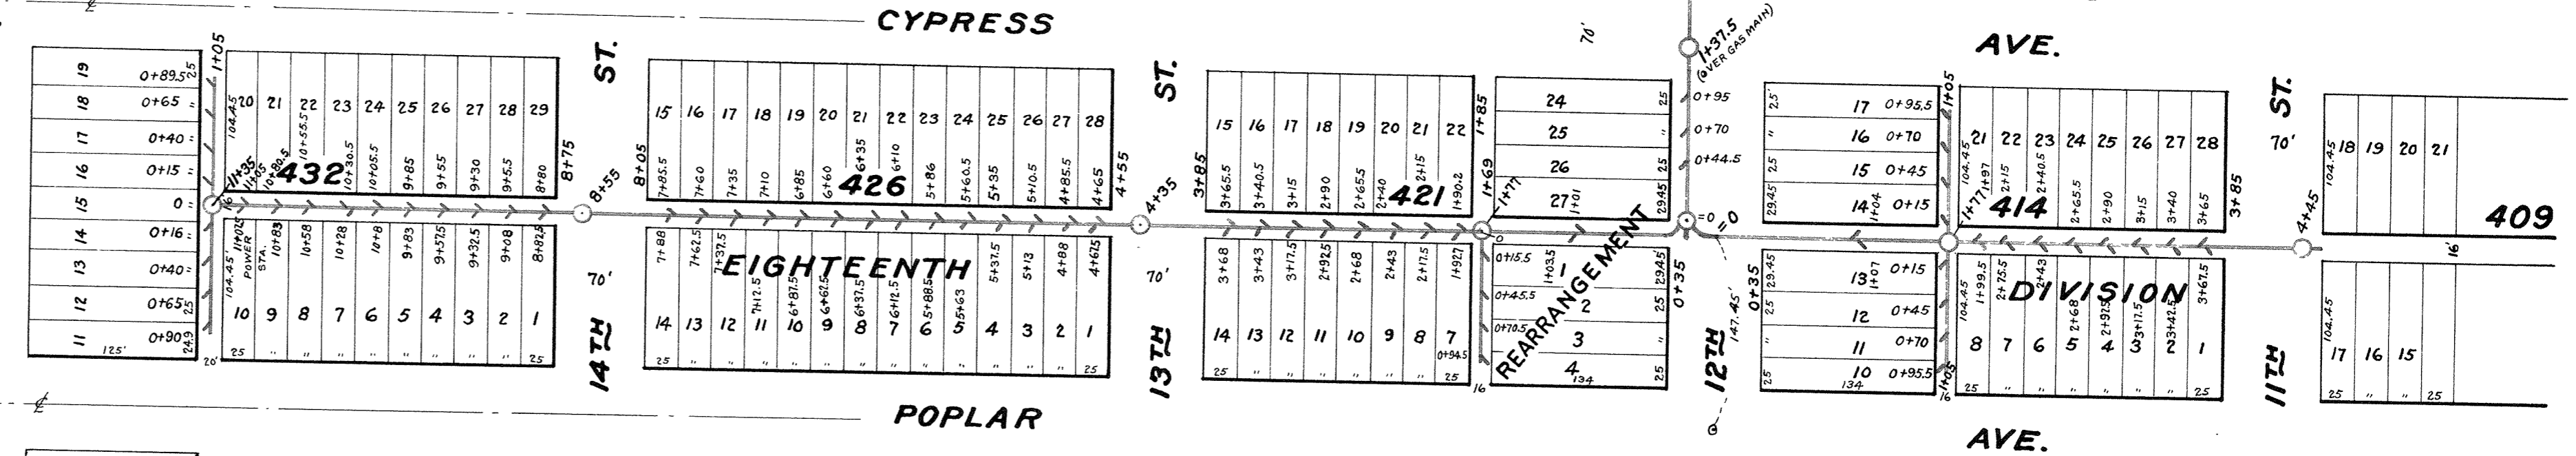


**MAP AND PROFILE**  
**SHOWING VITRIFIED PIPE SEWERS CONSTRUCTED**  
**IN THE ALLEYS BETWEEN**  
**CYPRESS AVE. AND POPLAR AVE.**  
**FROM BELKNAP ST. TO ELEVENTH ST.**  
 CONTRACT #1753    **MAGNUS PETERSON, CONTRACTOR**  
 CONTRACT AWARDED AUG. 14, 1928 - COMPLETED NOV. 15, 1928  
 BYRON KIMBALL, INSPECTOR    **E.B. BANKS, CITY ENGINEER**  
 SCALE: 1" = 100'

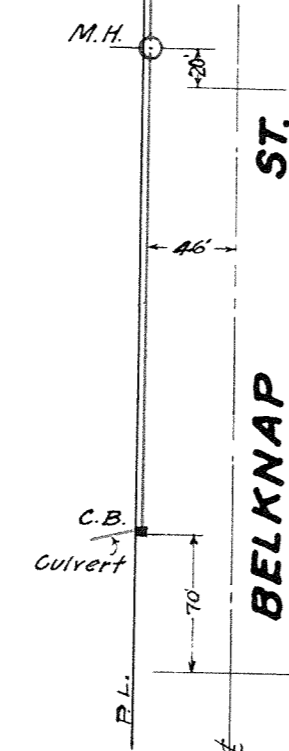

**SEWER BUILT BY OWNER**  
**THE ALLOUEZ LUMBER CO.**  
**UNDER SUPERVISION OF E.M. STEFFENSON**  
**SEWER INSPTR.**  
**COMPLETED FEB. 23<sup>RD</sup>, 1924**  
 SCALE 1" = 100'

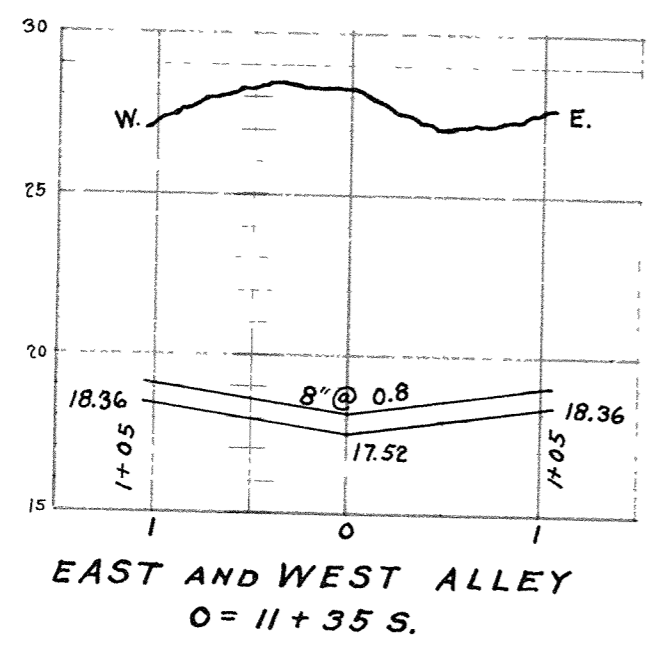