


9/07/18 INVESTIGATED SAN. SERV. FROM SALES BLDG. DYED LINE. CAME OUT IN IN MH TO WEST. CITY #020115 PLAN HAD LINE BEING GROUTED DID NOT GROUT.

**RECORD DRAWINGS
UPDATED 01/2019**

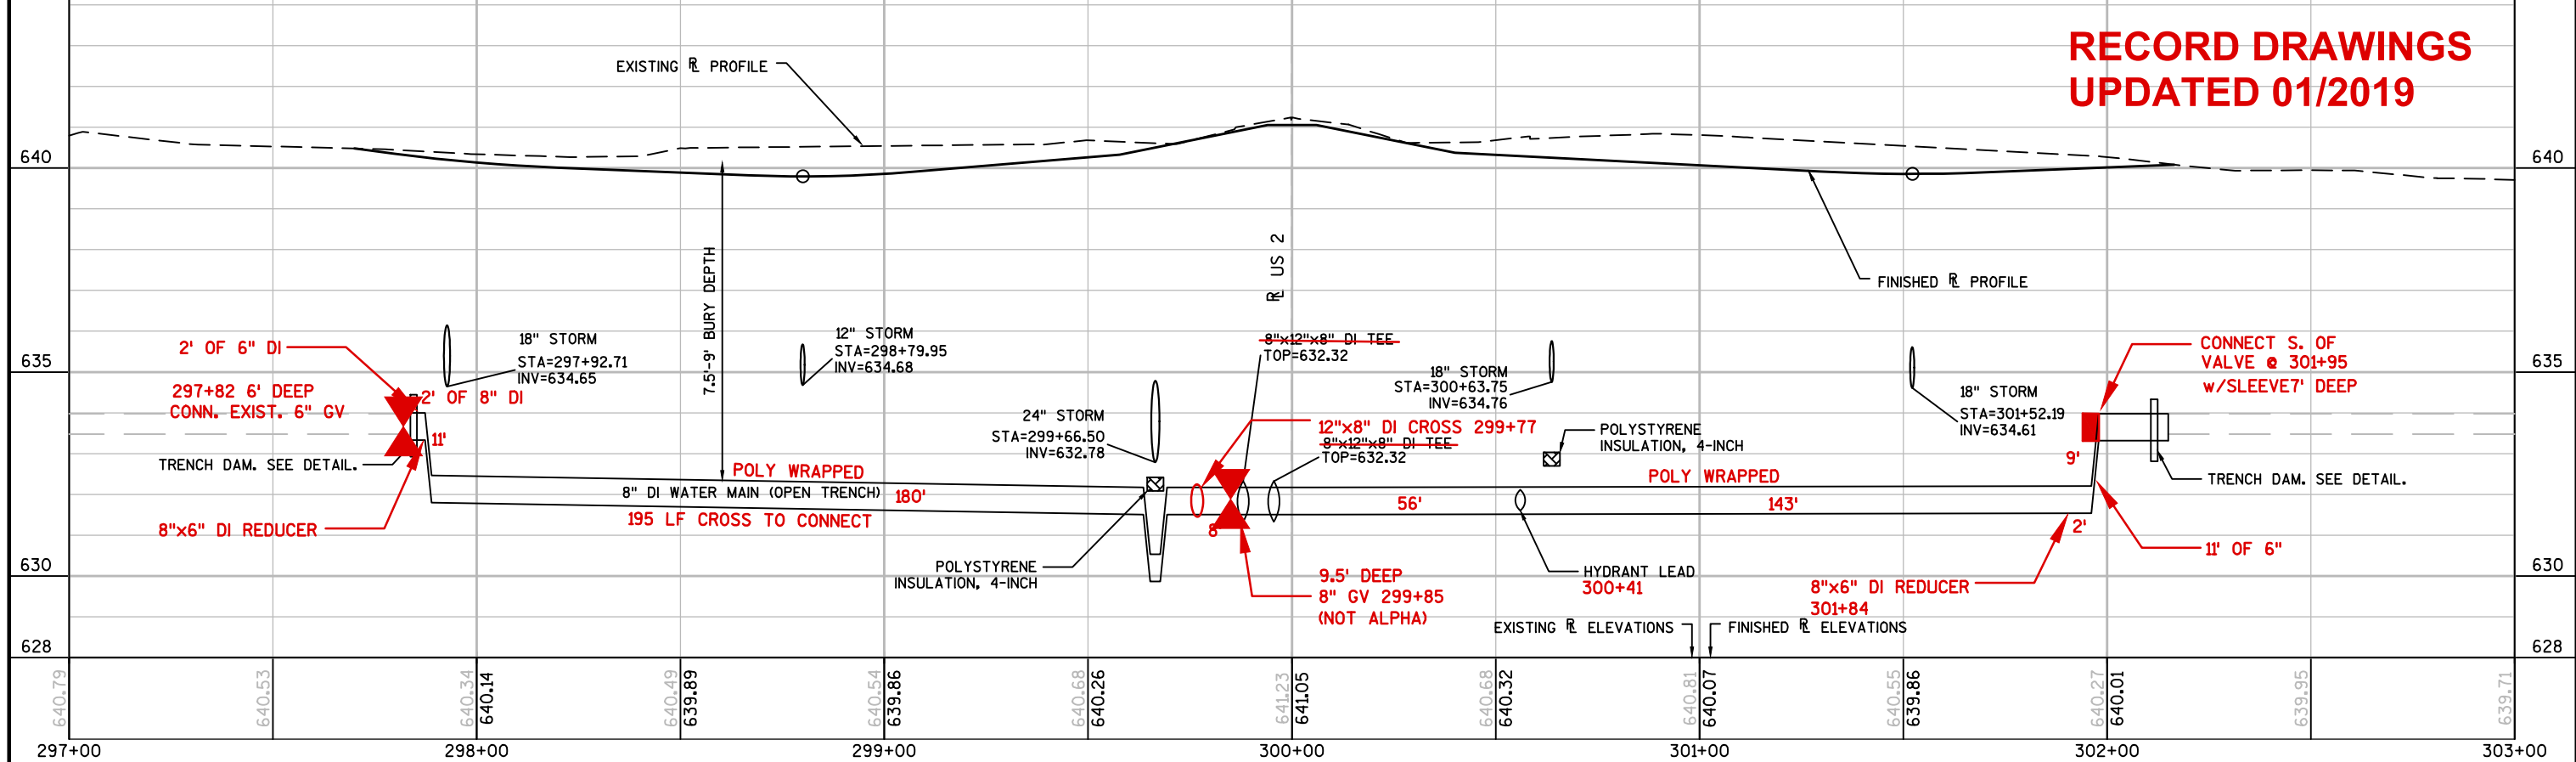

PROJECT NO: 8680-00-72	HWY: US 2-BELKNAP STREET	COUNTY: DOUGLAS	PLAN AND PROFILE: JOHN AVENUE	SHEET	E
------------------------	--------------------------	-----------------	-------------------------------	-------	----------