
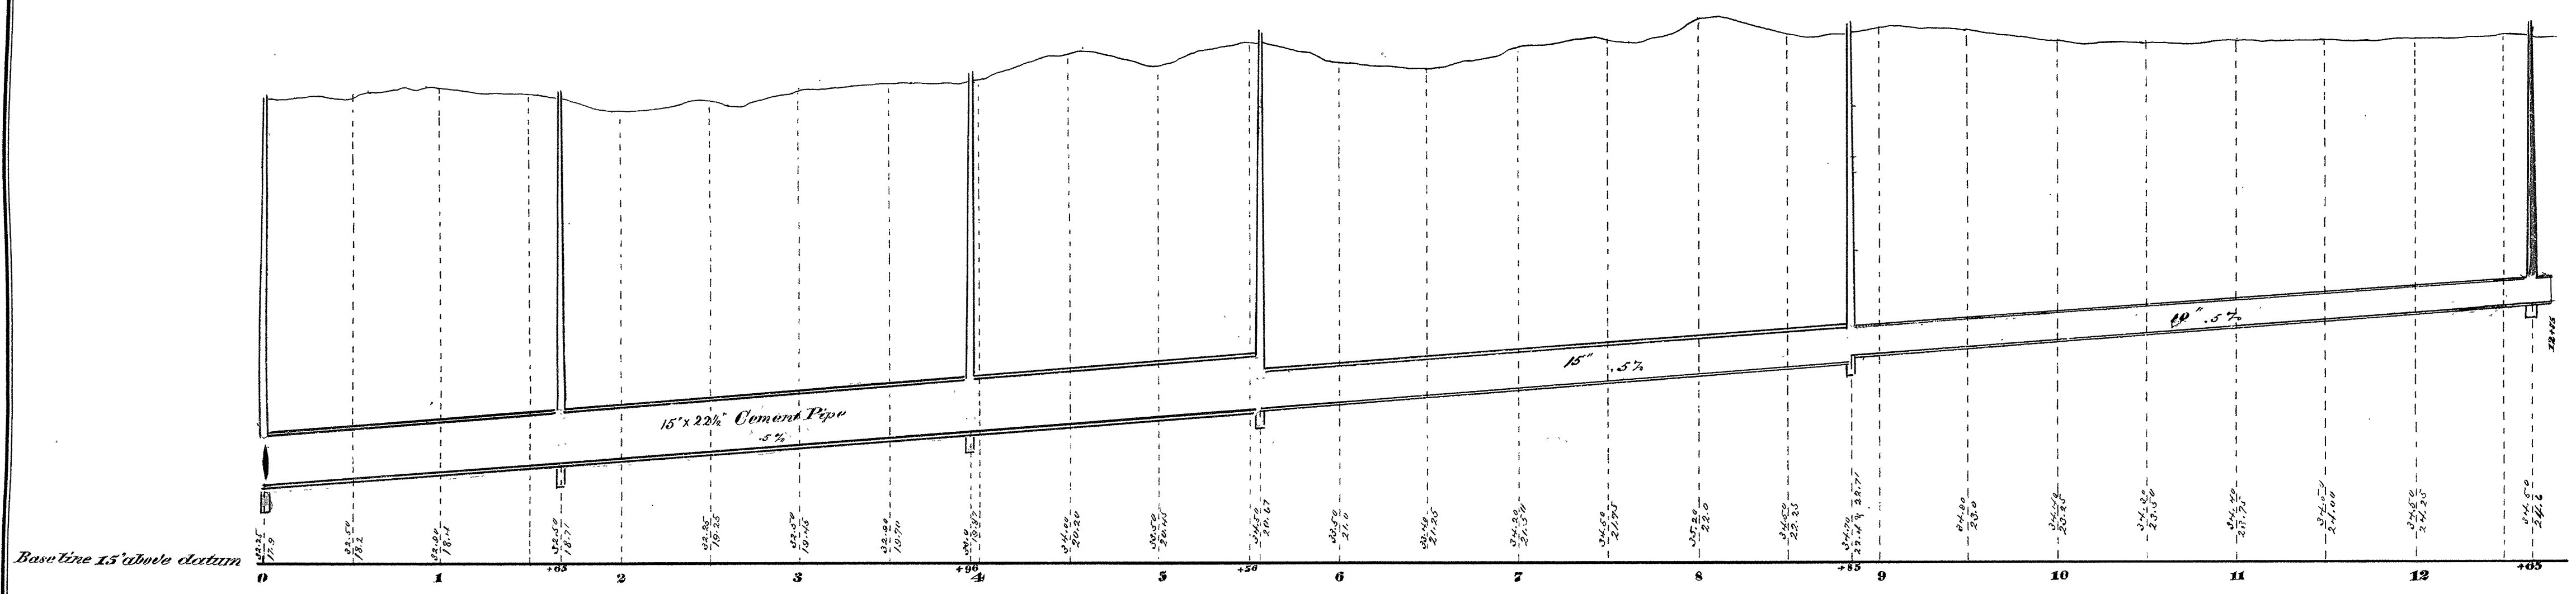
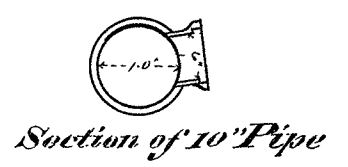
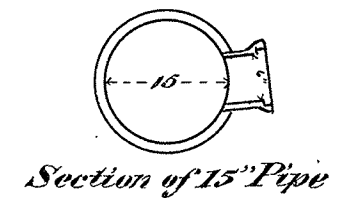


CITY OF SUPERIOR

SEWER PLAN

Contract let Sept. 17, 1890
 " completed June 1, 1891
 Gleason Bros. & Rubyour, Contractor
 Smith & Richardson, Inspectors
 E. B. Banks, City Eng.

Scale: $\left\{ \begin{array}{l} \text{Horizontal } 60' = 1'' \\ \text{Vertical } 2' = 1'' \\ \text{Section } 2' = 1'' \end{array} \right.$

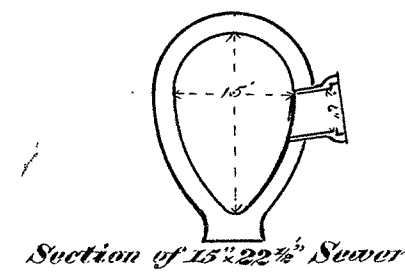

Plan & Profile of Sewer in Baker Ave. & W. Fifth St. to Alley betw. Baker & Walker Aves. & from thence in Alley betw. W. Fifth & W. Sixth Strs. to Richardson Ave.