
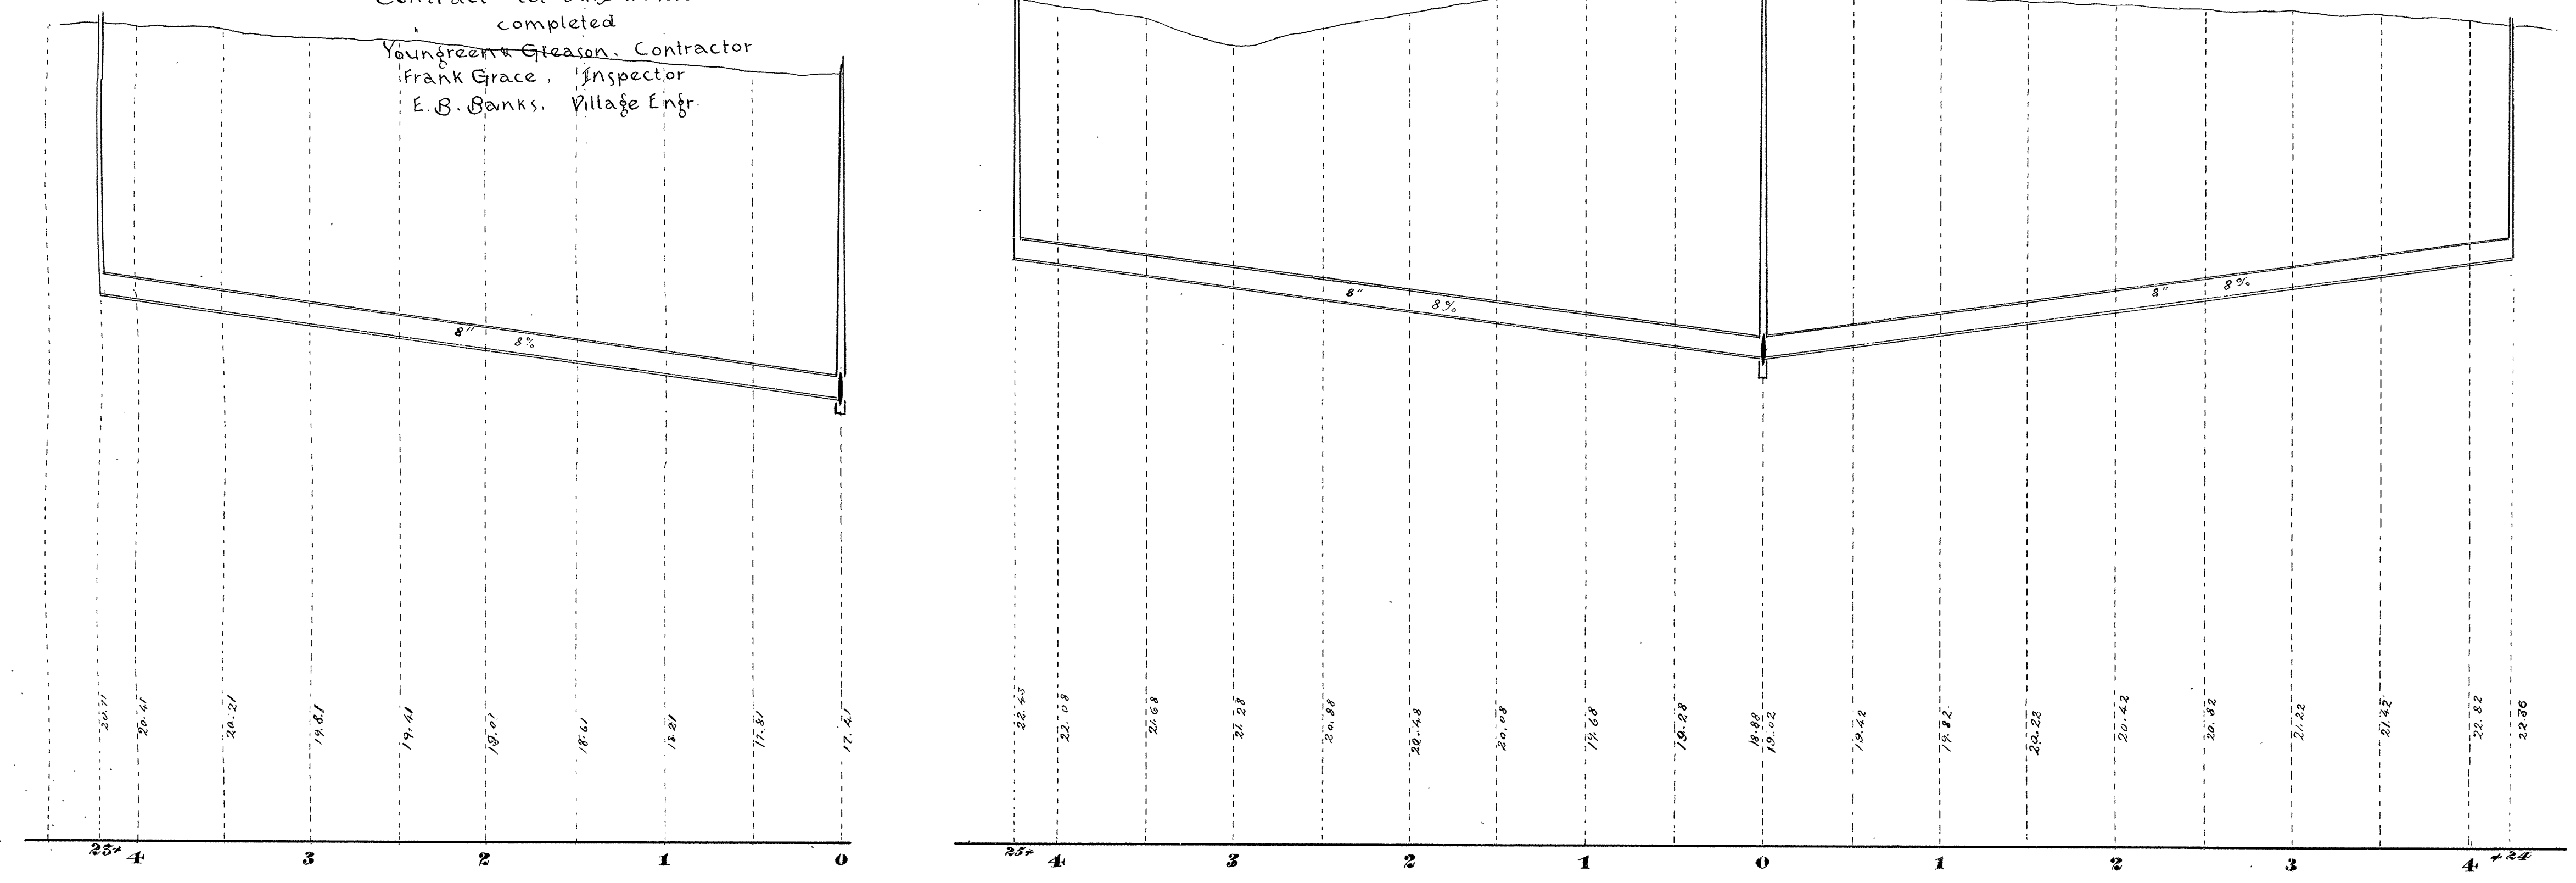


**VILLAGE OF SUPERIOR**  
**SEWER PLAN**  
 1893

Contract let July 17, 1888  
 completed  
 Youngren & Gleason, Contractor  
 Frank Grace, Inspector  
 E. B. Banks, Village Engr.

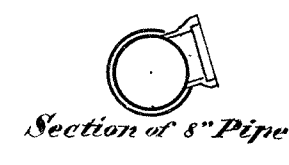

Scale: { Horizontal 1" = 60'  
 Vertical 1" = 4'  
 Section 1" = 2'

Plan & Profile of Sewer in Alley betw. Second and Third St. from Thompson to Becker Ave., also betw. Third and Fourth St. from Stinson to Becker Ave.