


Scale: { Horizontal 1" = 60'
Vertical 1" = 4'
Section 1" = 2'

CITY OF SUPERIOR
SEWER PLAN
Contract let May 25, 1891
completed Aug. 8, 1891
Thos. White & Co., Contractor
Frank Richardson, Inspector
E. B. Banks, City Engr.

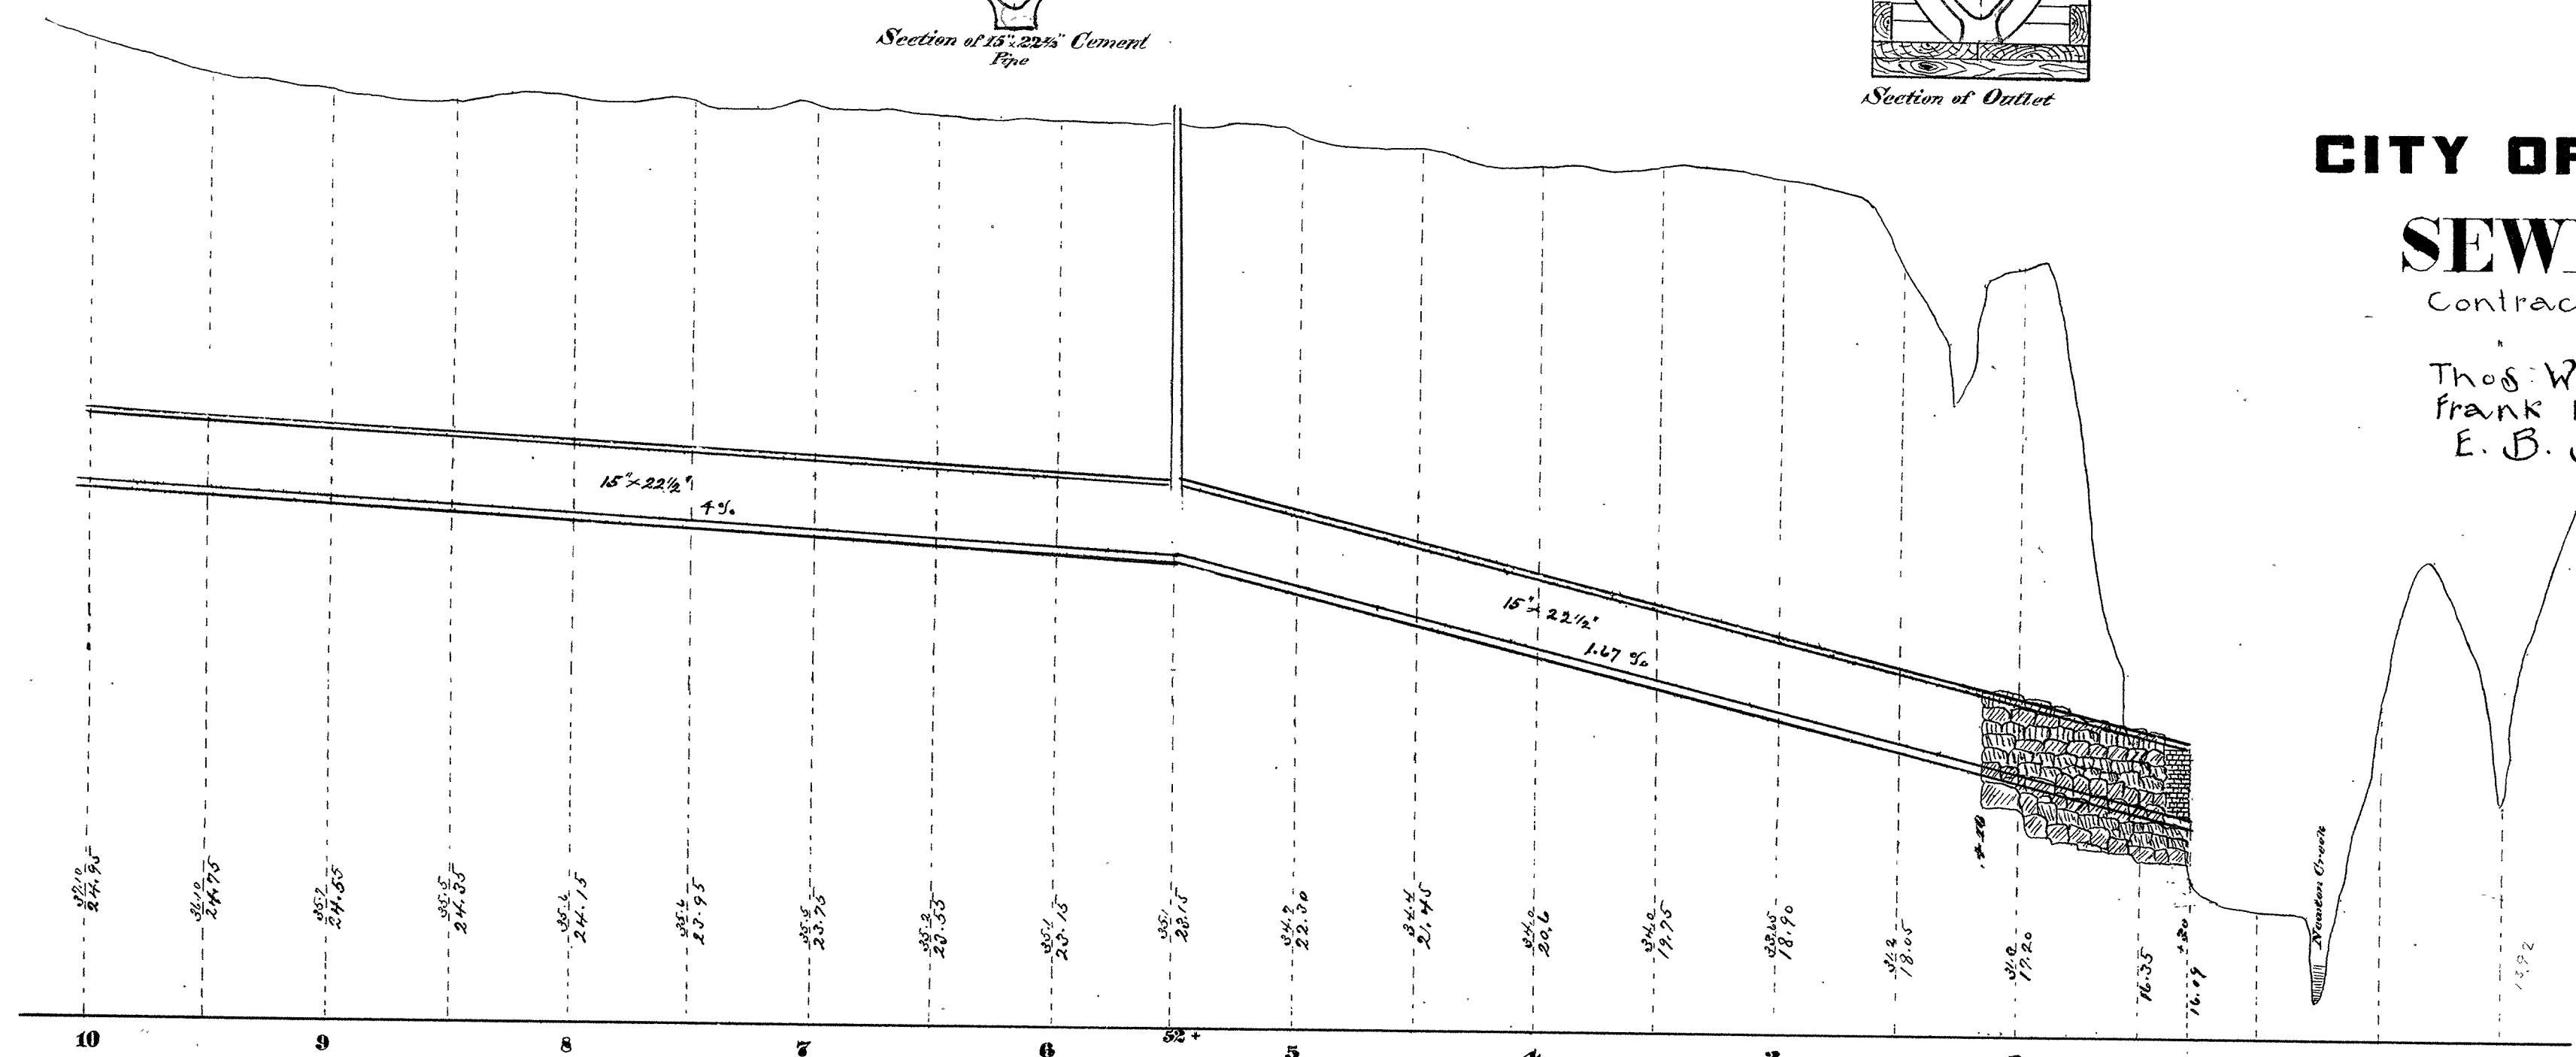

Plan & Profile of Sewer in Alley betw. W. Eighth and W. Ninth Sts. from Newton to Thompson Ave.