



E. SIXTH ST.

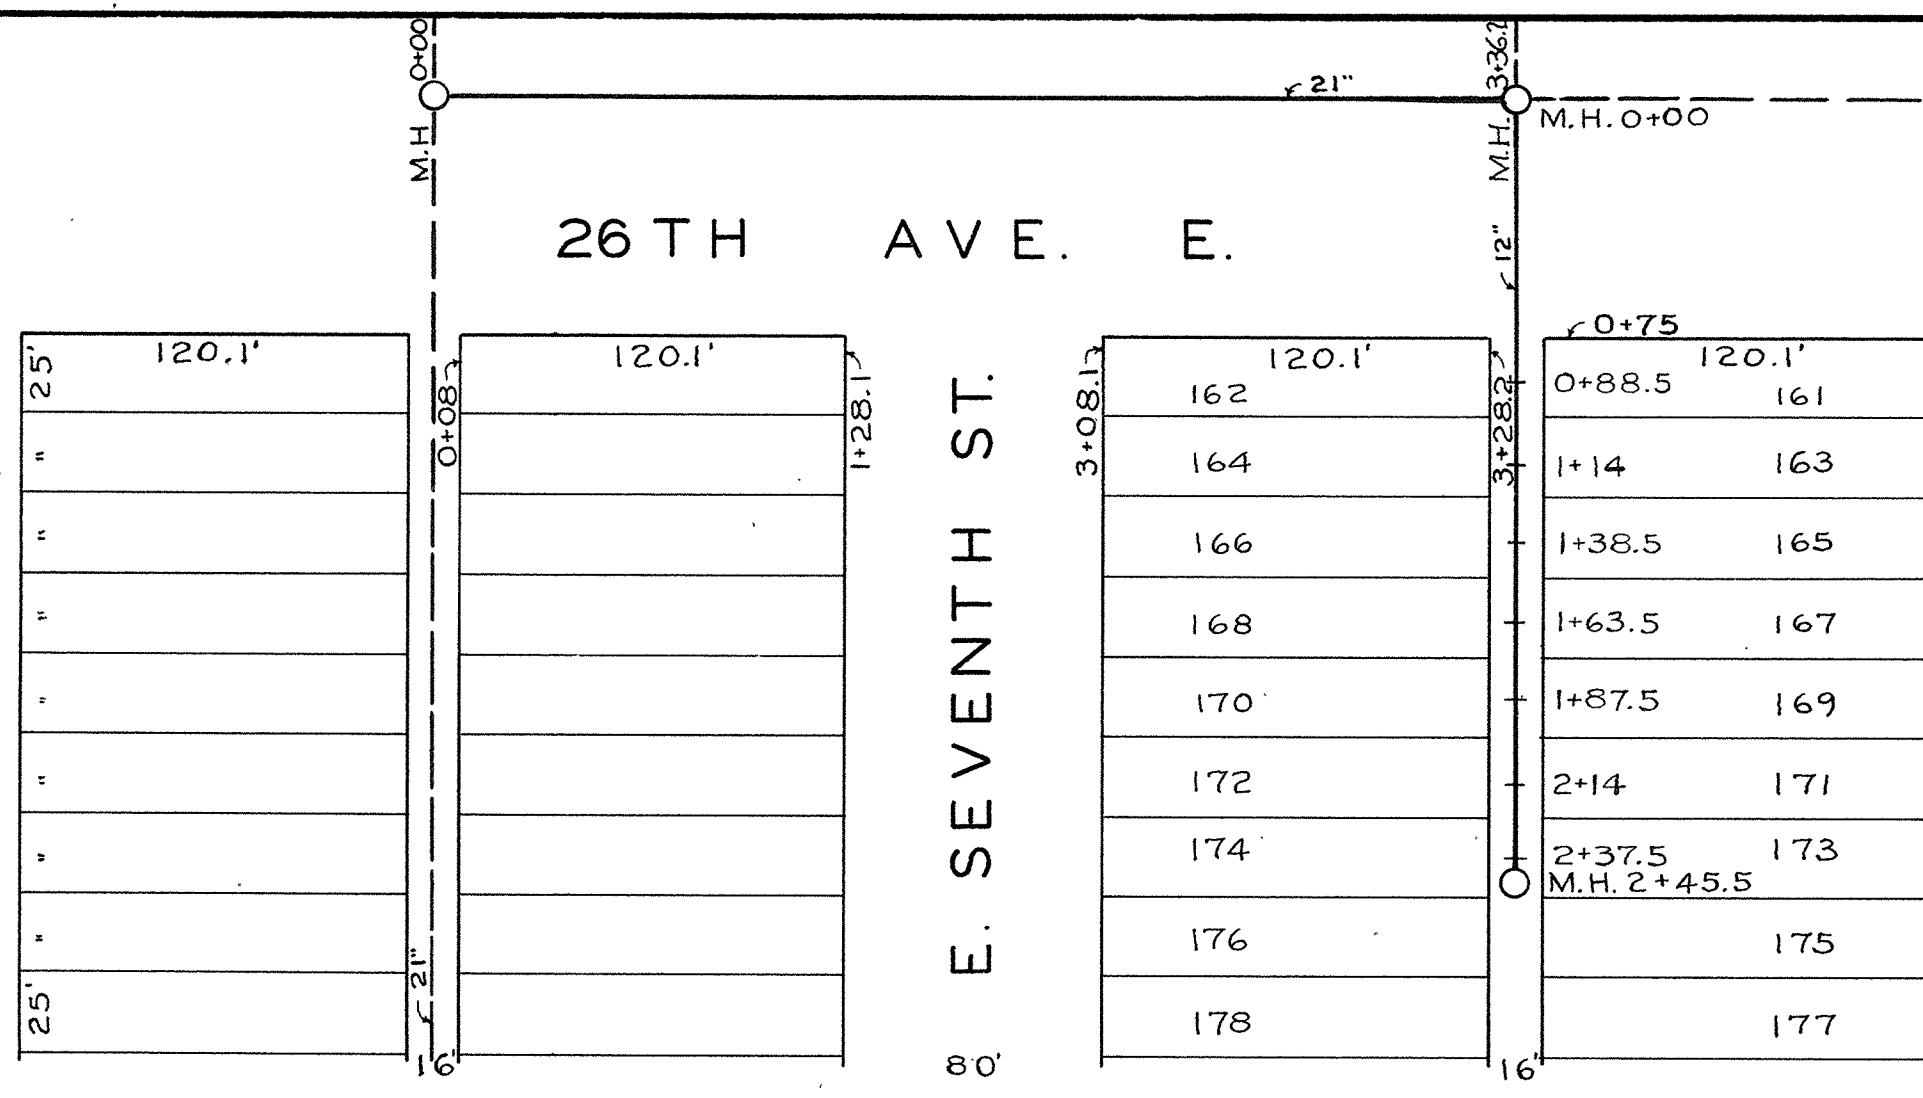

25TH AVE. E.
N. P. RY.

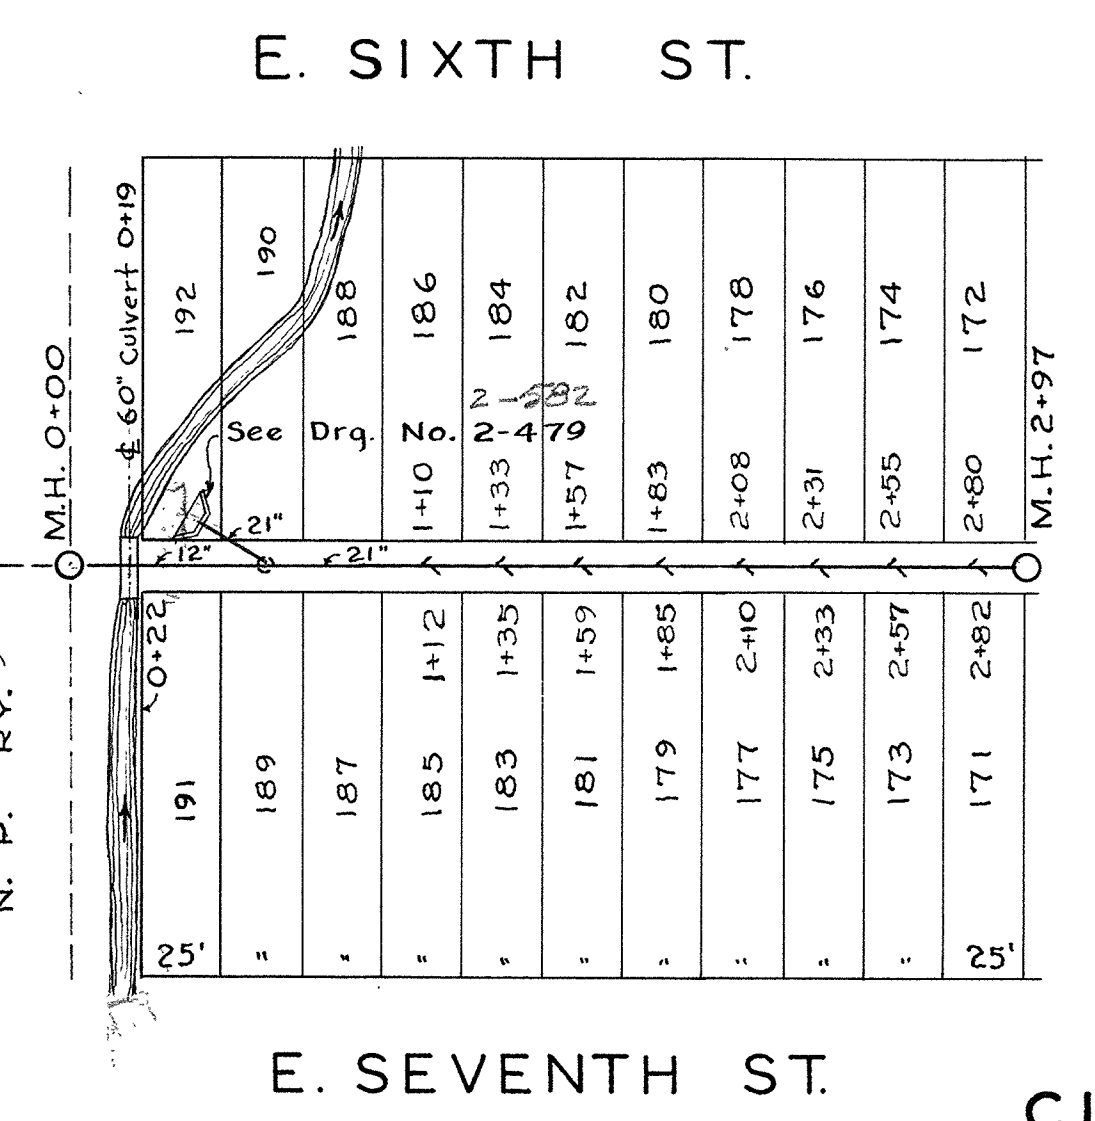

CITY OF SUPERIOR
SEWER PLAN

HORIZONTAL SCALE 1" = 60'
VERTICAL SCALE 1" = 4'
W.P.A. LABOR
H.R. DANN INSPECTOR
JOB STARTED 1937
JOB COMPLETED 1937
T.M. BASTERASH CITY ENGINEER

