

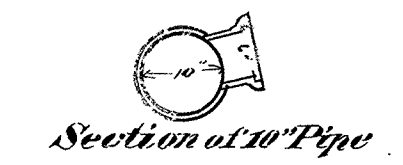
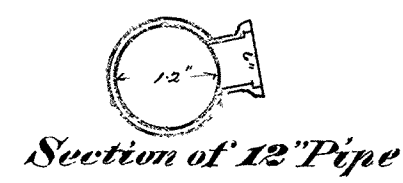


**CITY OF SUPERIOR
SEWER PLAN**

Contract let June 1, 1891
 completed Aug 1891
 Stocton & Lundquist, Contractor
 Jos. P. Duff, Inspector
 E. B. Banks, City Engr.

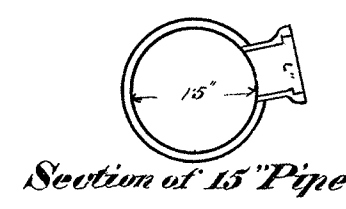

Scale: Horizontal 1" = 60'
 Vertical 1" = 40'
 Section 1" = 2'

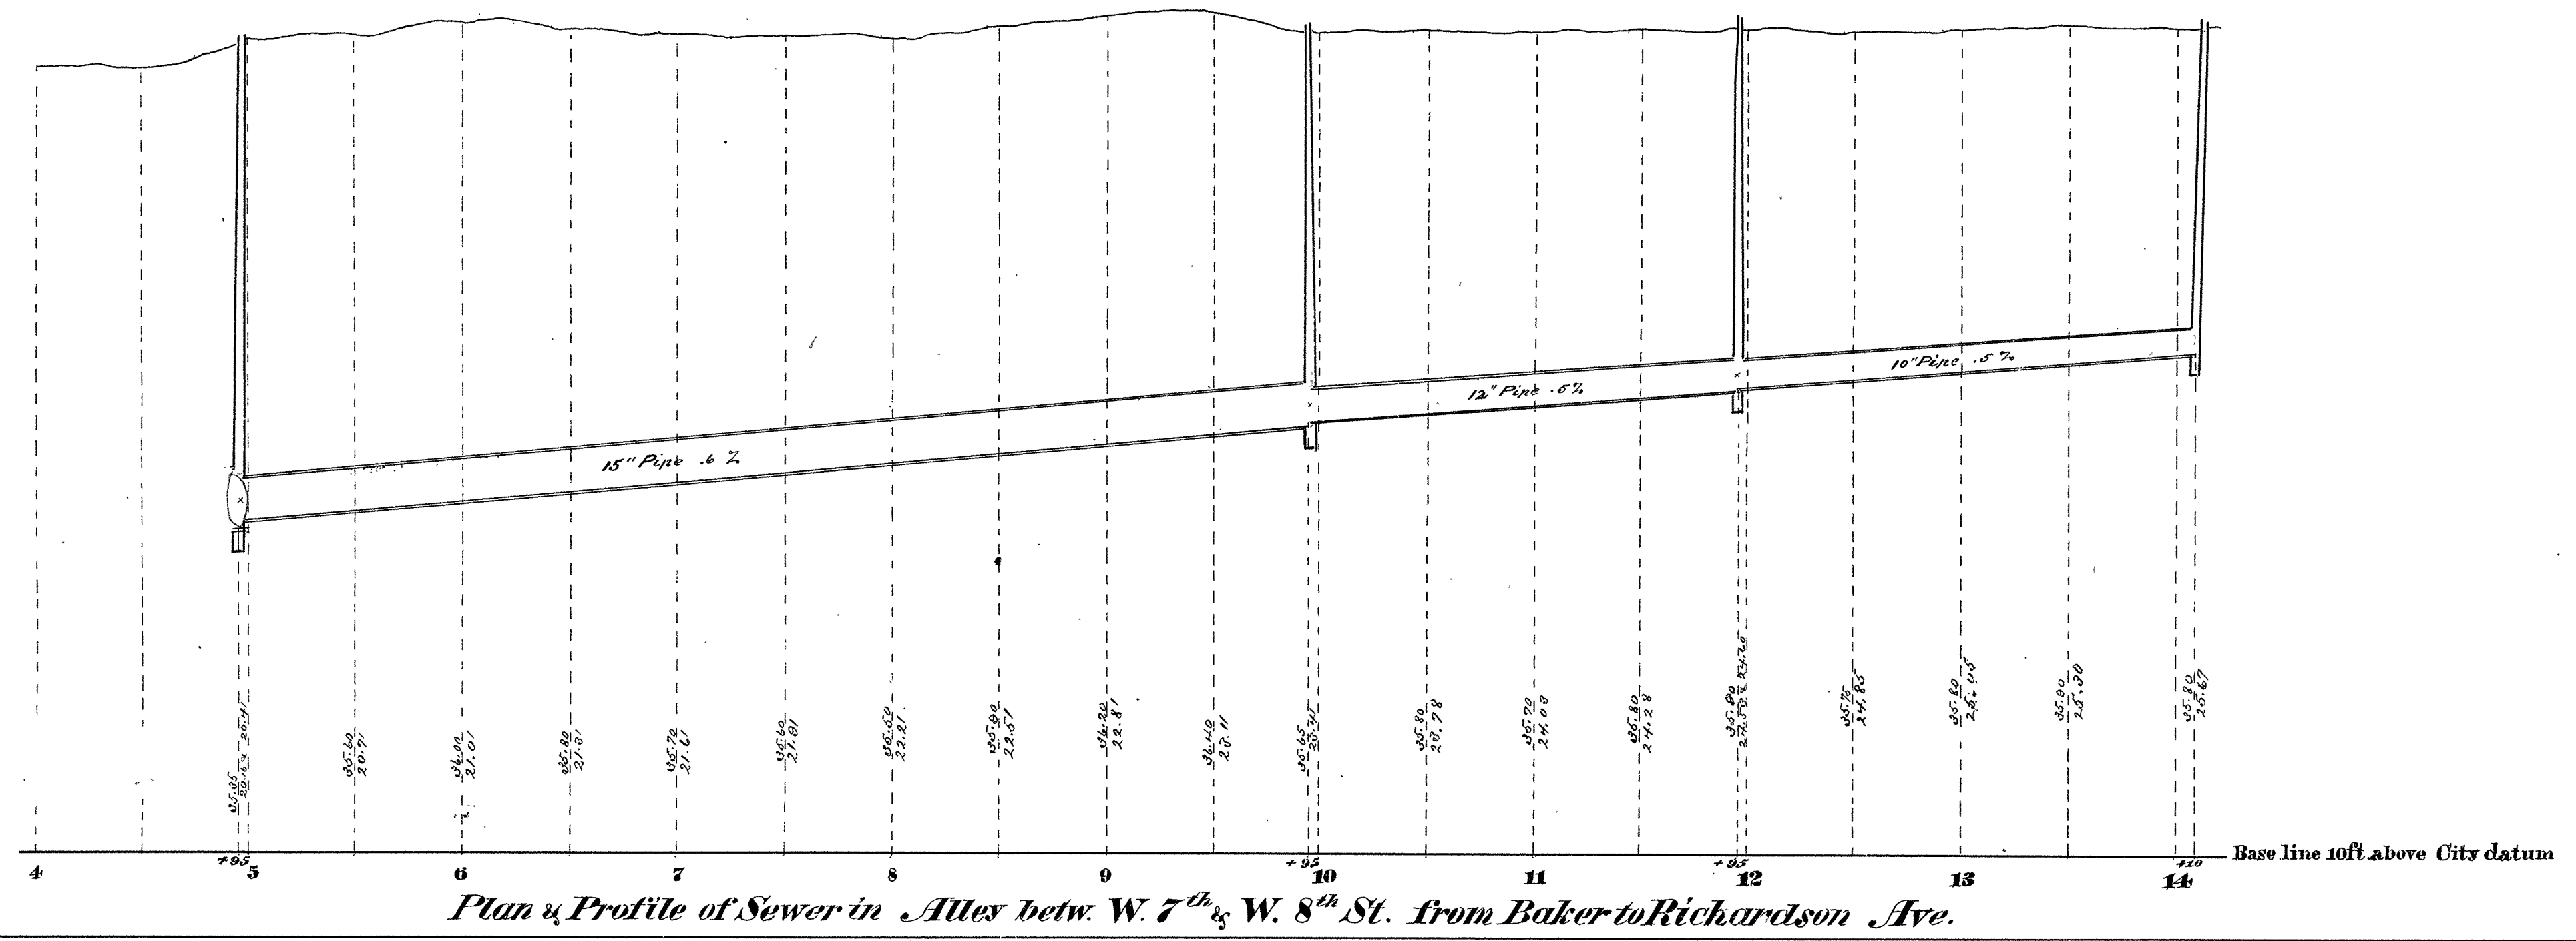

Base line 10ft above City datum