
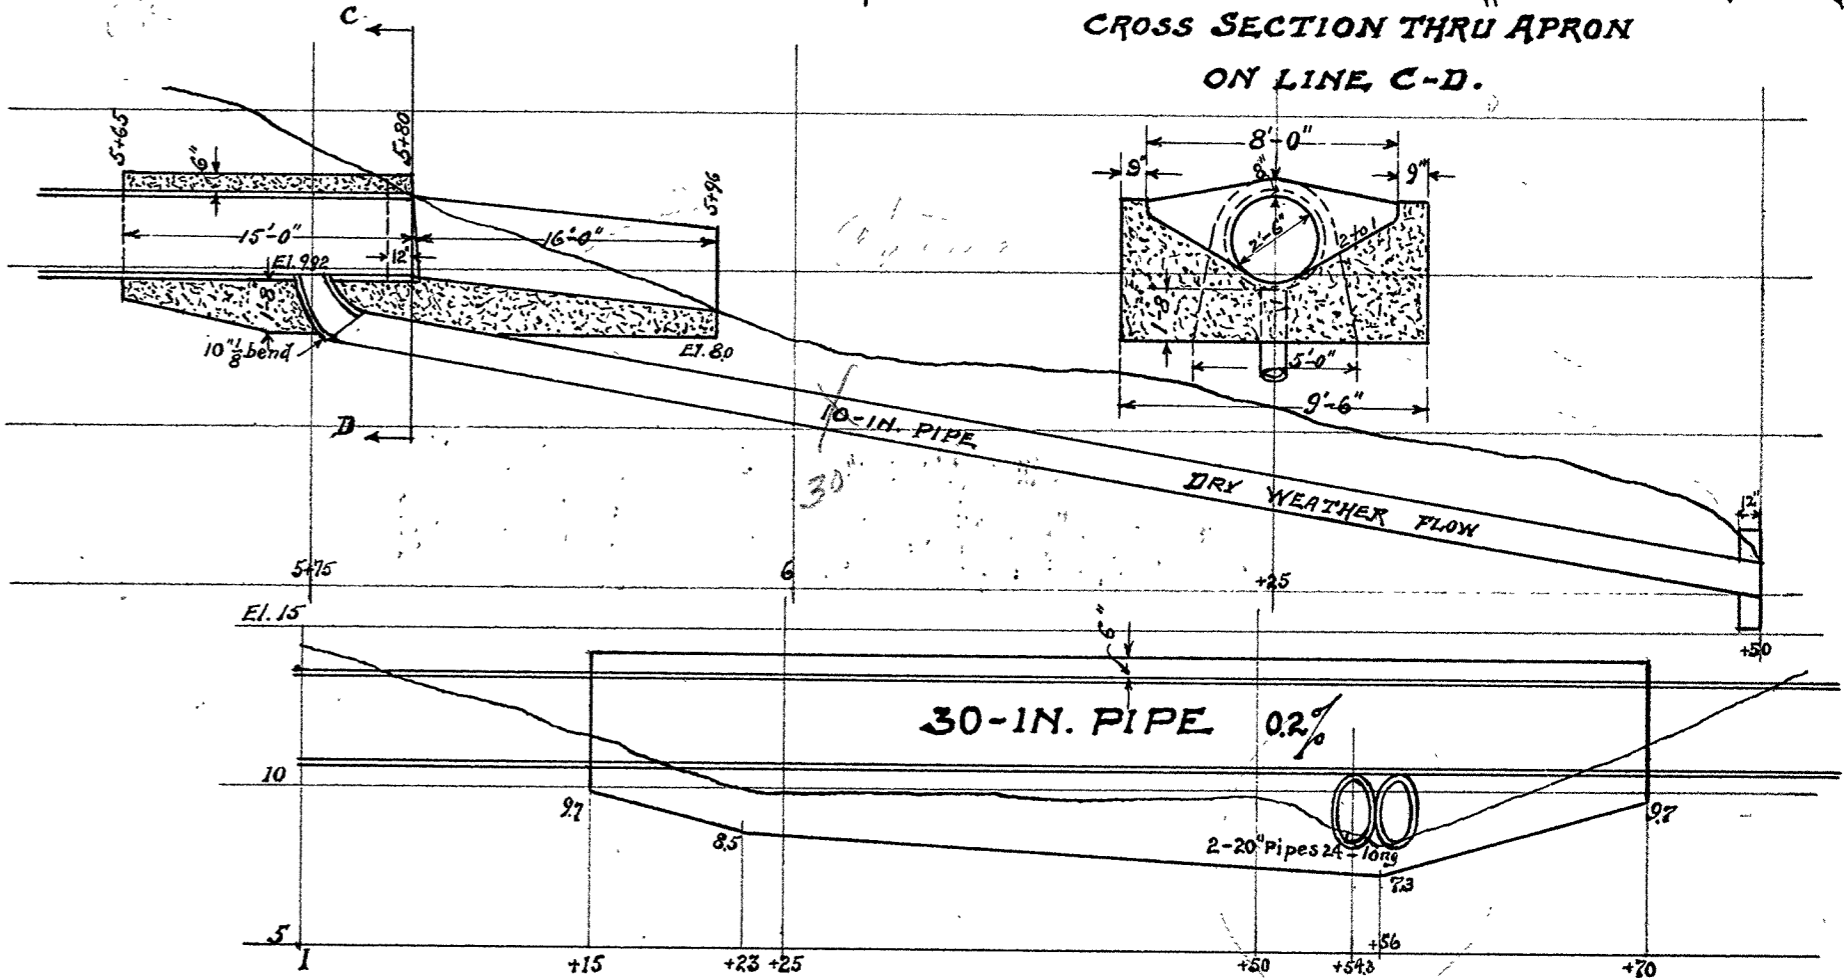
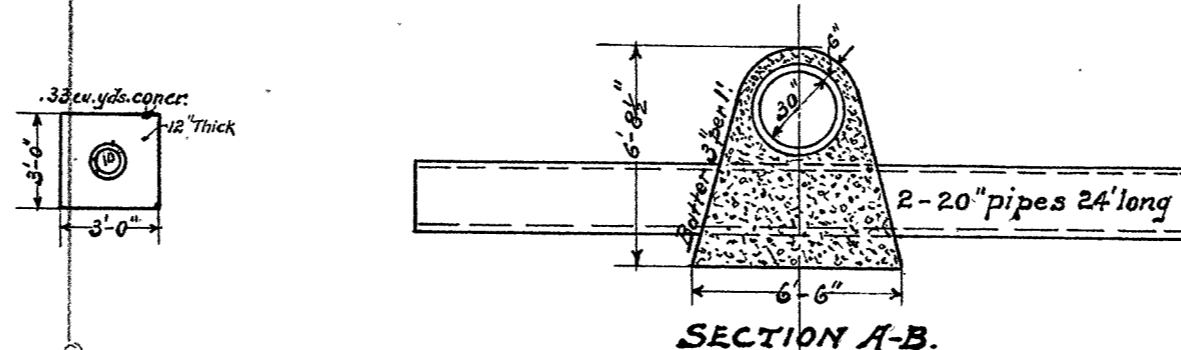


CITY OF SUPERIOR
SEWER PLAN
 Horizontal Scale: 1 in. = 100 ft.
 Vertical Scale: 1 in. = 5 ft.
 CONTRACT No 1457
 Contract let Feb. 9-1915.
 Contract completed April 30-15.
 Magnus Pedersen Contractor
 Graham Inspector
 E. B. Banks City Engineer.

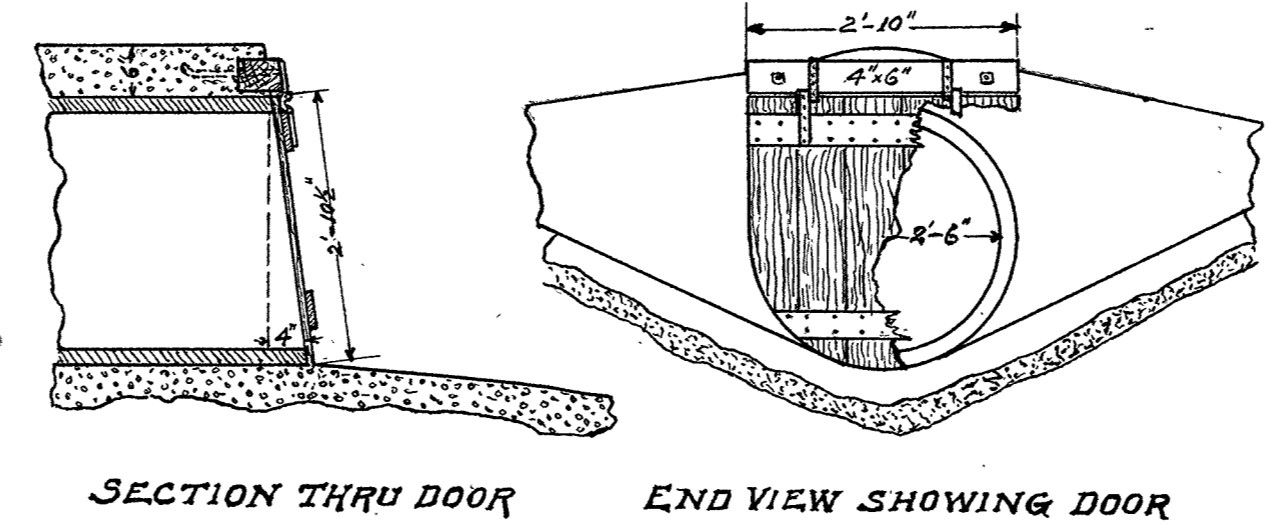

| | | | | | | | | | | | | | | | |
|----|----|----|----|----|----|----|----|----|----|----|---|---|---|---|---|
| 31 | 29 | 27 | 25 | 23 | 21 | 19 | 17 | 15 | 13 | 11 | 9 | 7 | 5 | 3 | 1 |
| 25 | 1 | 1 | 1 | 1 | 1 | 1 | 1 | 1 | 1 | 1 | 1 | 1 | 1 | 1 | 1 |

Note: See outfall sewer plans for
 Revised Outfall Map C.M.P.
 Resubmitted 5-15-13
 (1-1-1)