

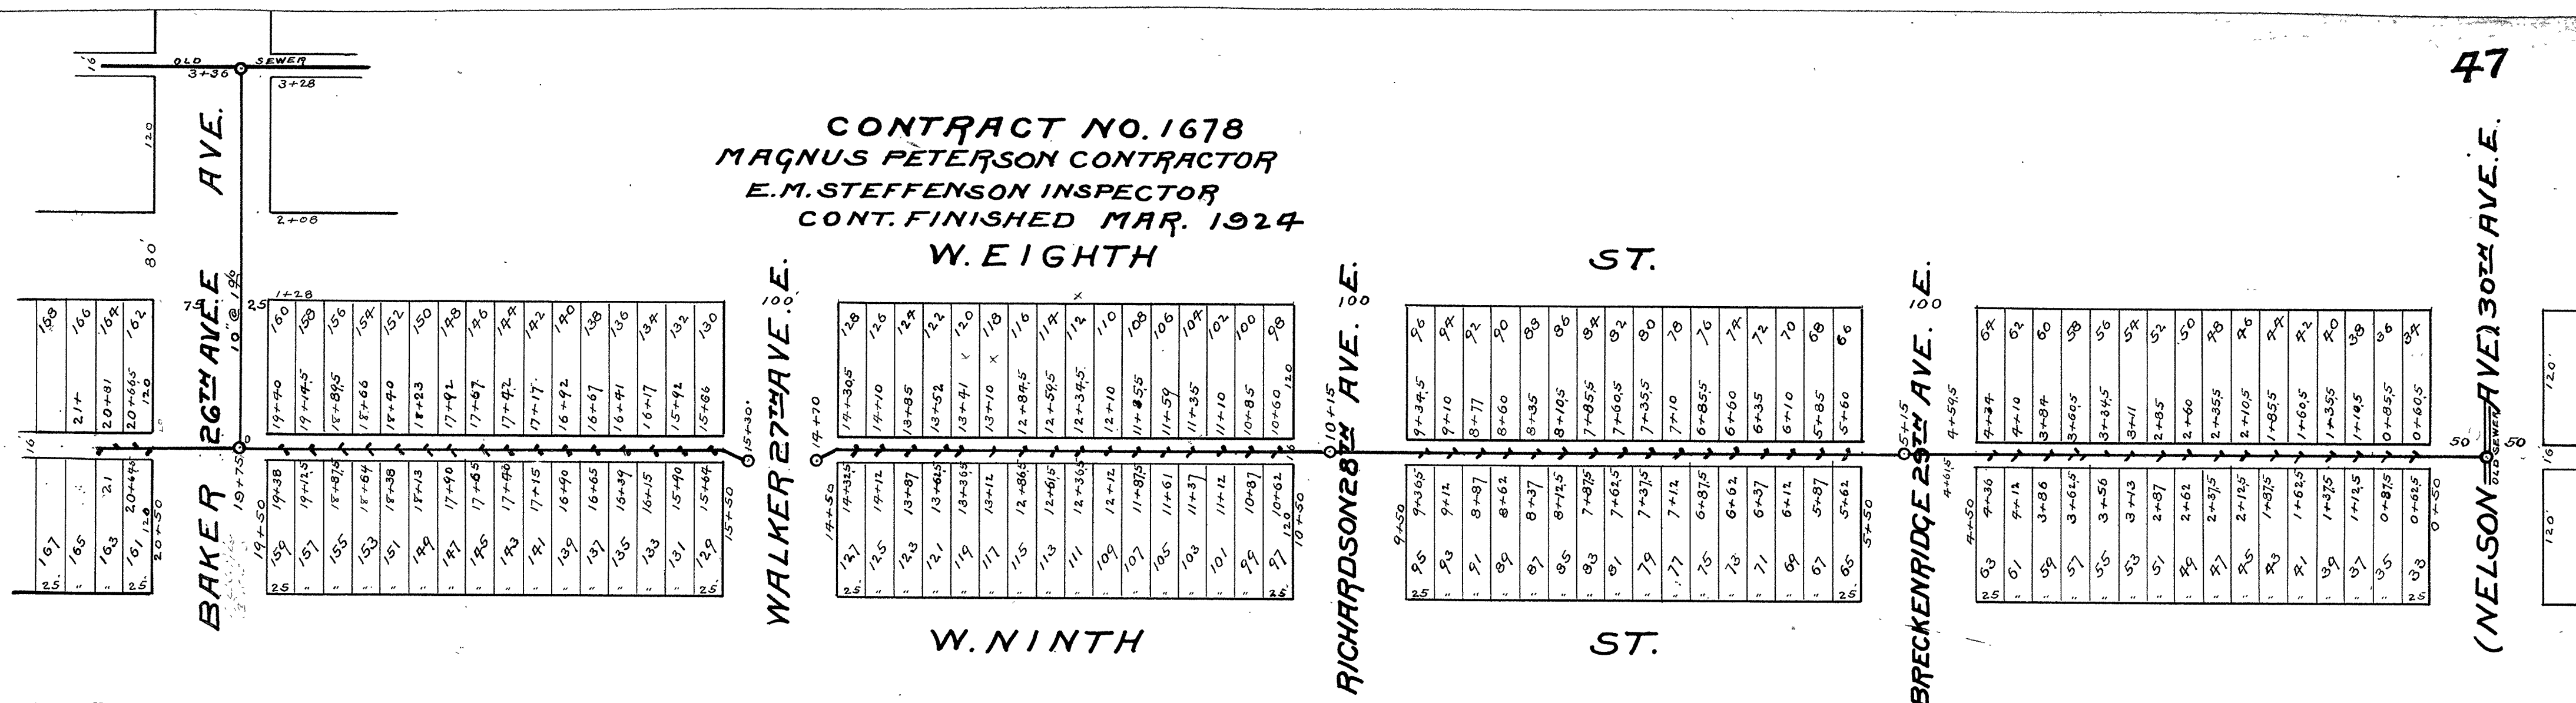
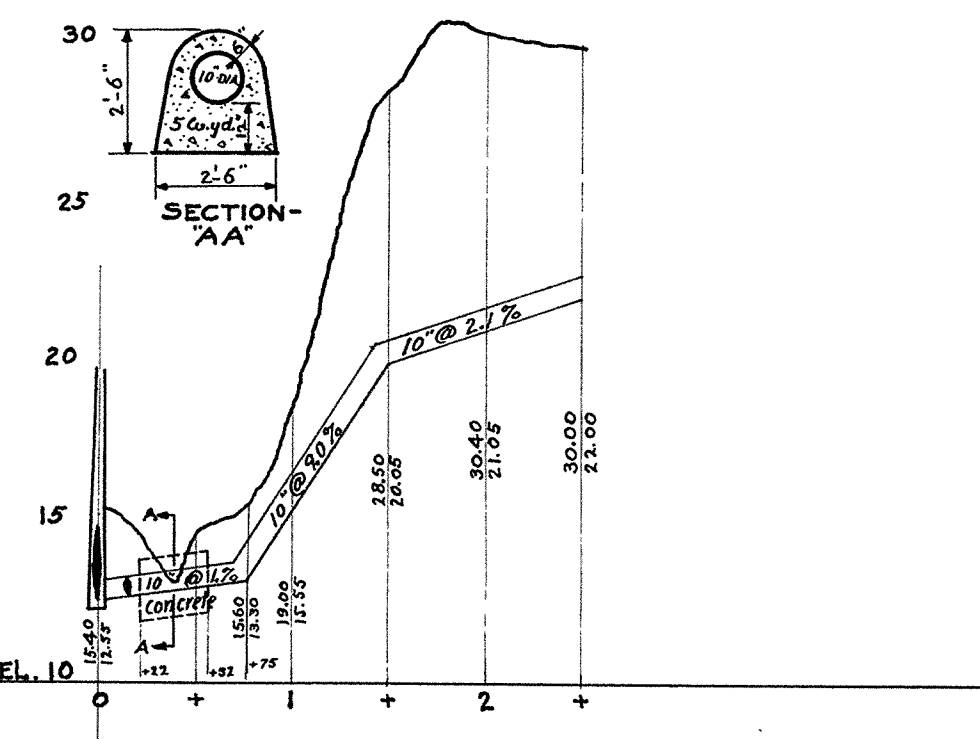
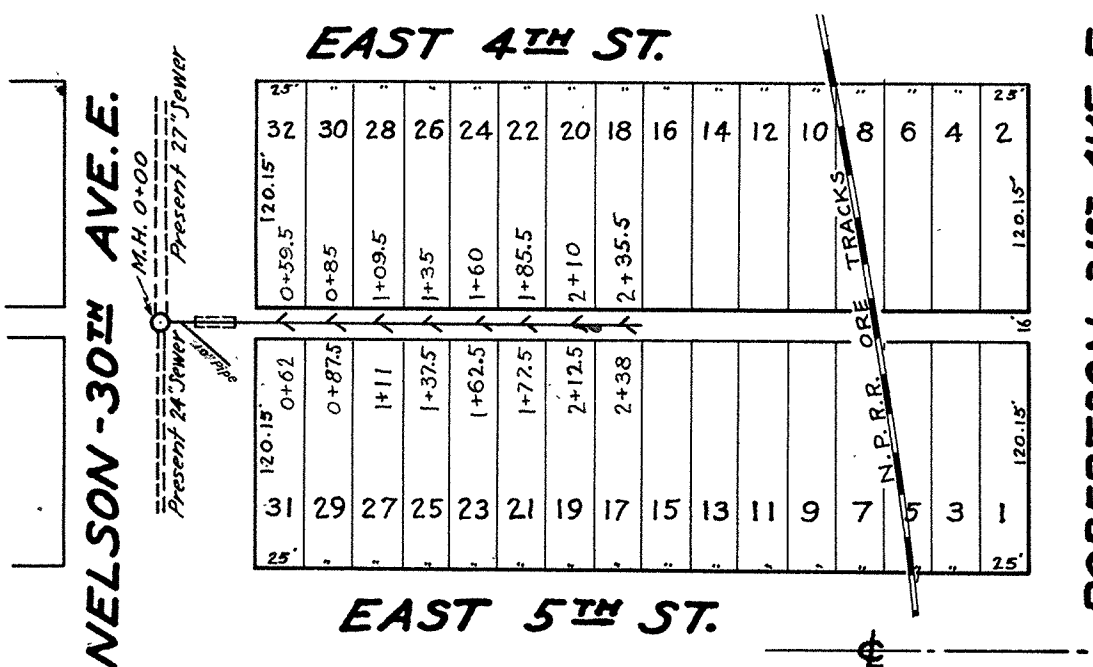




CONTRACT NO. 1678  
MAGNUS PETERSON CONTRACTOR  
E.M. STEFFENSON INSPECTOR  
CONT. FINISHED MAR. 1924  
W. EIGHTH ST.

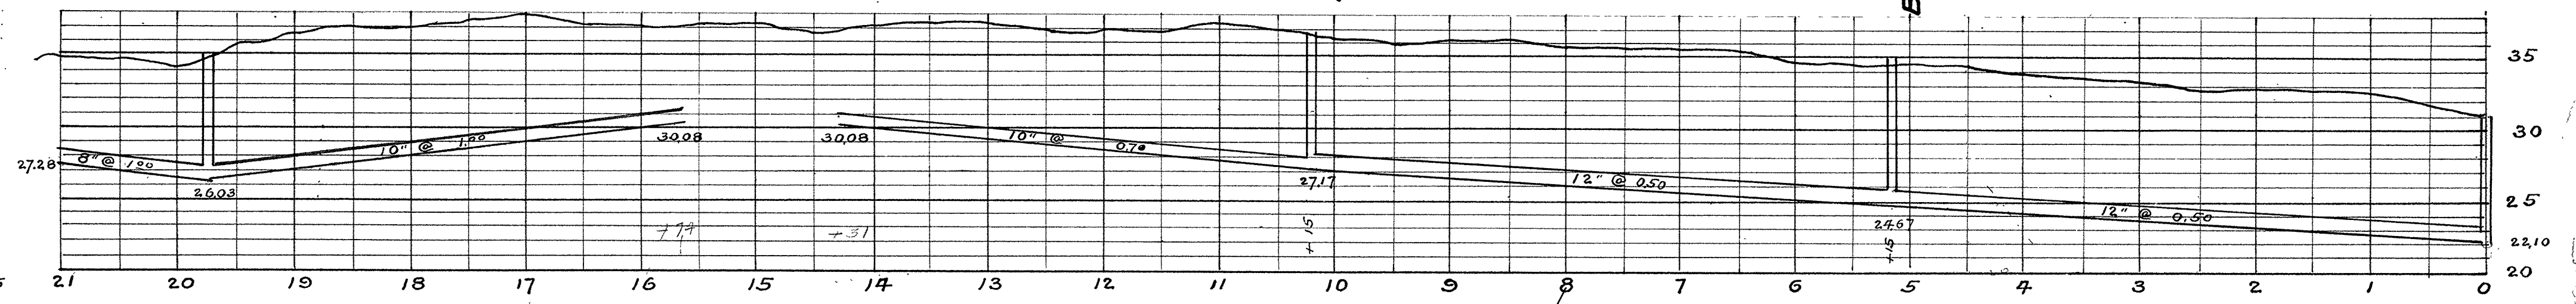

26TH AVE. EAST IN (BAKER AVE.)

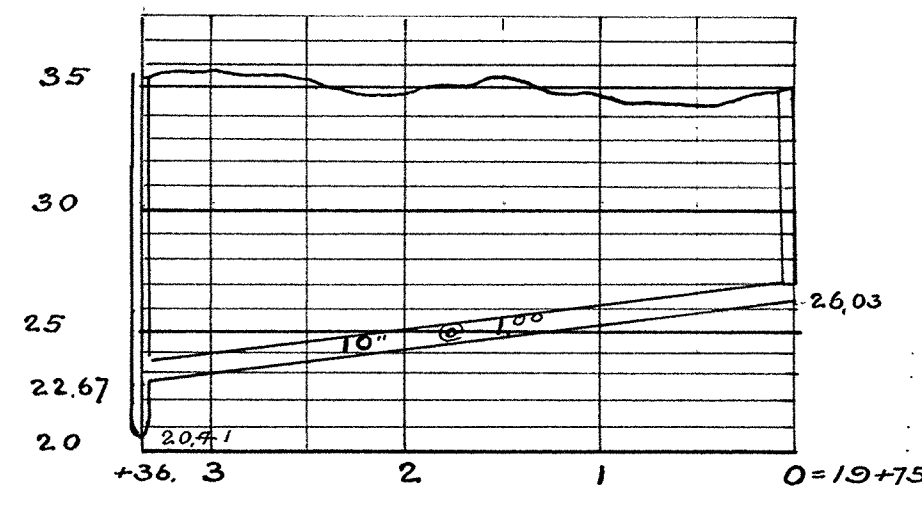

Contract No. 1776  
Contract Let July 3, 1929  
Contract Completed Sept. 4, 1929  
Superior Plumbing & Heating Co. Conts.  
W.A. Donalds Inspector.  
E.B. Banks City Engineer.

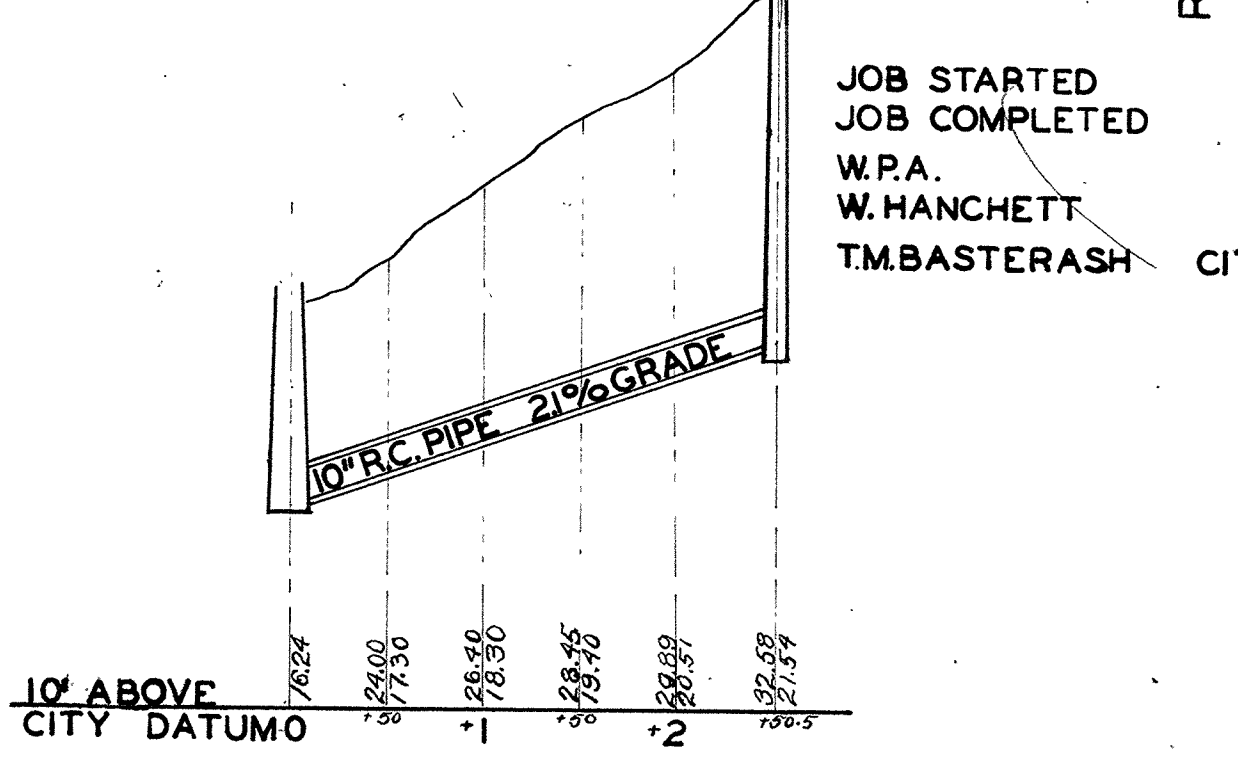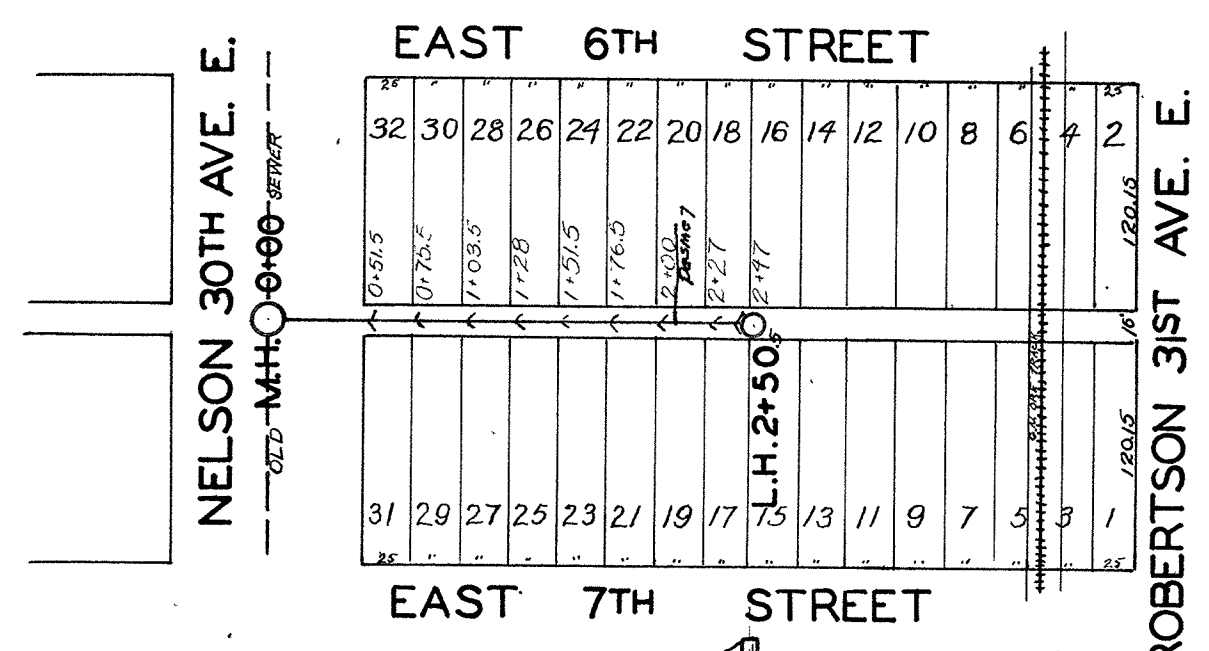

JOB STARTED FEB. 1938  
JOB COMPLETED MAR. 1938  
W.P.A. LABOR  
W. HANCHETT INSPECTOR  
T.M. BASTERASH CITY ENGINEER

