



19<sup>TH</sup> AVE. E.  
S<sup>E</sup> JOHN

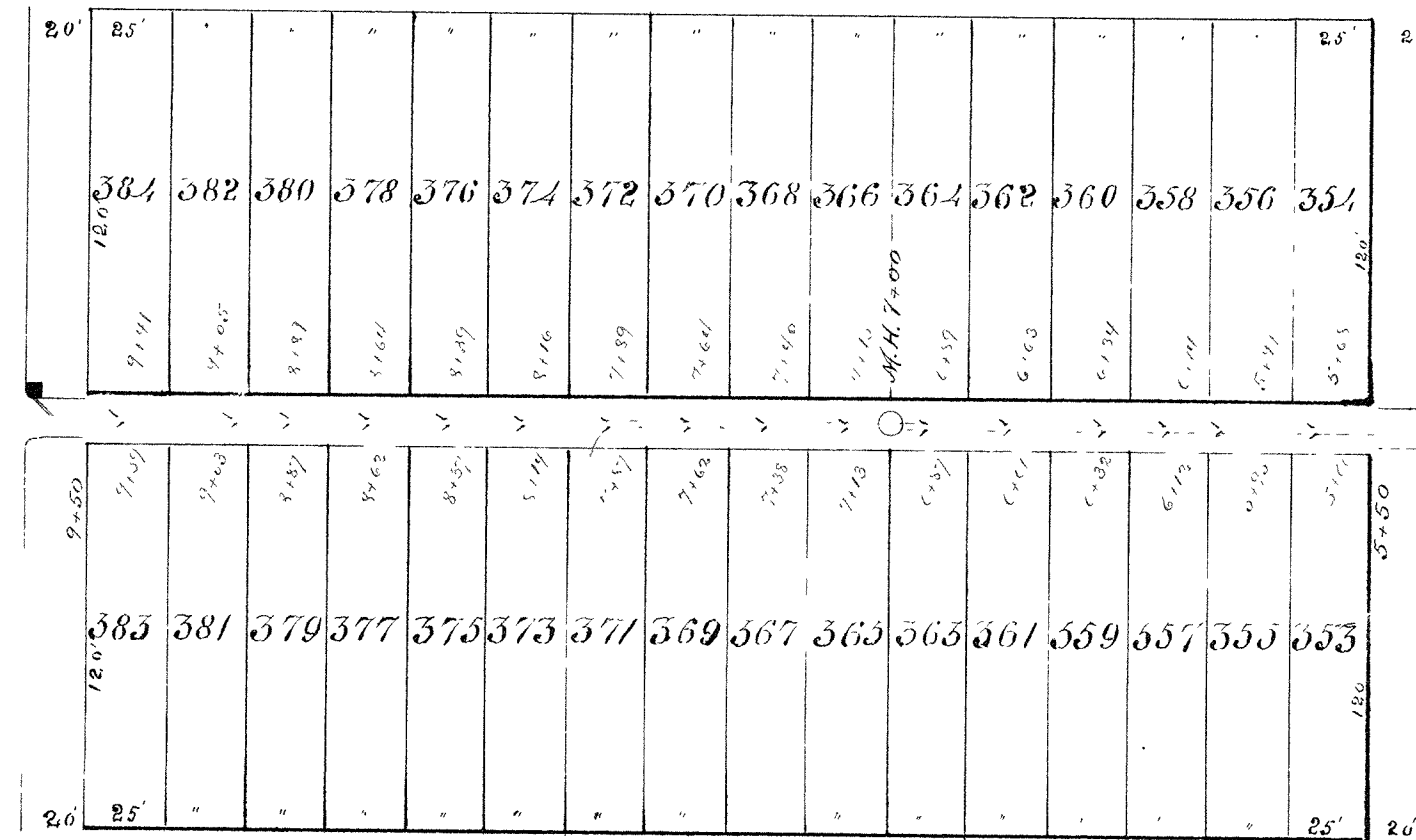



20<sup>TH</sup> AVE. E.  
HOLLINSHEAD

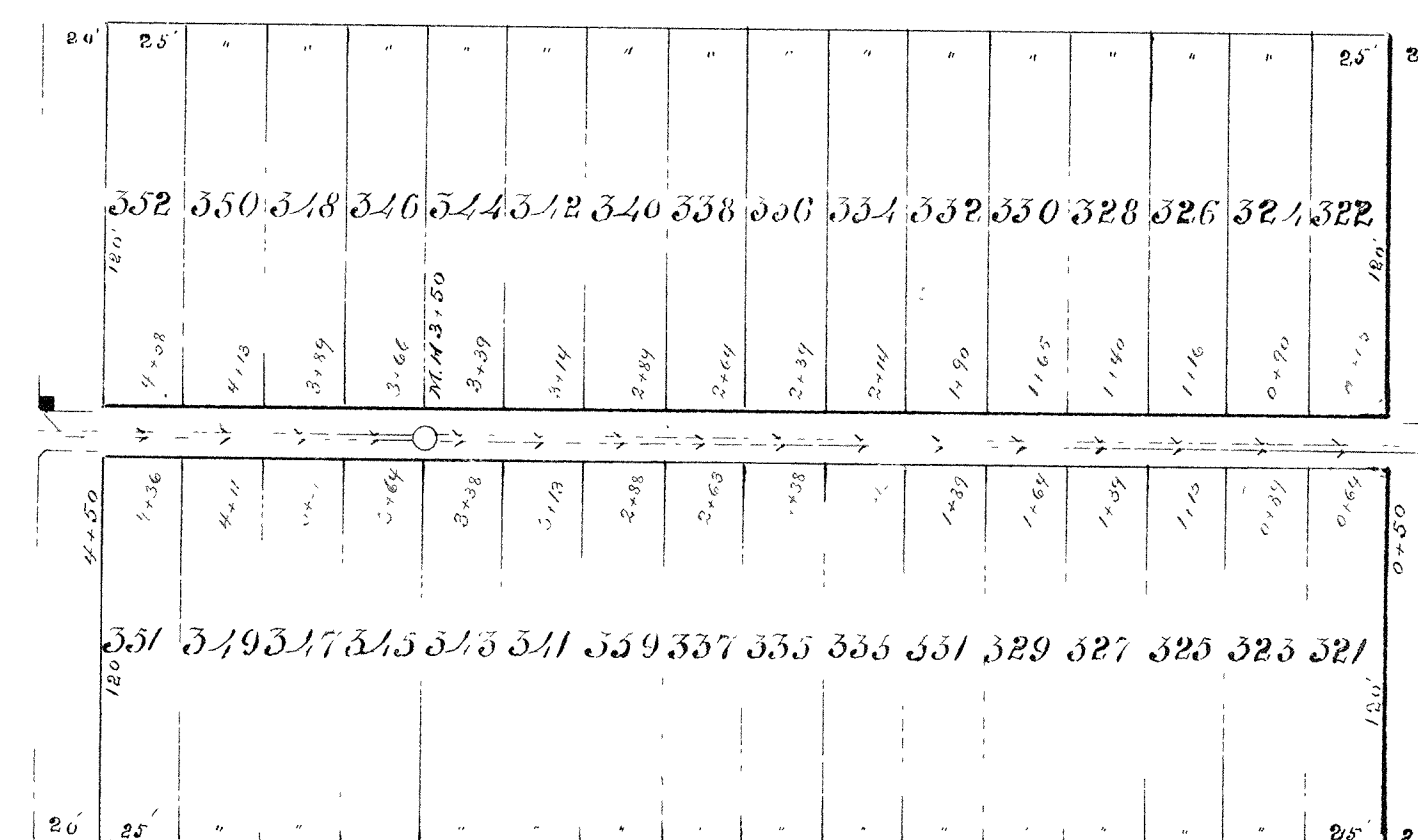

21<sup>ST</sup> AVE. E.  
NETTLETON

**CITY OF SUPERIOR  
SEWER PLAN**

Built by City betw. Nov. 1 & Dec. 6, 1890  
Forrestal Bros., Contractor Failed  
F. Richardson, M. Conroy & G. W. Smith, Insps.  
E. B. Banks, City Engineer

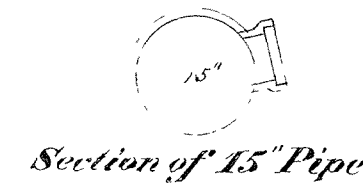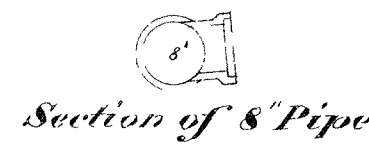

(Horizontal Scale) 1" = 60'  
(Vertical Section) 1" = 4'  
1/2" = 1'

