


Scale: { Horizontal 1" = 00'
Vertical 1" = 4'
Section 1" = 2'

CITY OF SUPERIOR
SEWER PLAN
Contract let April 3, 1891
completed Aug 1, 1891
F. A. Dole, Contractor
Wm. G. Coleman, Inspector
E. B. Banks, City Engineer

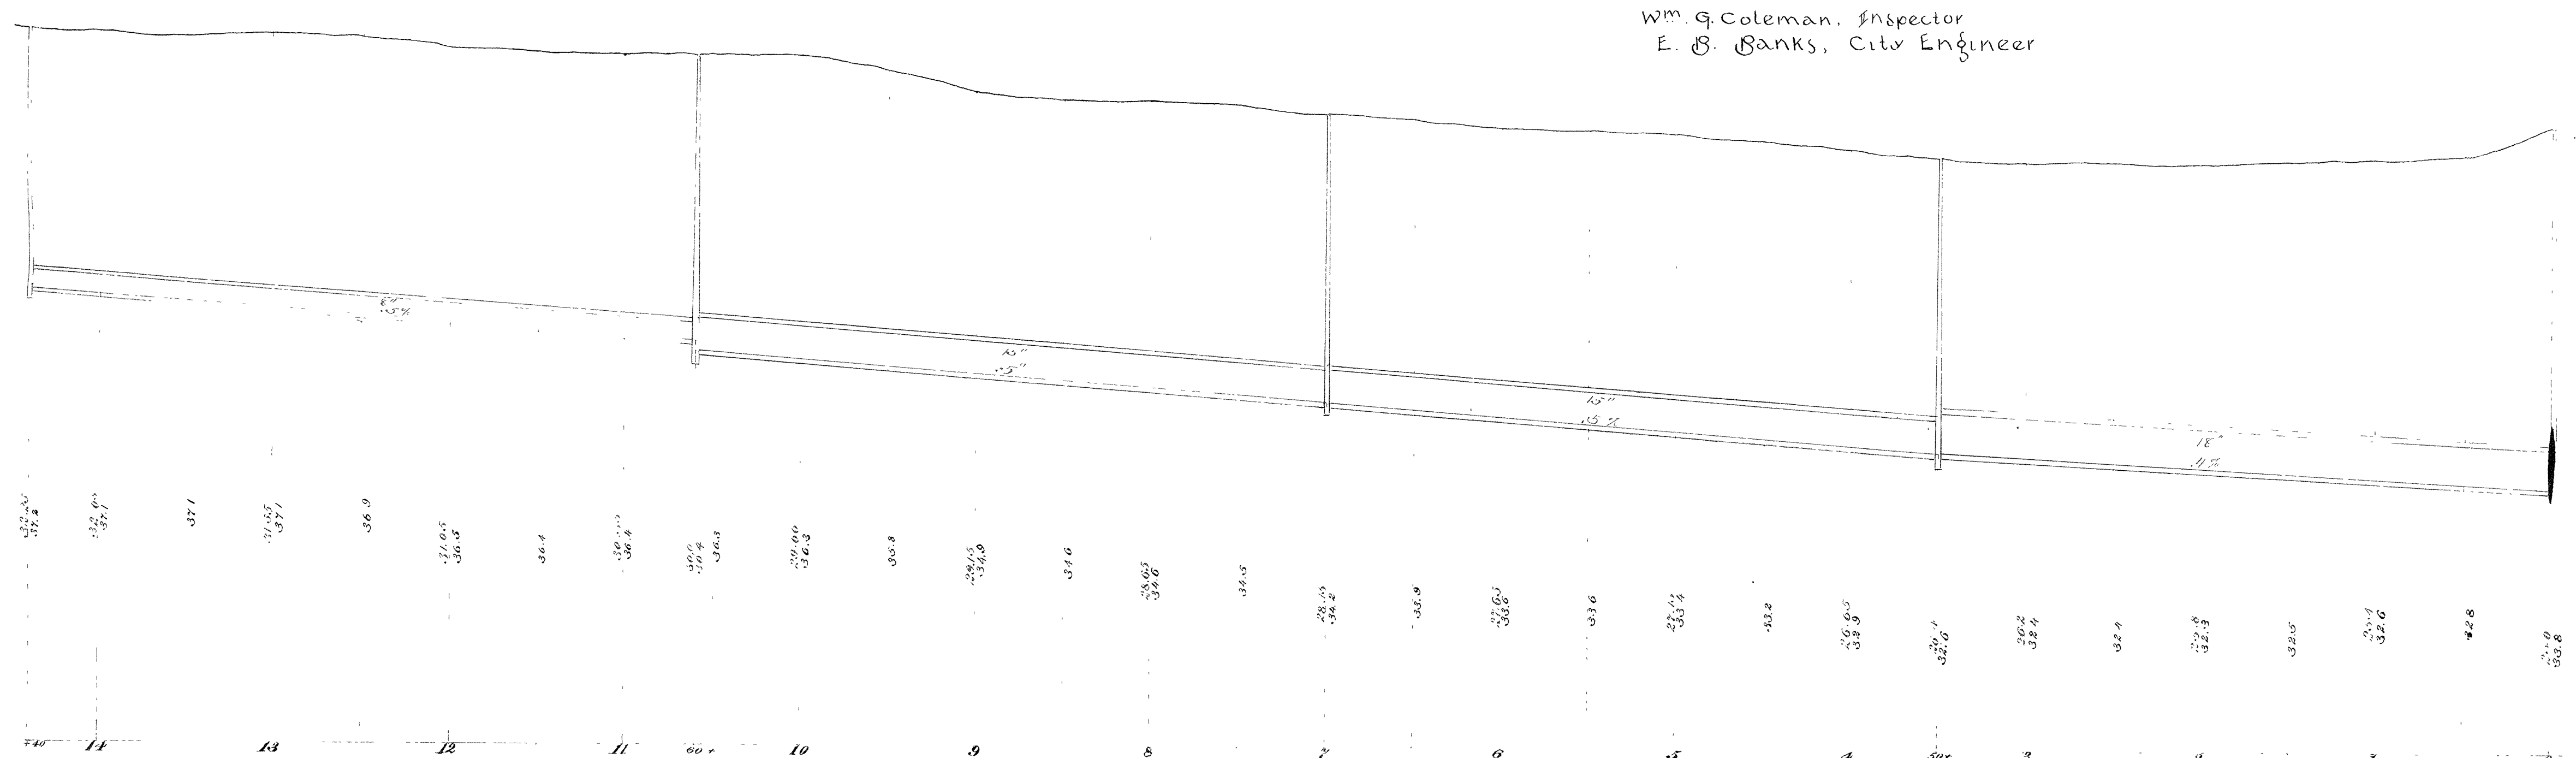

Base Line 15ft. below Datum

Profile of Sewer in Alley between W. 7th and W. 8th St. from Carlton to Nettleton Ave.