


PLAN  
 REVISIONS  
 CHECKED  
 DATE  
 BY  
 DATE

PROFILE  
 REVISIONS  
 CHECKED  
 DATE  
 BY  
 DATE

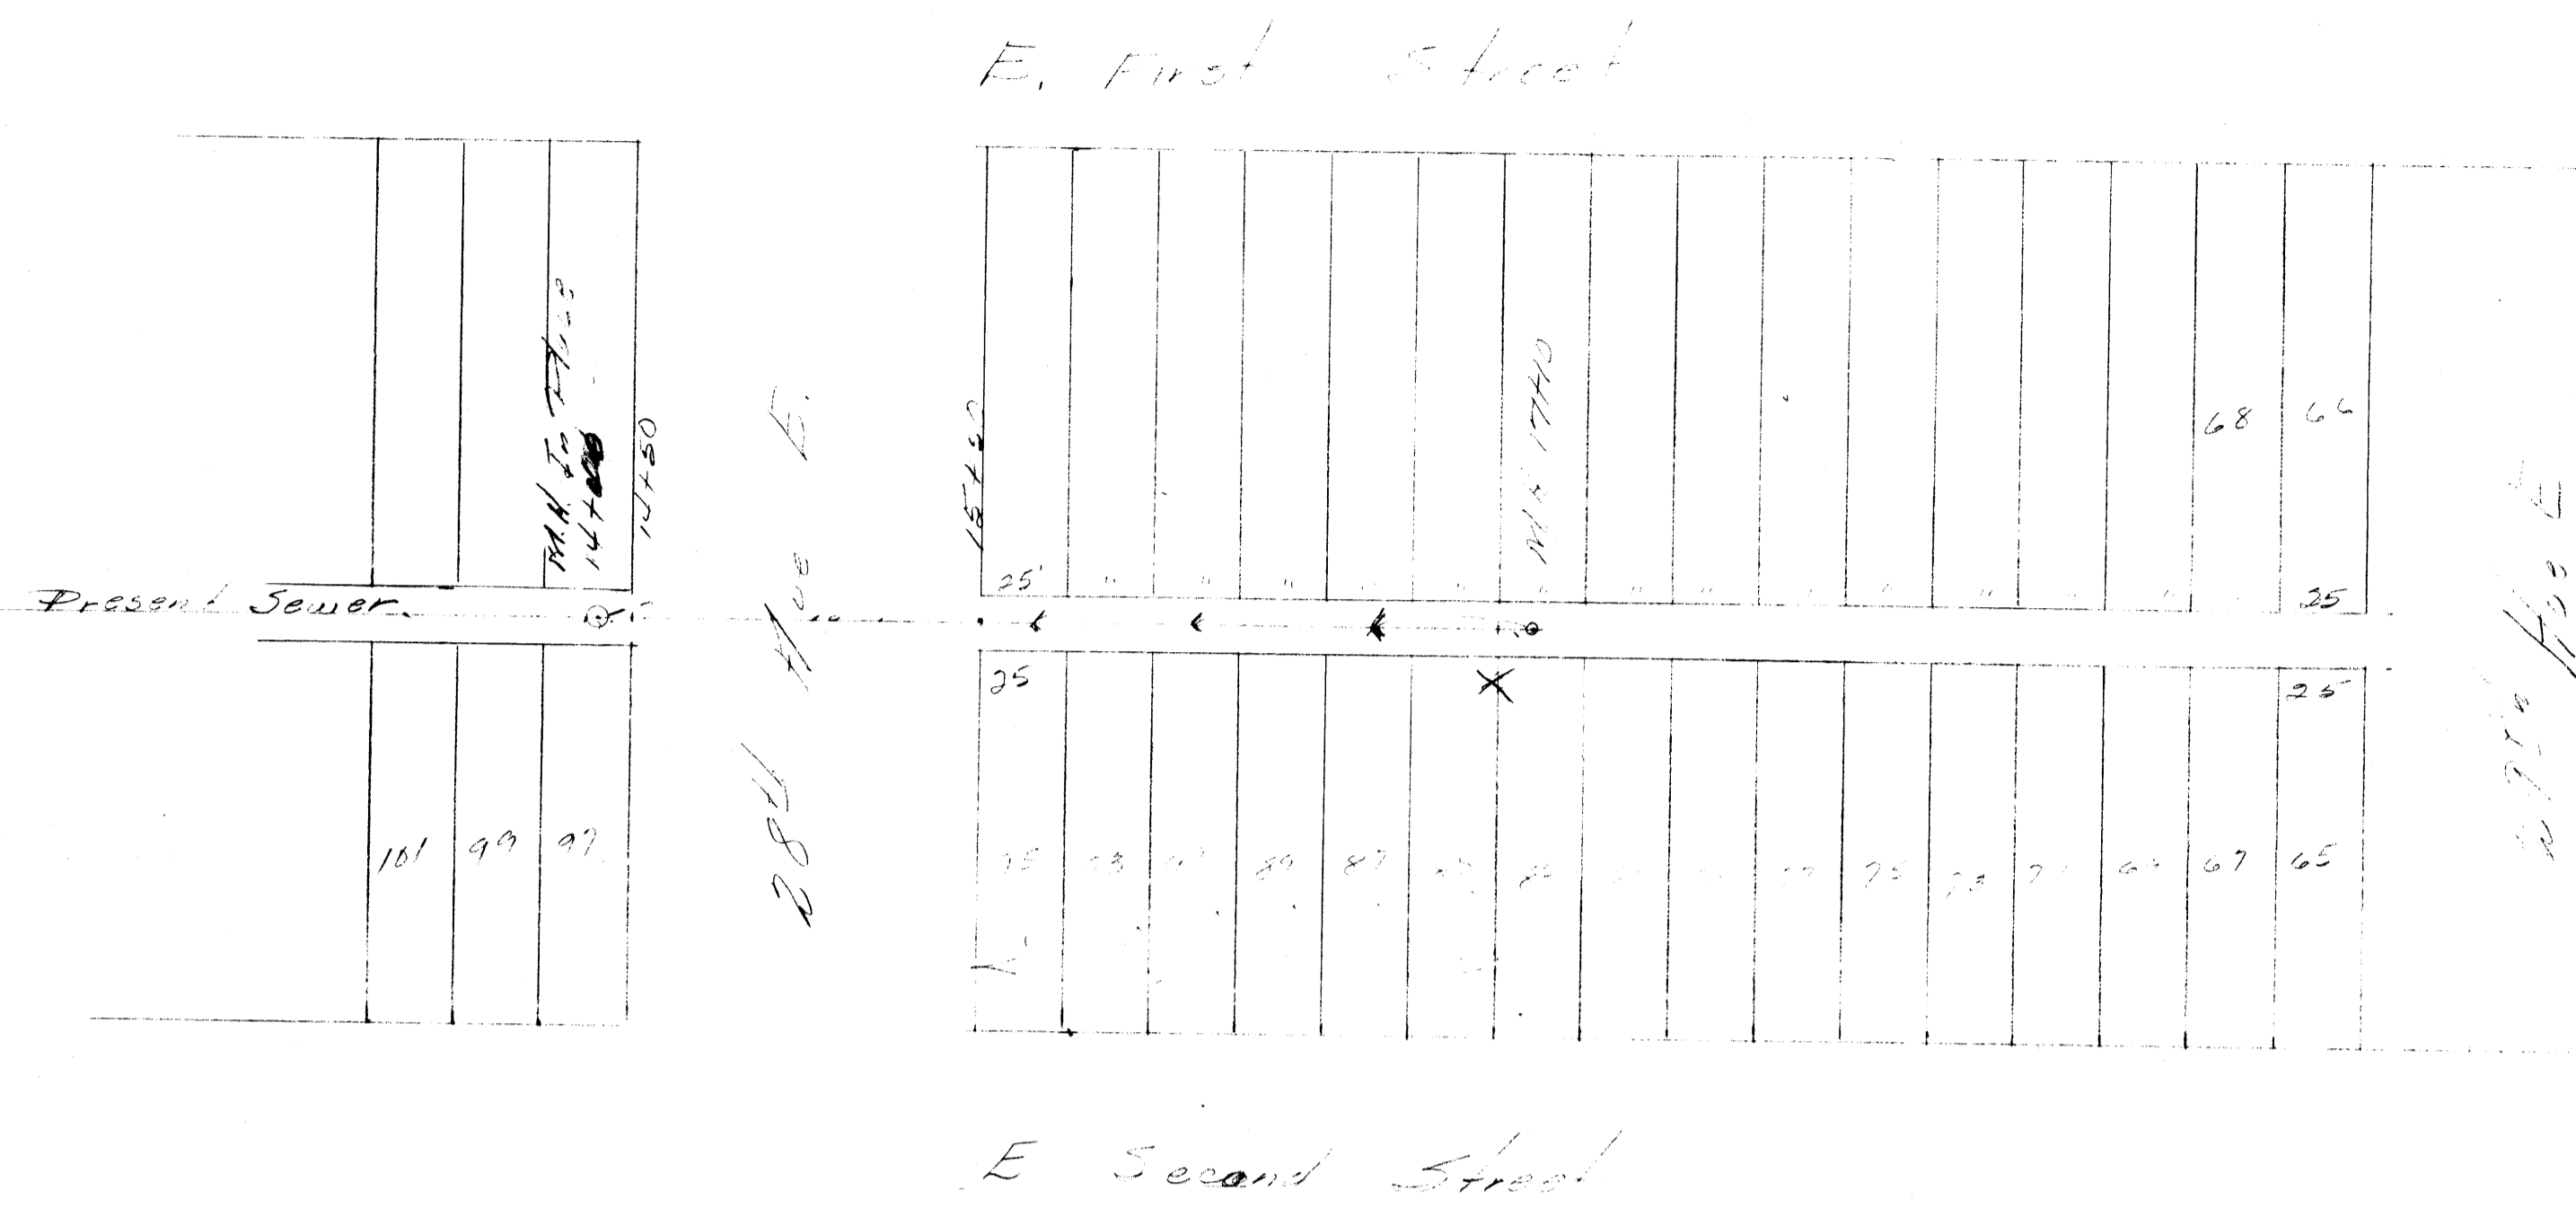

Between E. 1st + E. 2nd St. + between 28th + 29th Ave E  
 A-6