


# SUPERIOR, WISCONSIN

## DISTRICT 4-EAST END STORM SEWER SEPARATION 1974

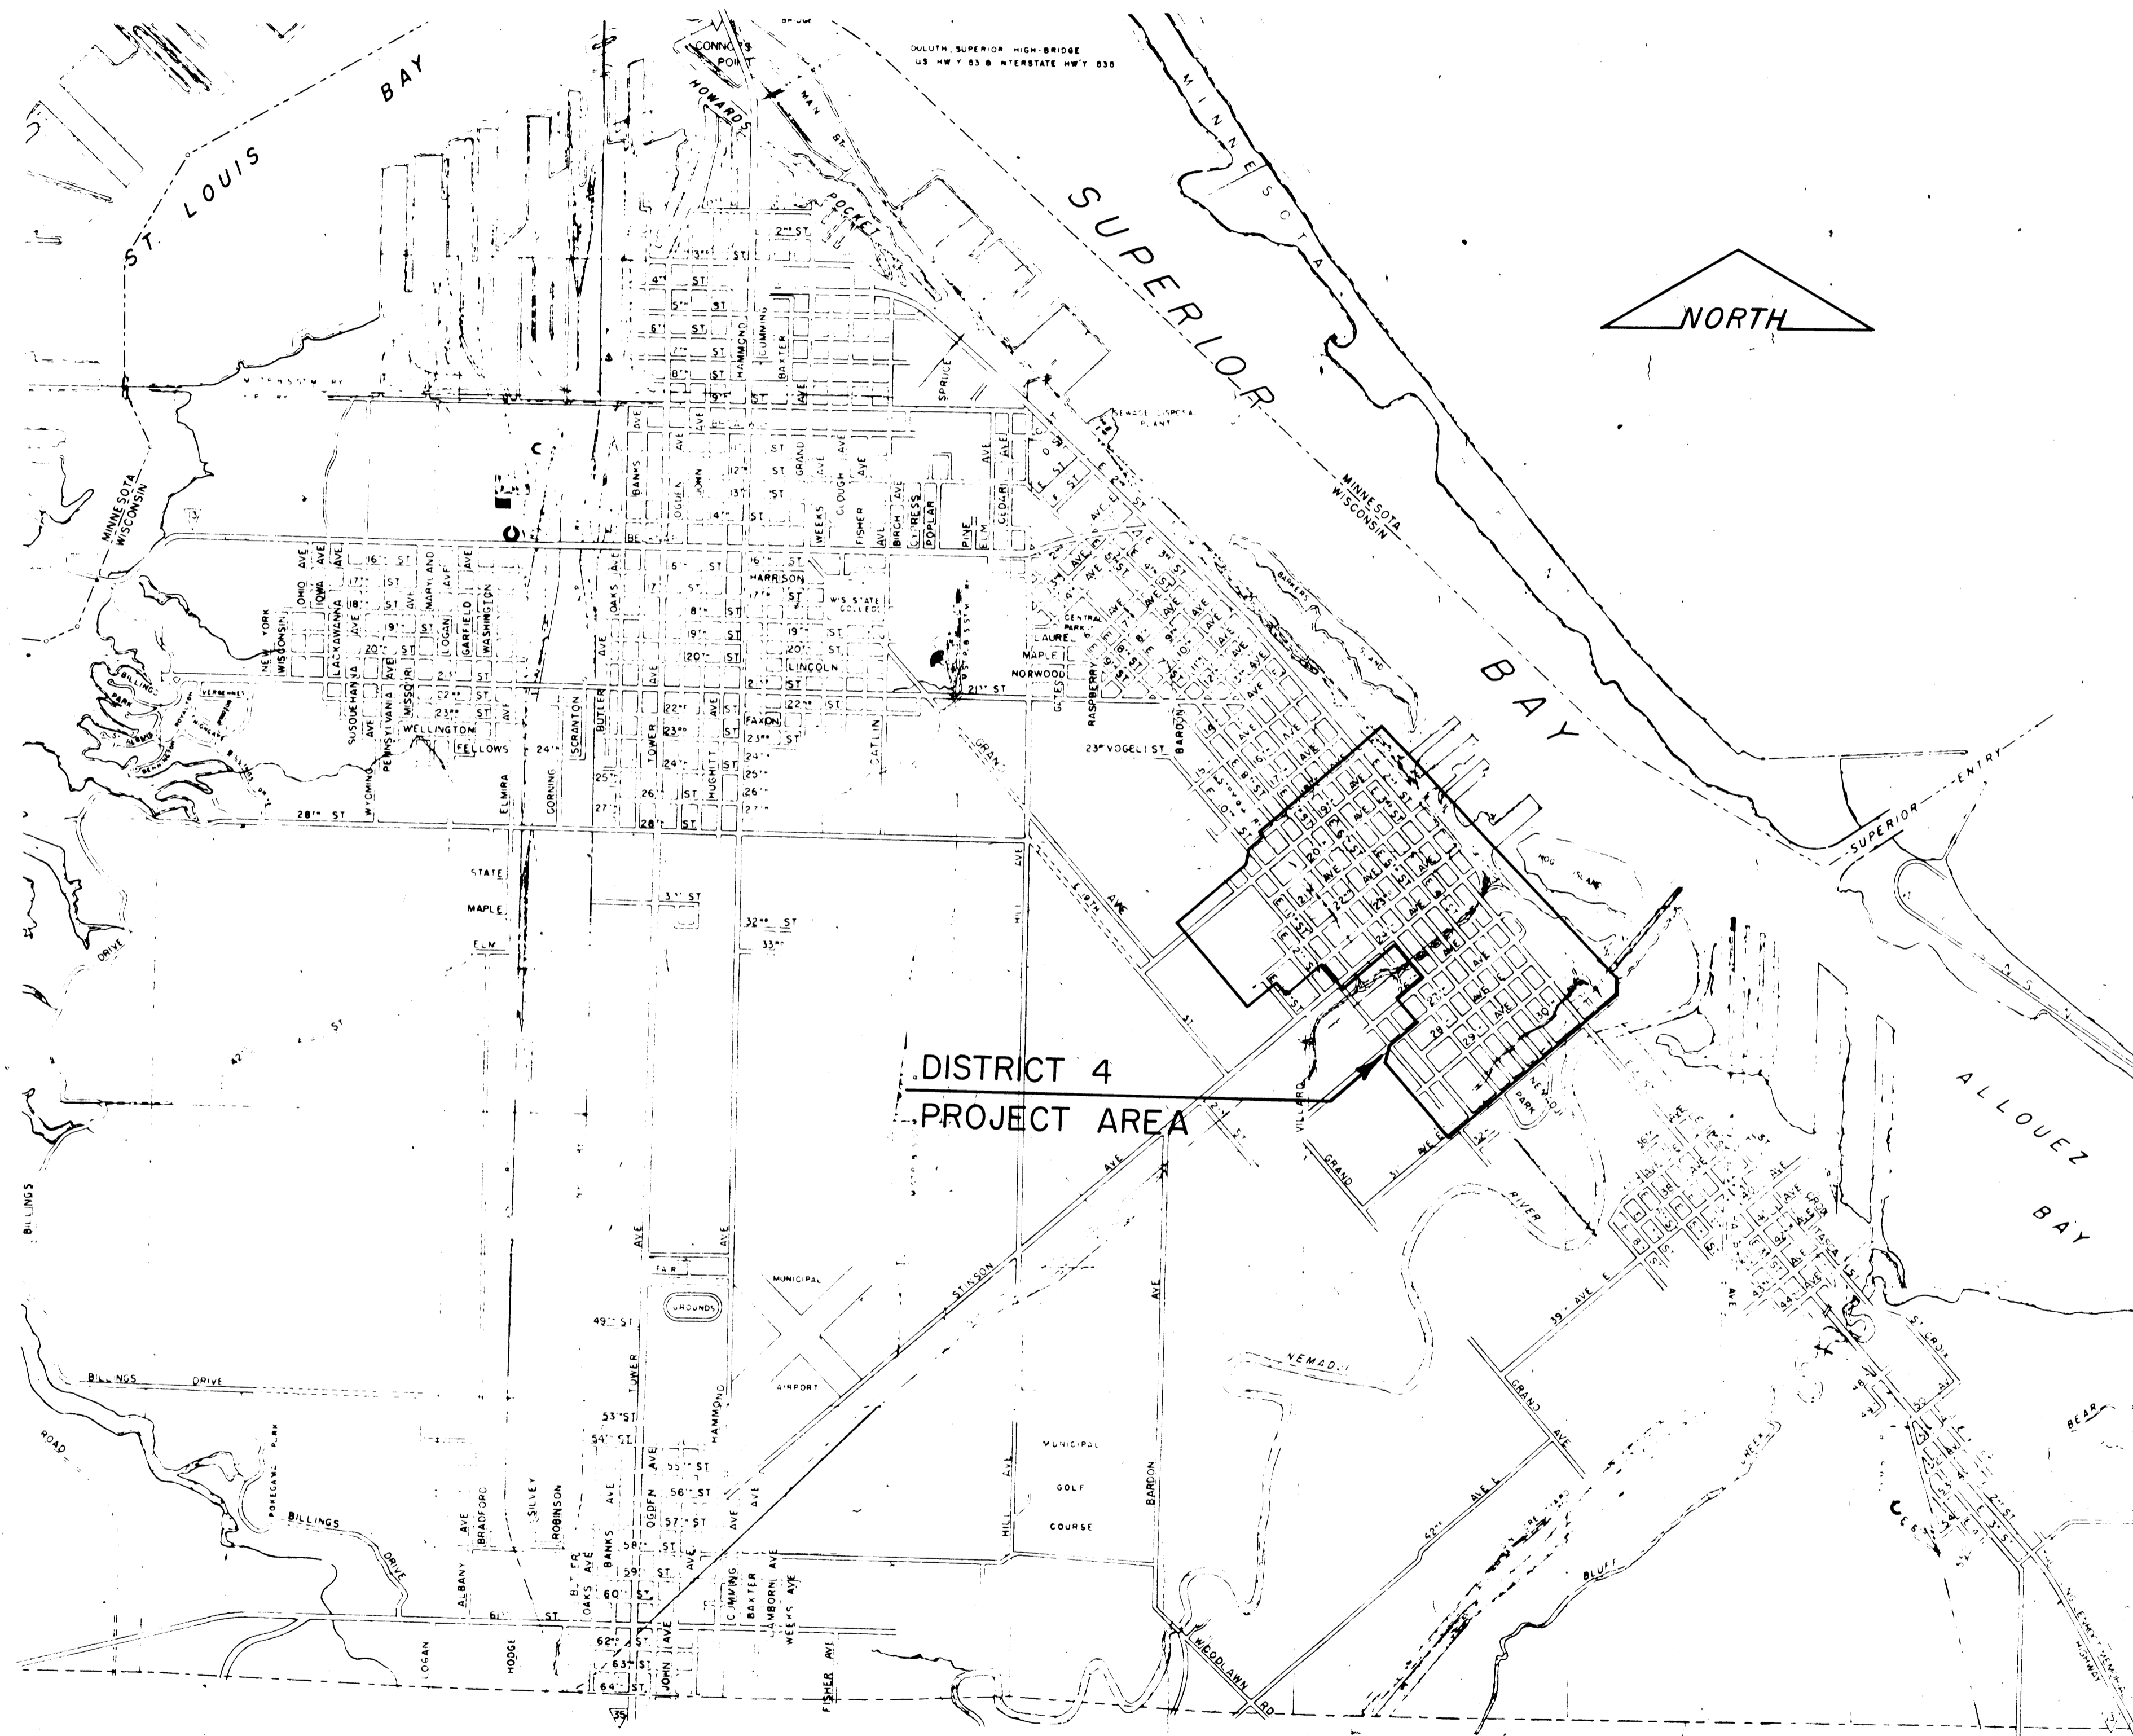

DISTRICT 4  
PROJECT AREA

LOCATION PLAN

Scale: 1"=2,000'

CITY COUNCIL

- CHARLES C. DENEWETH . . . . . MAYOR
- THOMAS P. STROOZAS, JR. . . . . COUNCILMAN
- ROBERT DUMONSAU . . . . . COUNCILMAN
- CARL DAHLIN . . . . . COUNCILMAN
- HERBERT C. WALLIN . . . . . COUNCILMAN
- LOWELL W. BANKS . . . . . COUNCILMAN
- PATRICIA PAQUETTE . . . . . COUNCILWOMAN
- THOMAS J. GODFREY . . . . . COUNCILMAN
- JAMES McHUGH . . . . . COUNCILMAN
- JAMES E. JOHNSON . . . . . COUNCILMAN
- KITCHENER THOMPSON . . . . . COUNCILMAN
- WILLIAM A. HAMMANN . . . . . CITY ATTORNEY
- FRED M. SEGUIN . . . . . PUBLIC WORKS DIRECTOR
- GEORGE HOWELL . . . . . CITY PLANNER

Storm Sewer  
Separation - District 4  
East End  
1974

<small>HEREBY CERTIFY THAT THIS PLAN WAS PREPARED BY ME OR UNDER MY CLOSE PERSONAL SUPERVISION AND THAT I AM A LICENSED PROFESSIONAL ENGINEER UNDER THE LAWS OF THE STATE OF WISCONSIN.</small> <small>DATE: AUG 26, 1974 REG. NO. E06599</small>		SURVEY: D.E. DRAWN: TGB DESIGN: GRC APPROVED: GRC	REVISIONS: RECORD PLANS 2/1/78 HBR	BONESTROO, ROSENE, ANDERLIK & ASSOC., INC. ST. PAUL, MINNESOTA	SUPERIOR, WISCONSIN DATE: AUG. 11, 1974 COMM. 6888 K	DISTRICT 4-EAST END STORM SEWER SEPARATION
--	--	--	--	---	--	---