
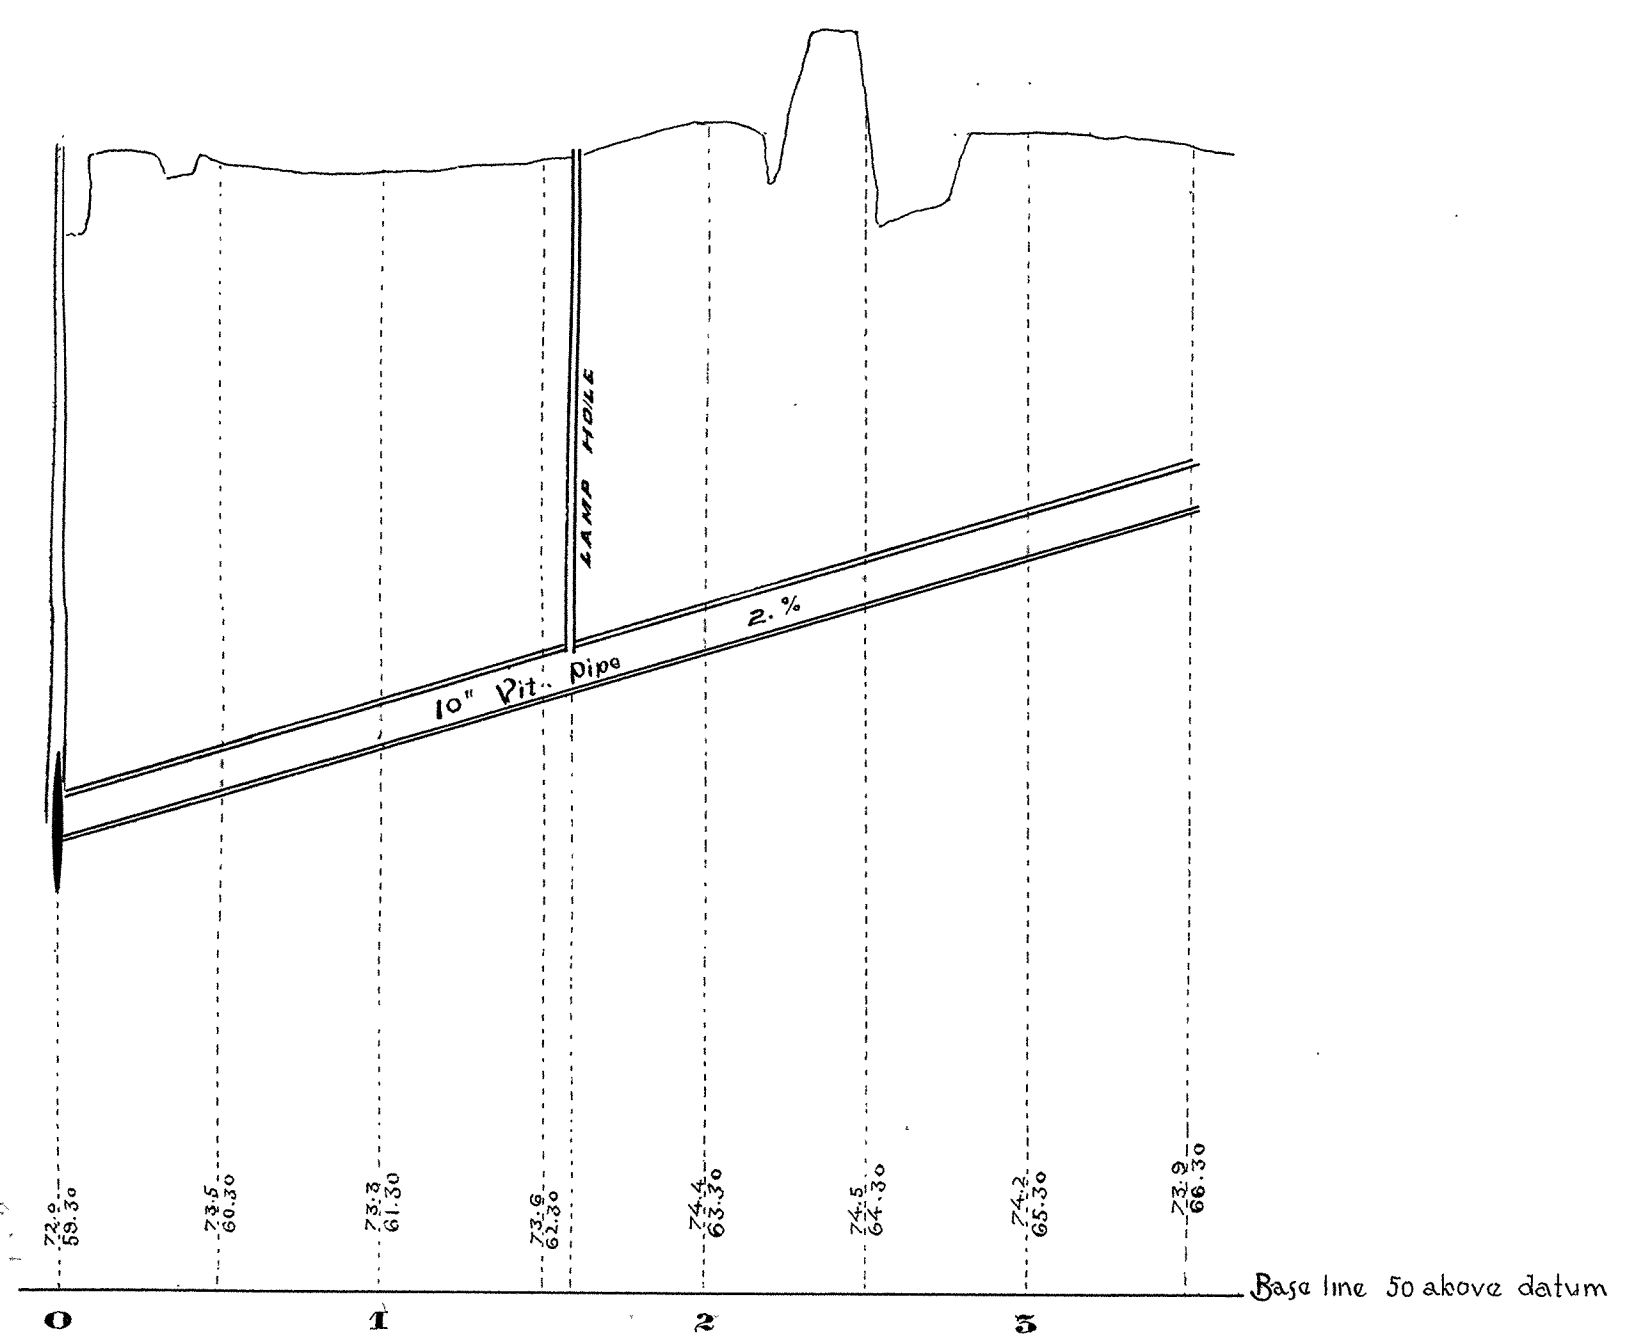


CITY OF SUPERIOR

SEWER PLAN

Contract let May 23, 1892
 Completed Nov 1, 1892
 Johnson & Dole, Contractor
 T. A. King, Inspector
 A. S. Cooper, City Engineer

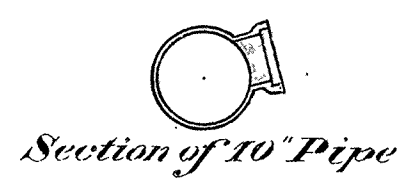

5-16