







1893

CITY OF SUPERIOR

SEWER PLAN

Contract let June 25, 1891
 completed July 1, 1892
 Kirkland & Starkey, Contractor
 Dailey & Grant, Inspectors
 E. B. Banks & A. S. Cooper, City Engrs.

Scale: { Horizontal 60 ft. = 1 inch
 Vertical 4 ft. = 1 inch
 Section 4 ft. = 1 inch
 2 ft. = 1 inch

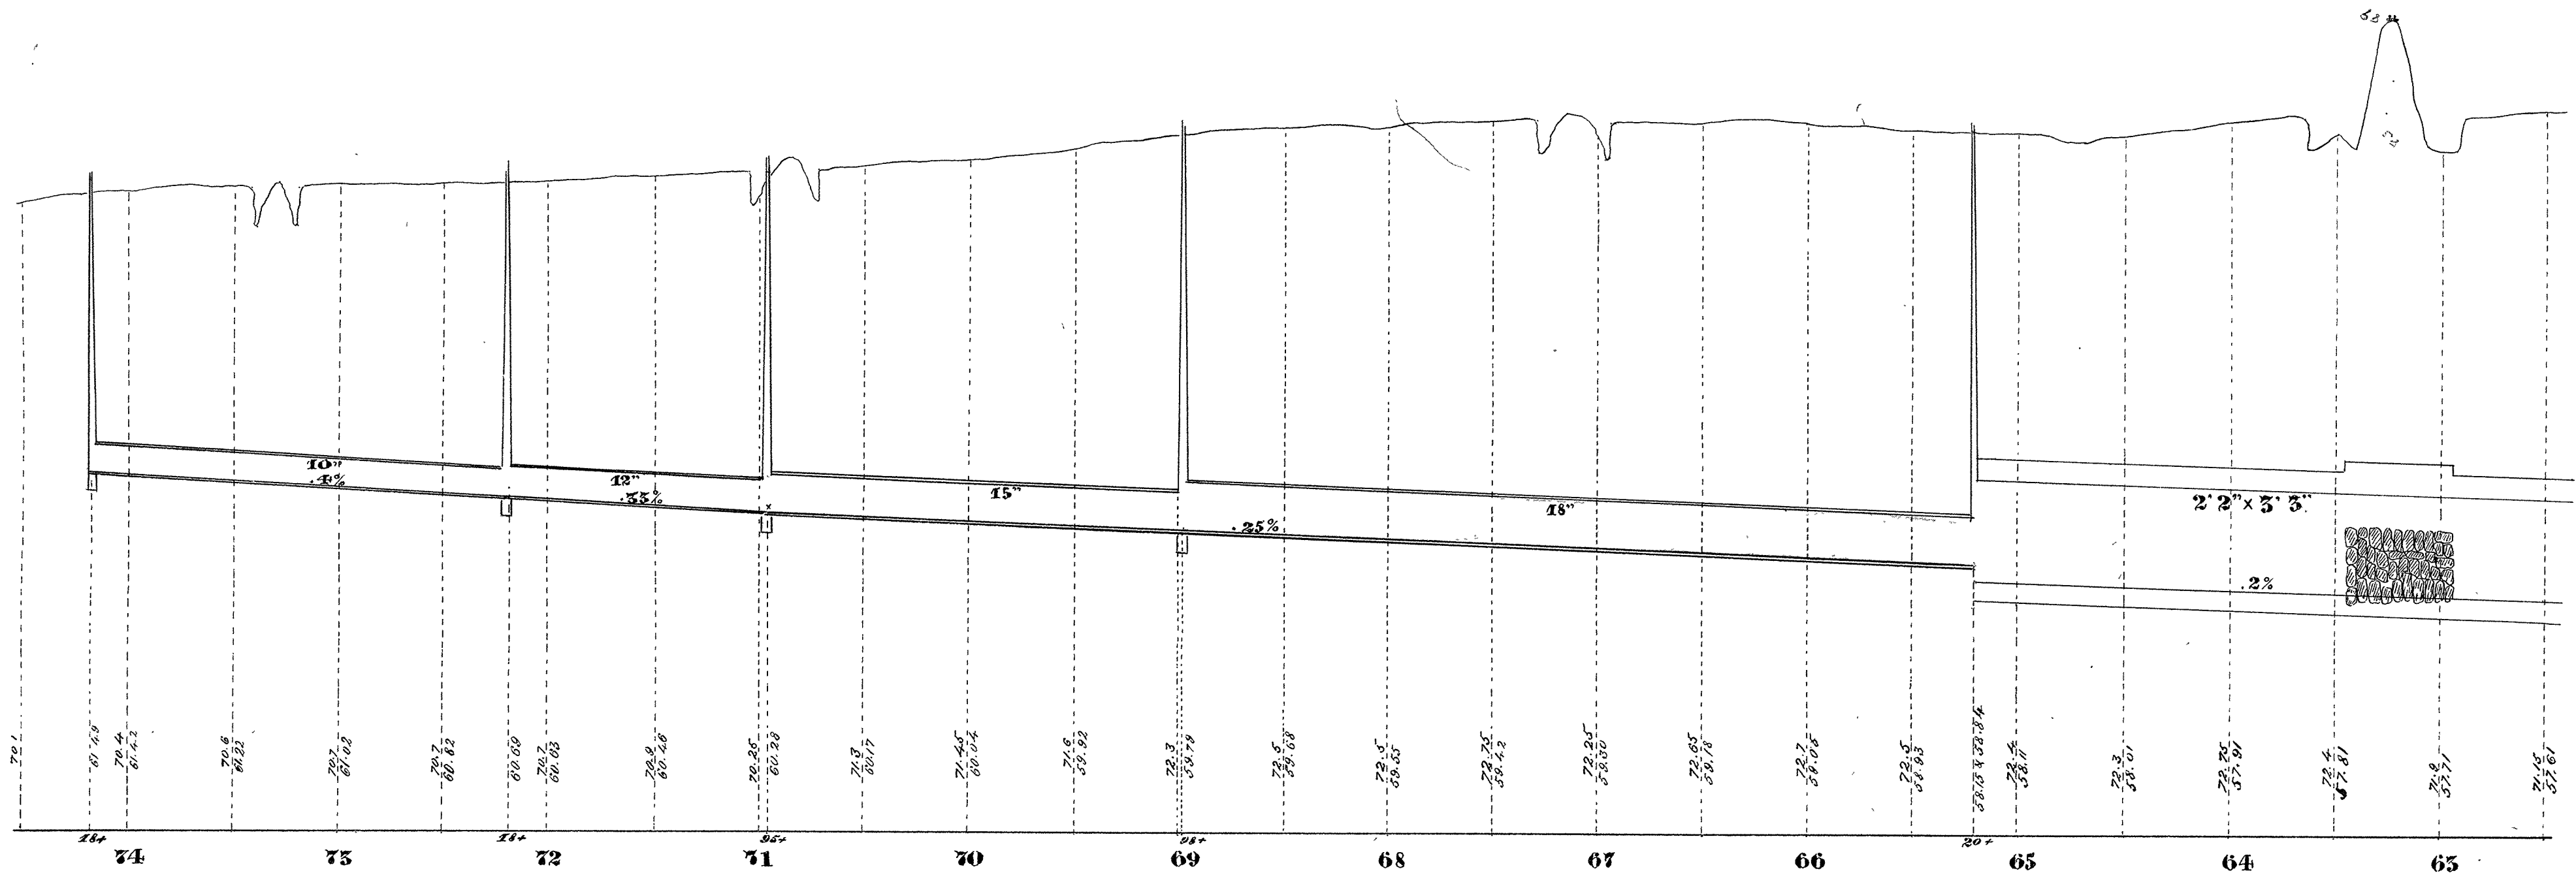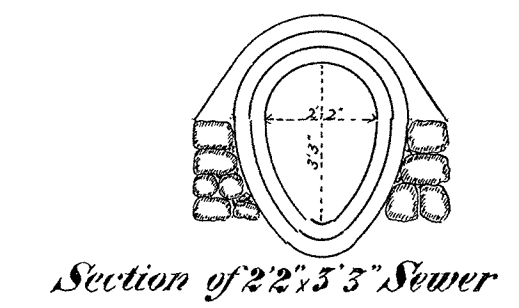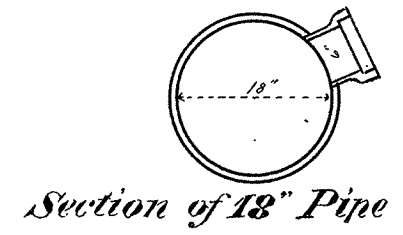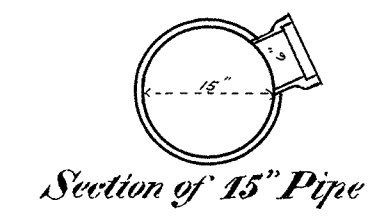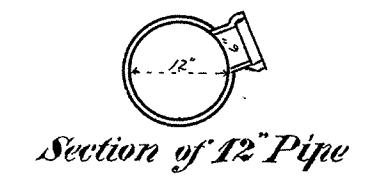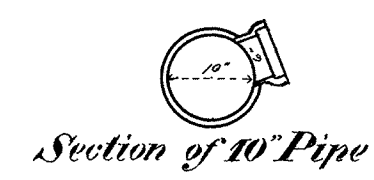

Plan & Profile of Sewer in Alley South of Central from Tower Ave. to Railway

5-19