

CENTRAL AVE.

JOHN AVE.





AVE.

OGDEN AVE.

1893

AVE.


SIXTYFOURTH ST.

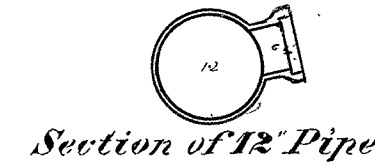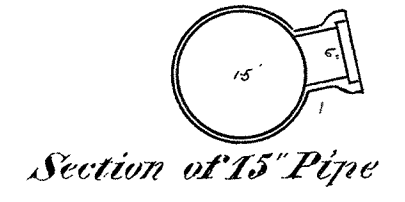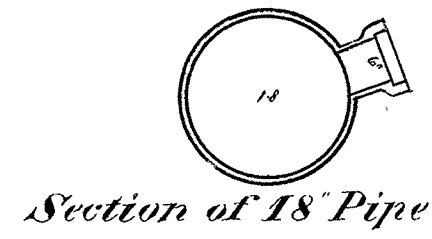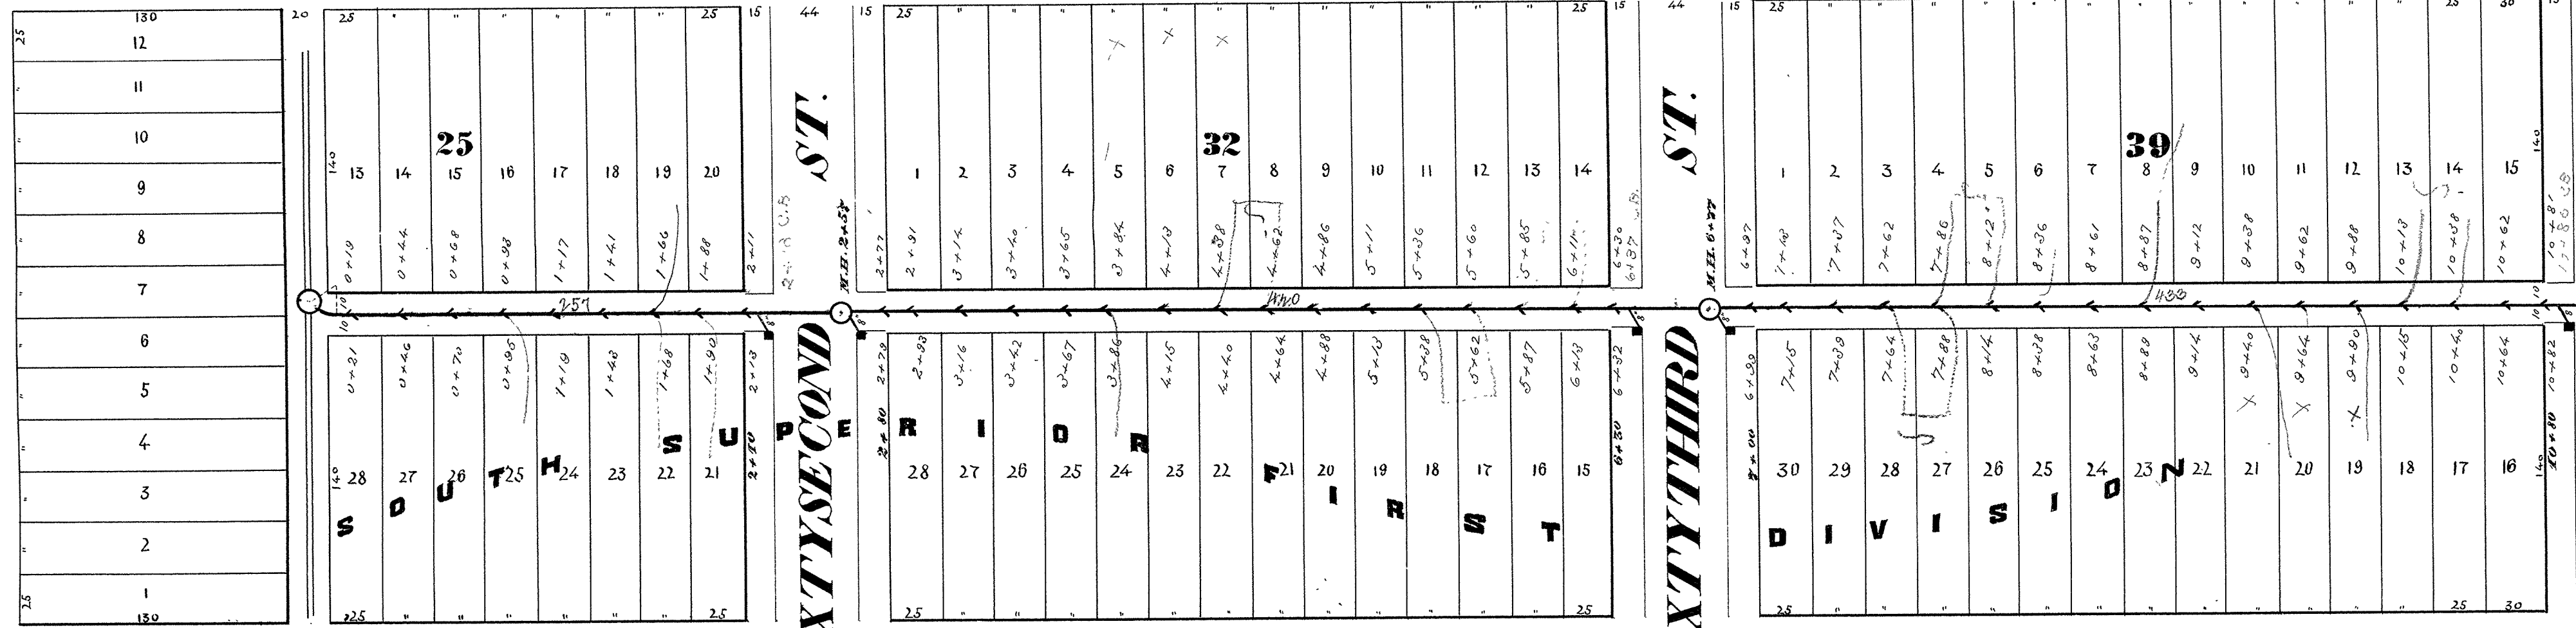

Scale: { Horizontal 60' = 1'
 Vertical 4' = 1'
 Section 2' = 1'

**CITY OF SUPERIOR
 SEWER PLAN**

Contract let April 20, 1893
 completed Aug. 18, 1893
 Monks Bros. Contractor
 James Dever, Inspector
 A. T. Thomas, City Engineer

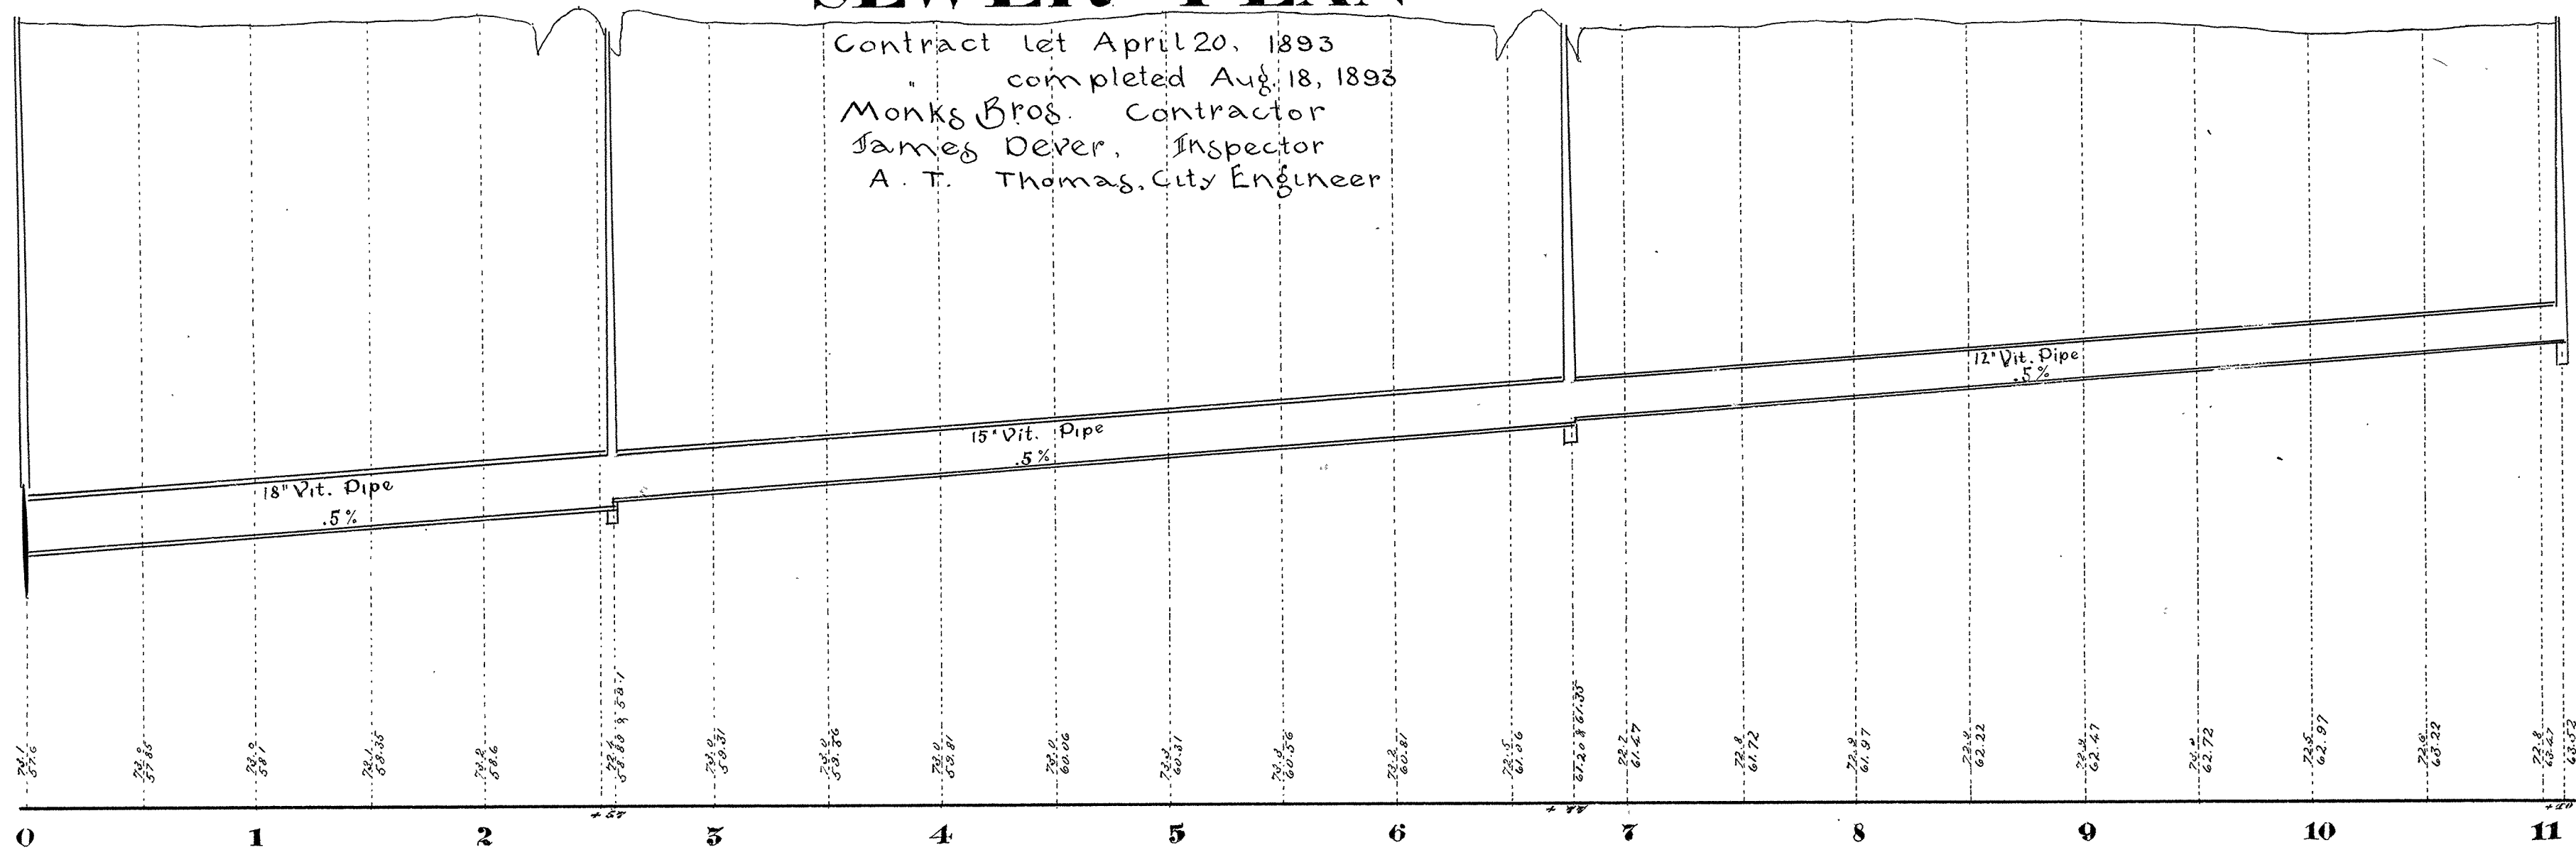

Profile & Plan of Sewer in Alley betw. John and Ogden Ave. from Central Ave. to Sixtyfourth St.

5-24